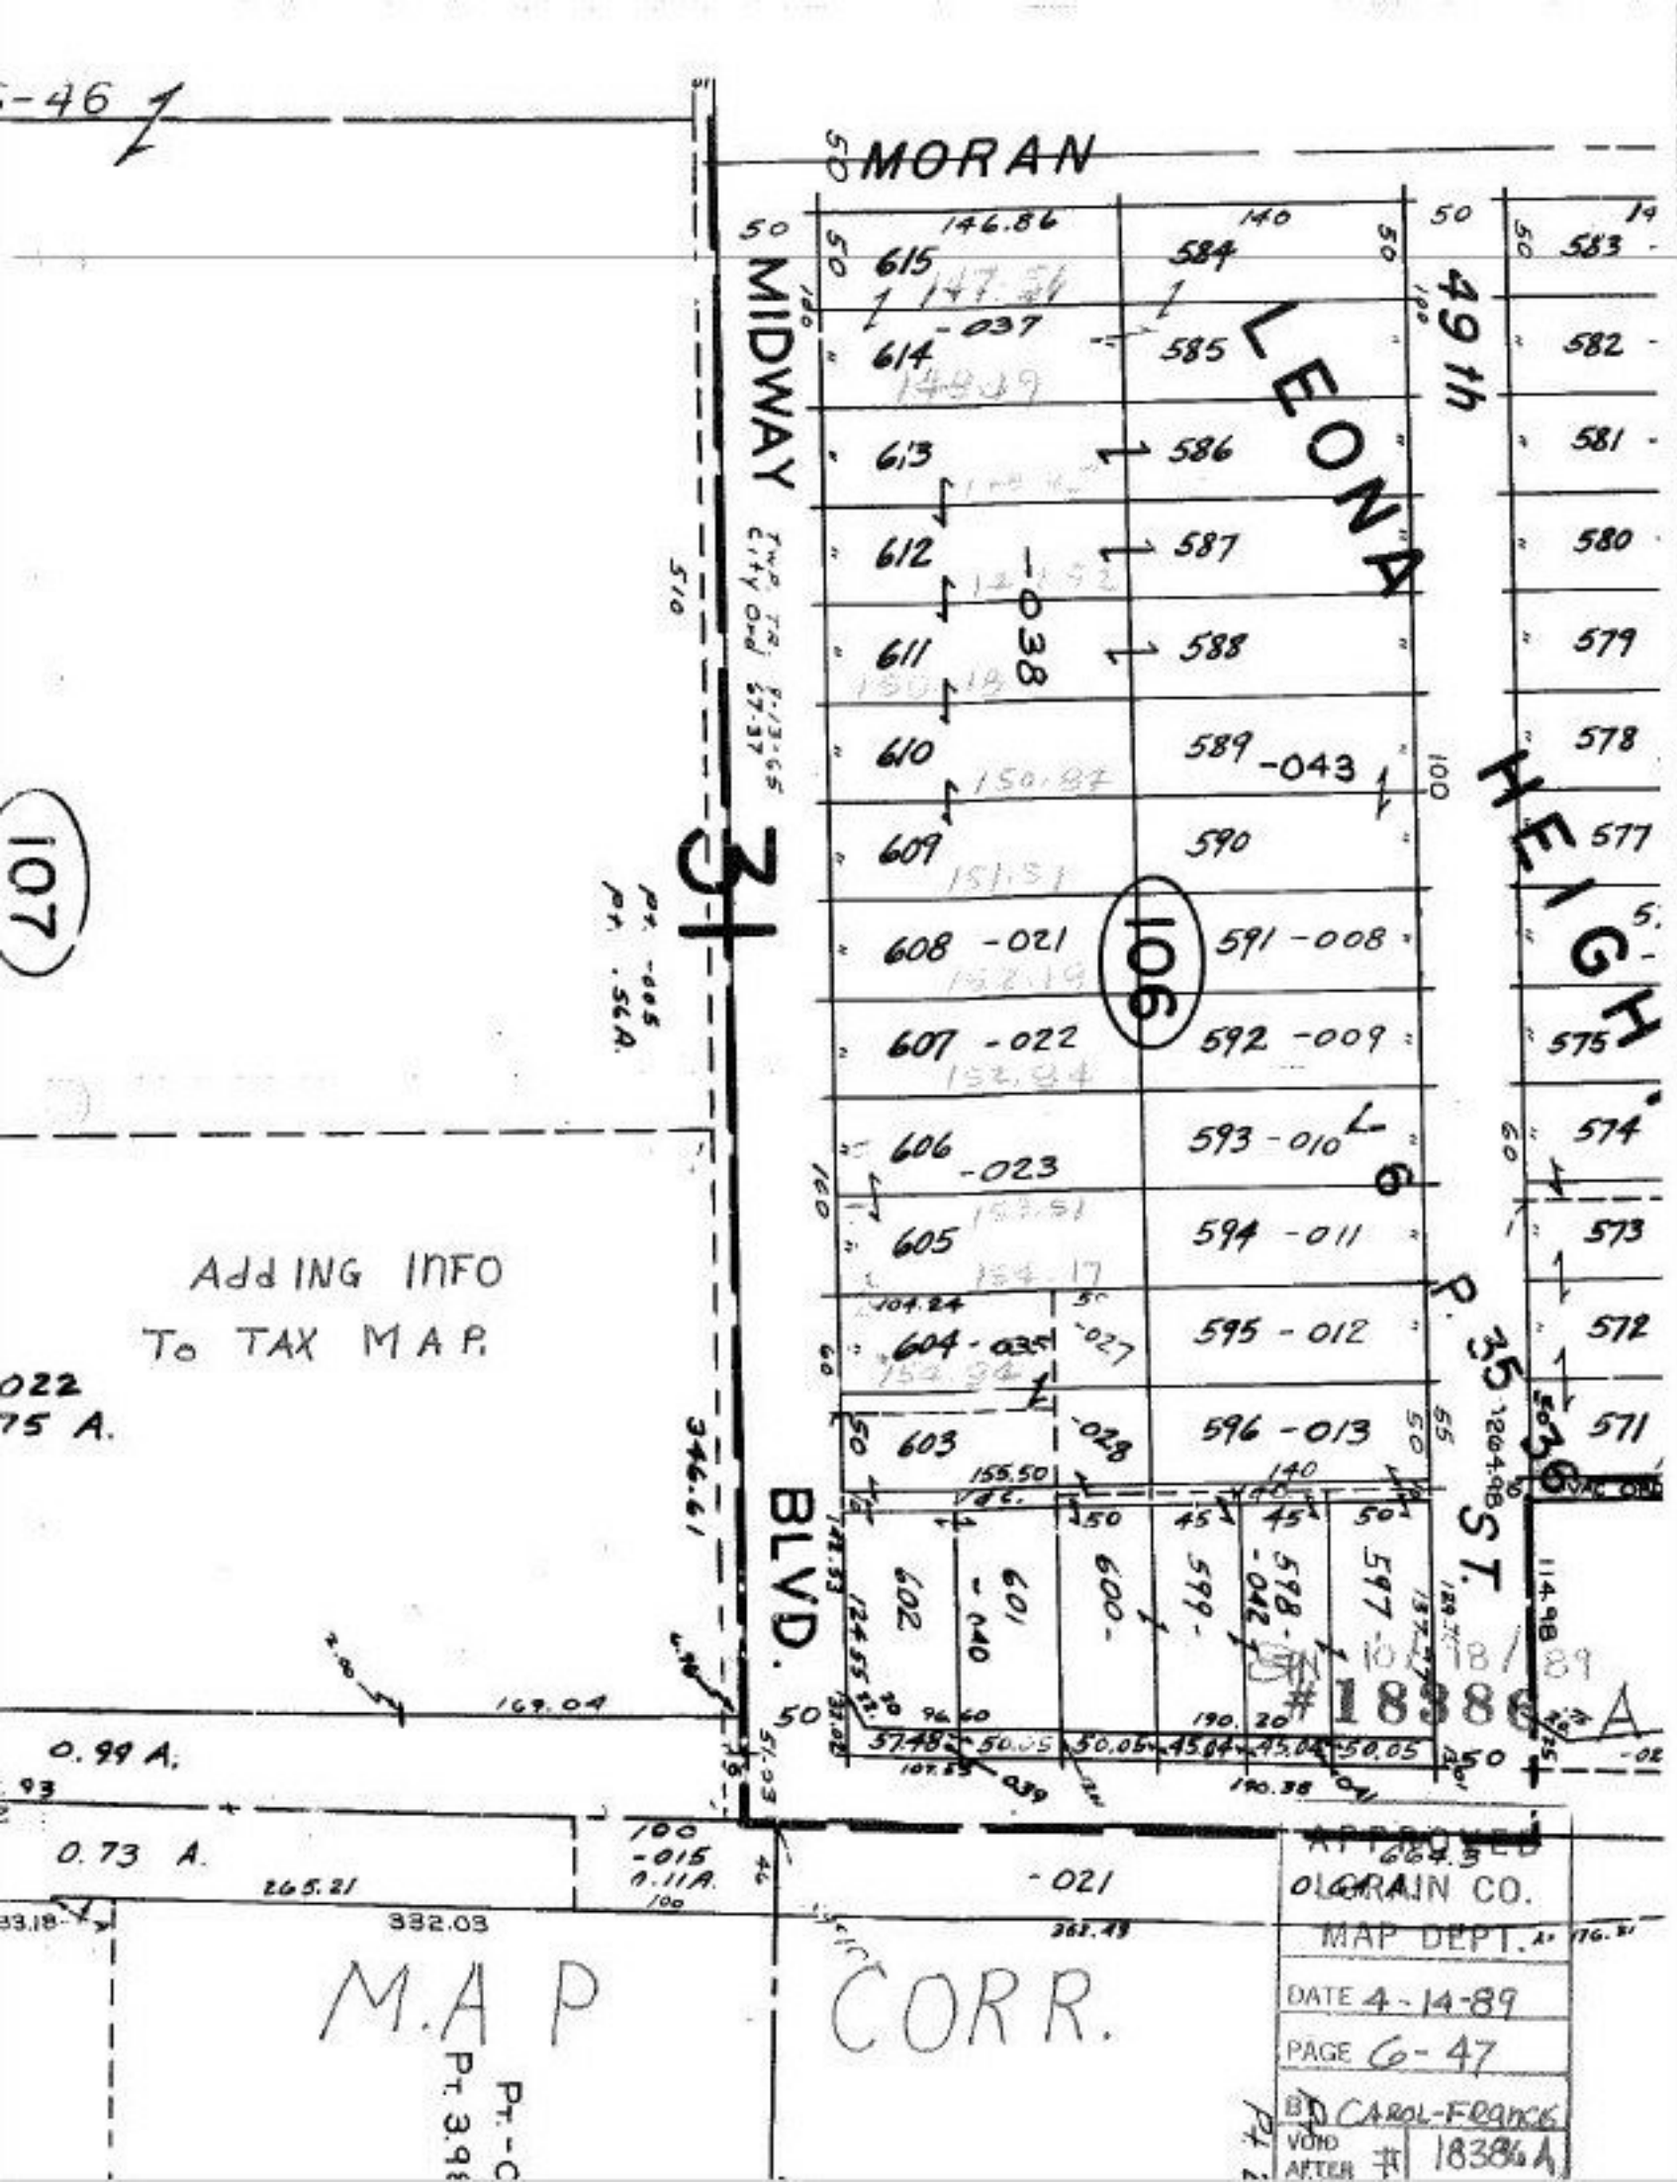

MORAN
MIDWAY
BLVD.
LEONA
HEIGH
49th
ST.
31
106
107
Adding INFO
To TAX MAP.
0.99 A.
0.73 A.
M.A.P
CORR.
APPROVED
LORAIN CO.
MAP DEPT.
DATE 4-14-89
PAGE 6-47
BY CAROL-FRANCE
VOID AFTER # 18386A
#18386 A