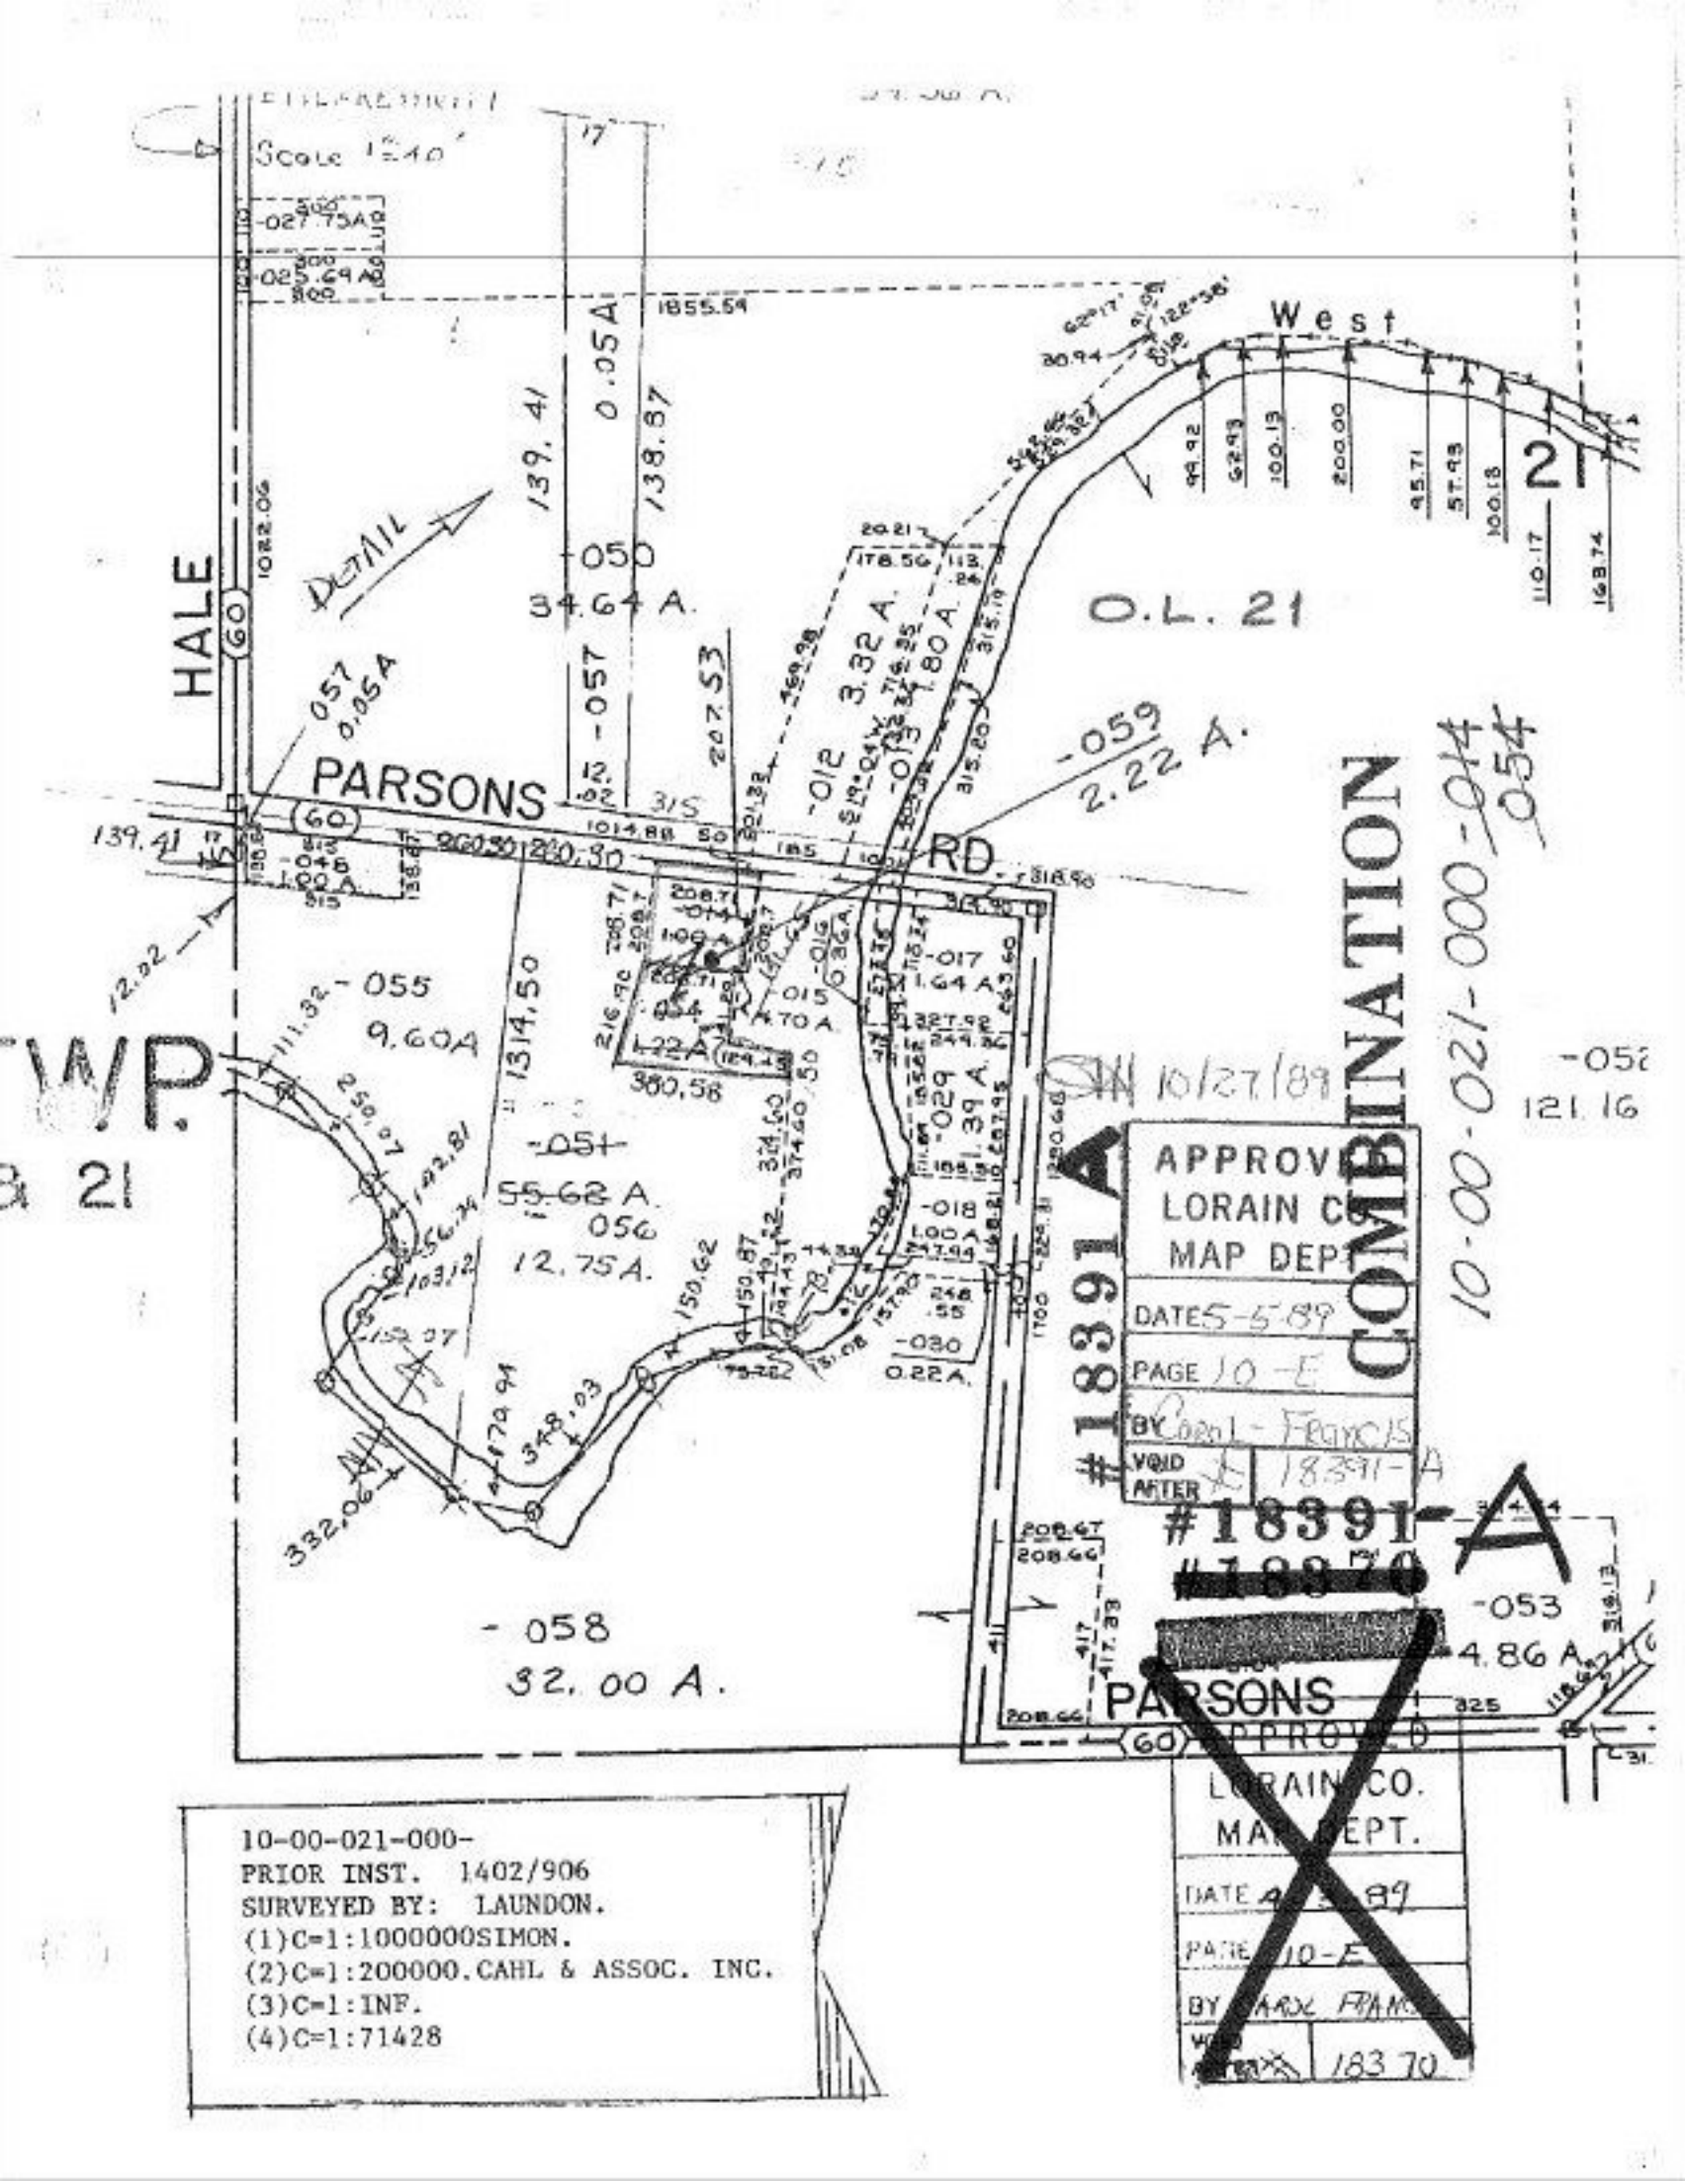
Scale 1"=40'
HALE
PARSONS
RD
West
O.L. 21
COMBINATION
10-00-021-000-014
054
-055
9.60A
-056
12.75A.
-057
0.05A
-058
32.00 A.
-059
2.22 A.
-053
4.86 A
-052
121.16
#18391-A
APPROVED
LORAIN CO.
MAP DEPT.
DATE 5-5-89
PAGE 10-E
BY Carol-Francis
VOID AFTER
#18391-A
10-00-021-000-
PRIOR INST. 1402/906
SURVEYED BY: LAUNDON.
(1)C=1:1000000SIMON.
(2)C=1:200000.CAHL & ASSOC. INC.
(3)C=1:INF.
(4)C=1:71428