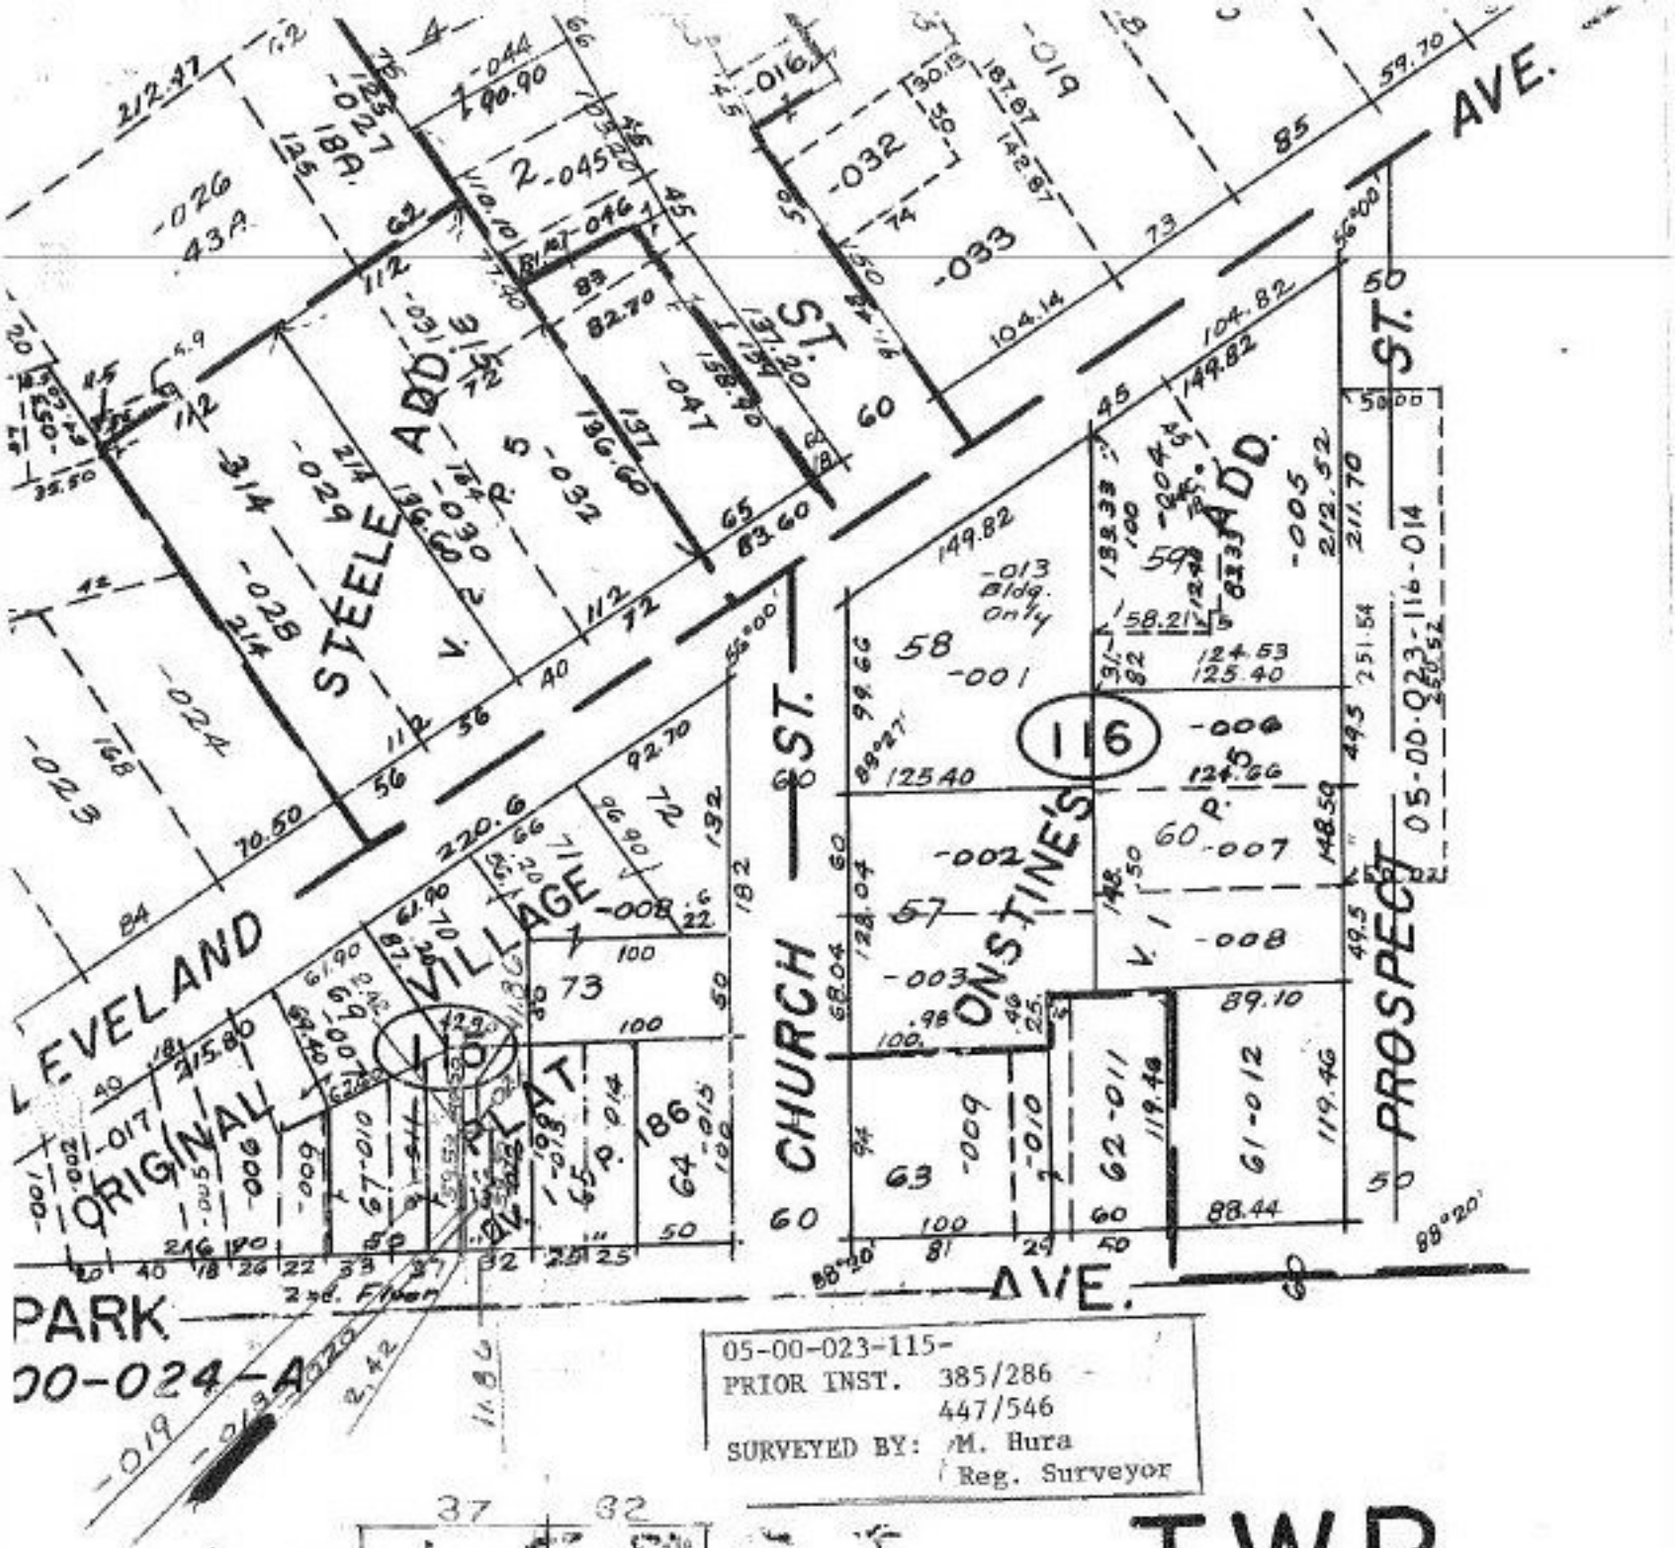

05-00-023-115-
PRIOR INST. 385/286
447/546
SURVEYED BY: M. Hura
Reg. Surveyor

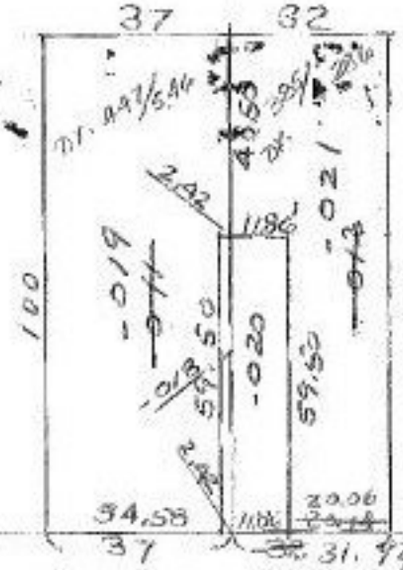

SCALE 1" = 40'

TWP

10/12/89

#18399

APPROVED
LORAIN CO.
MAP DEPT.

DATE 4-26-89

PAGE 5-00-023 A

BY Carol-Francis

VOID AFTER # 18399