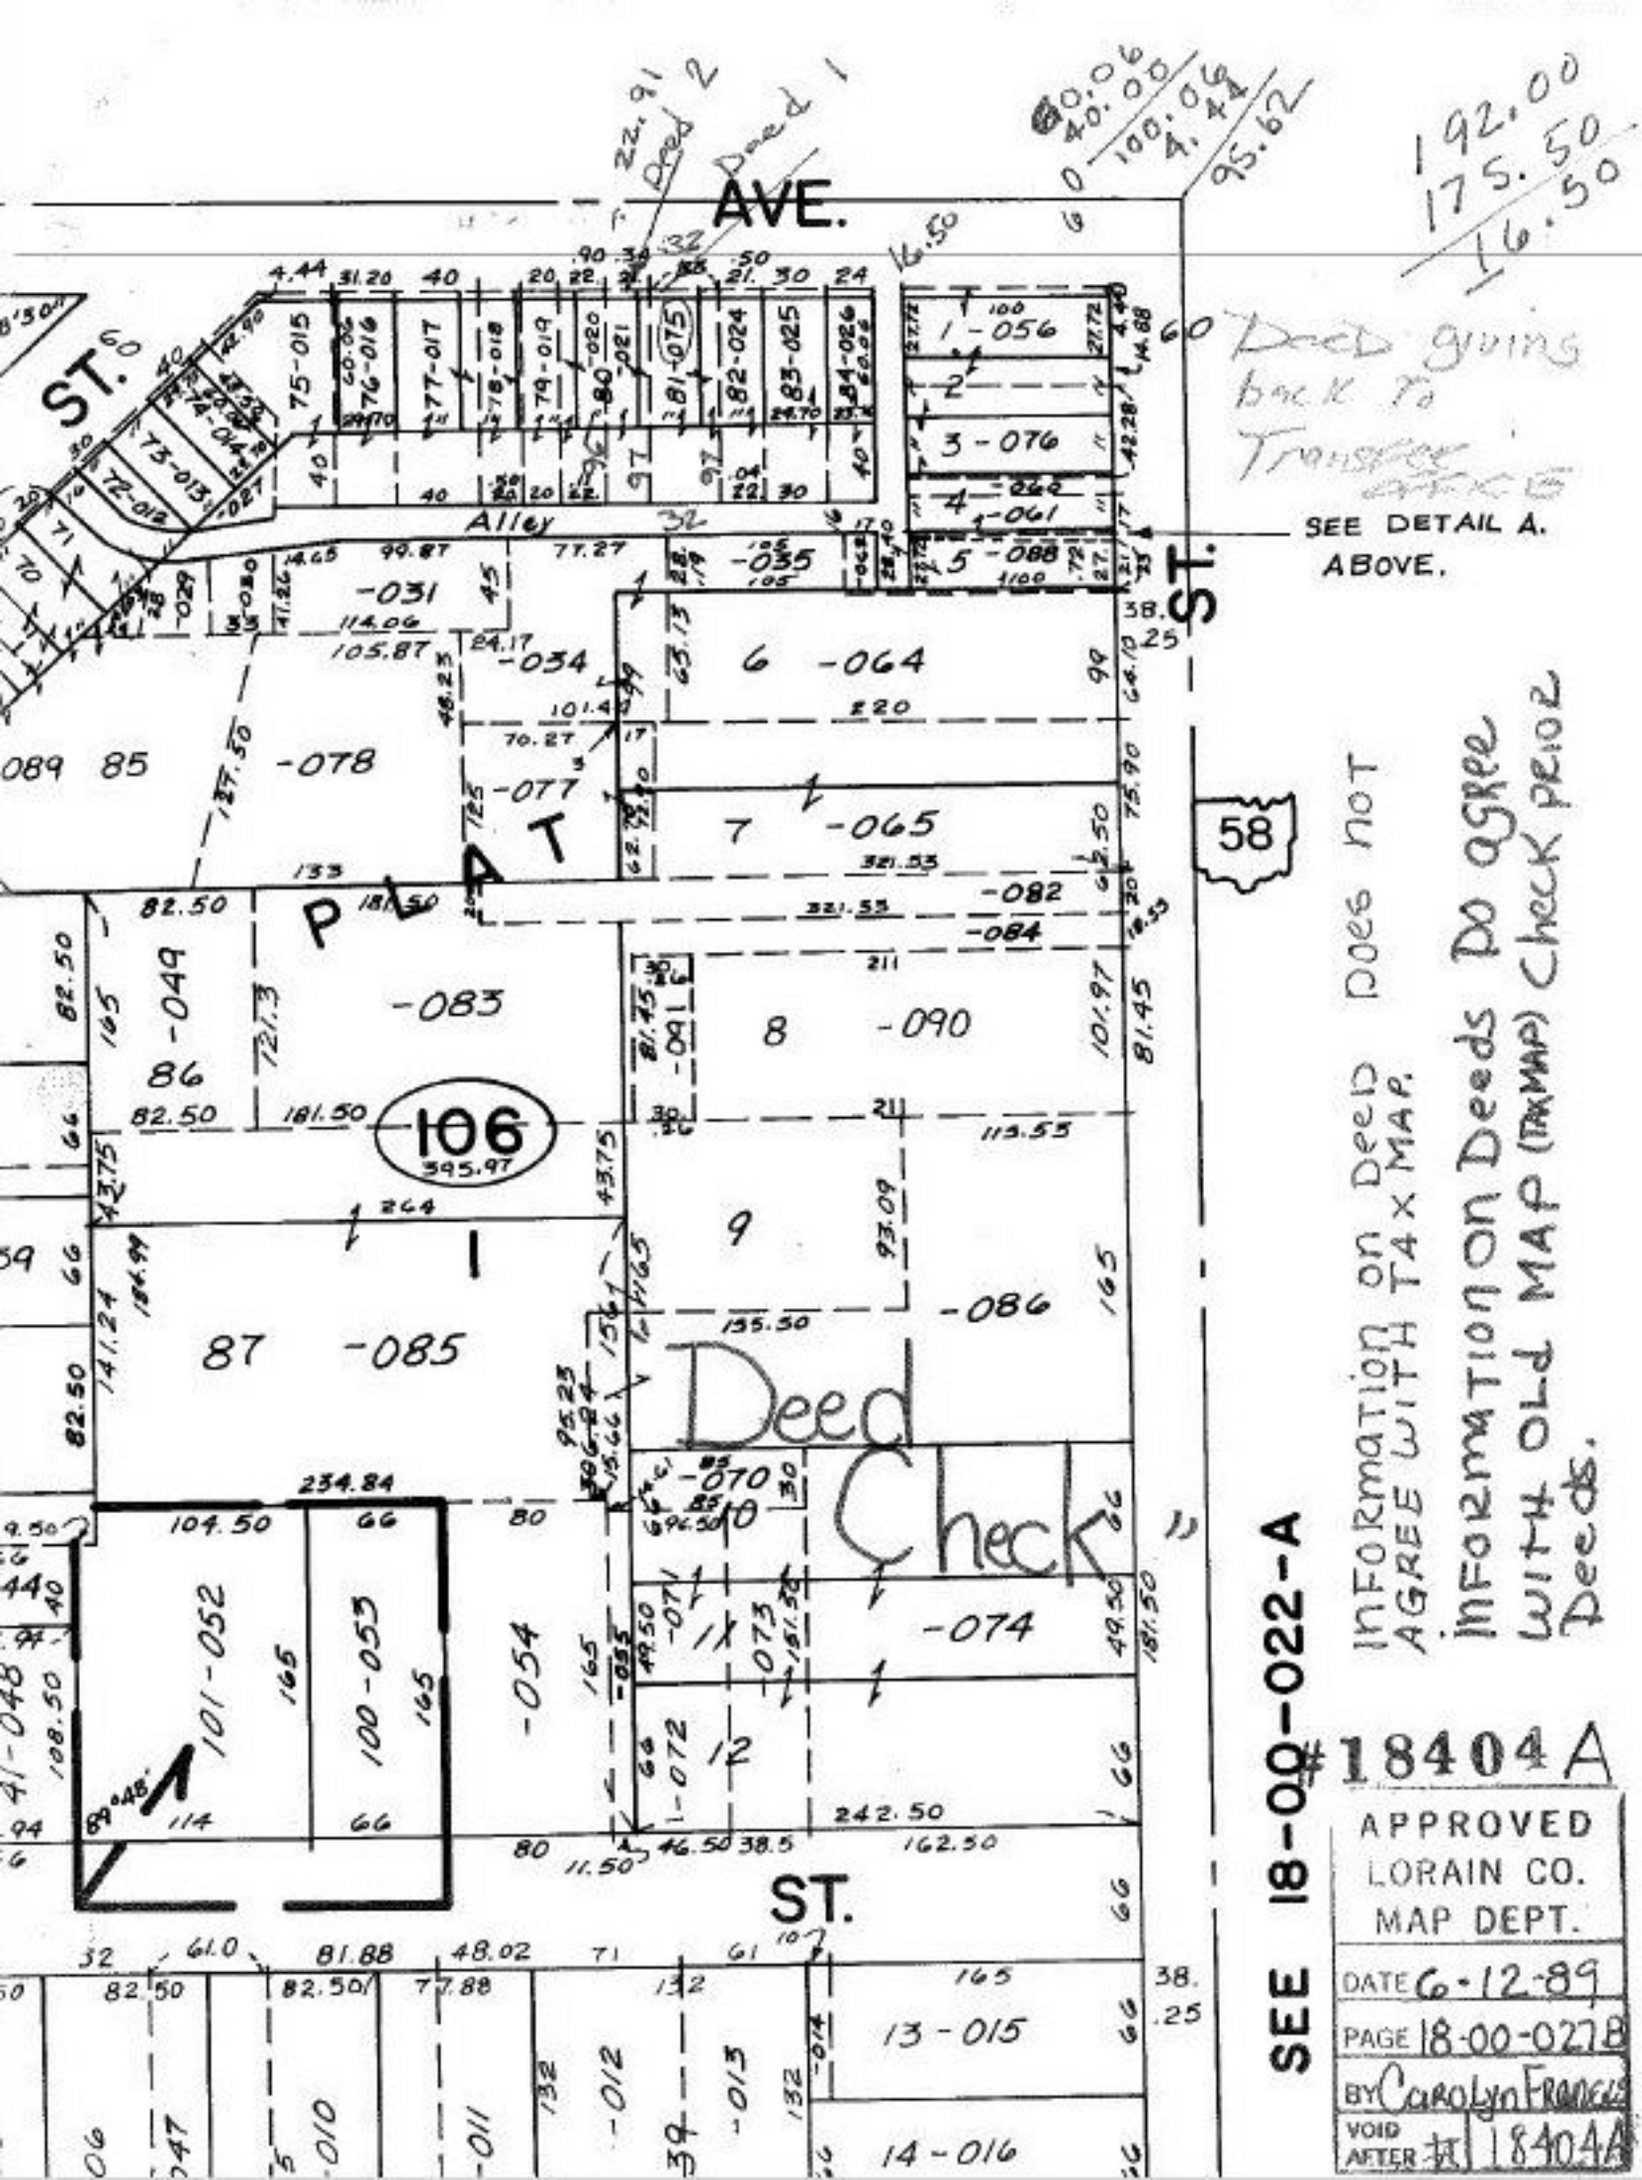
AVE.
ST.
Alley
PLAT
106
58
Deed Check
SEE DETAIL A. ABOVE.
SEE 18-00-022-A
Deed giving back to Transfer office
192.00
175.50
16.50
Information on Deed Does not AGREE WITH TAX MAP.
Information on Deeds Do agree with Old MAP (TAX MAP) Check prior Deeds.
#18404A
APPROVED
LORAIN CO.
MAP DEPT.
DATE 6-12-89
PAGE 18-00-027B
BY Carolyn Francis
VOID AFTER # 18404A