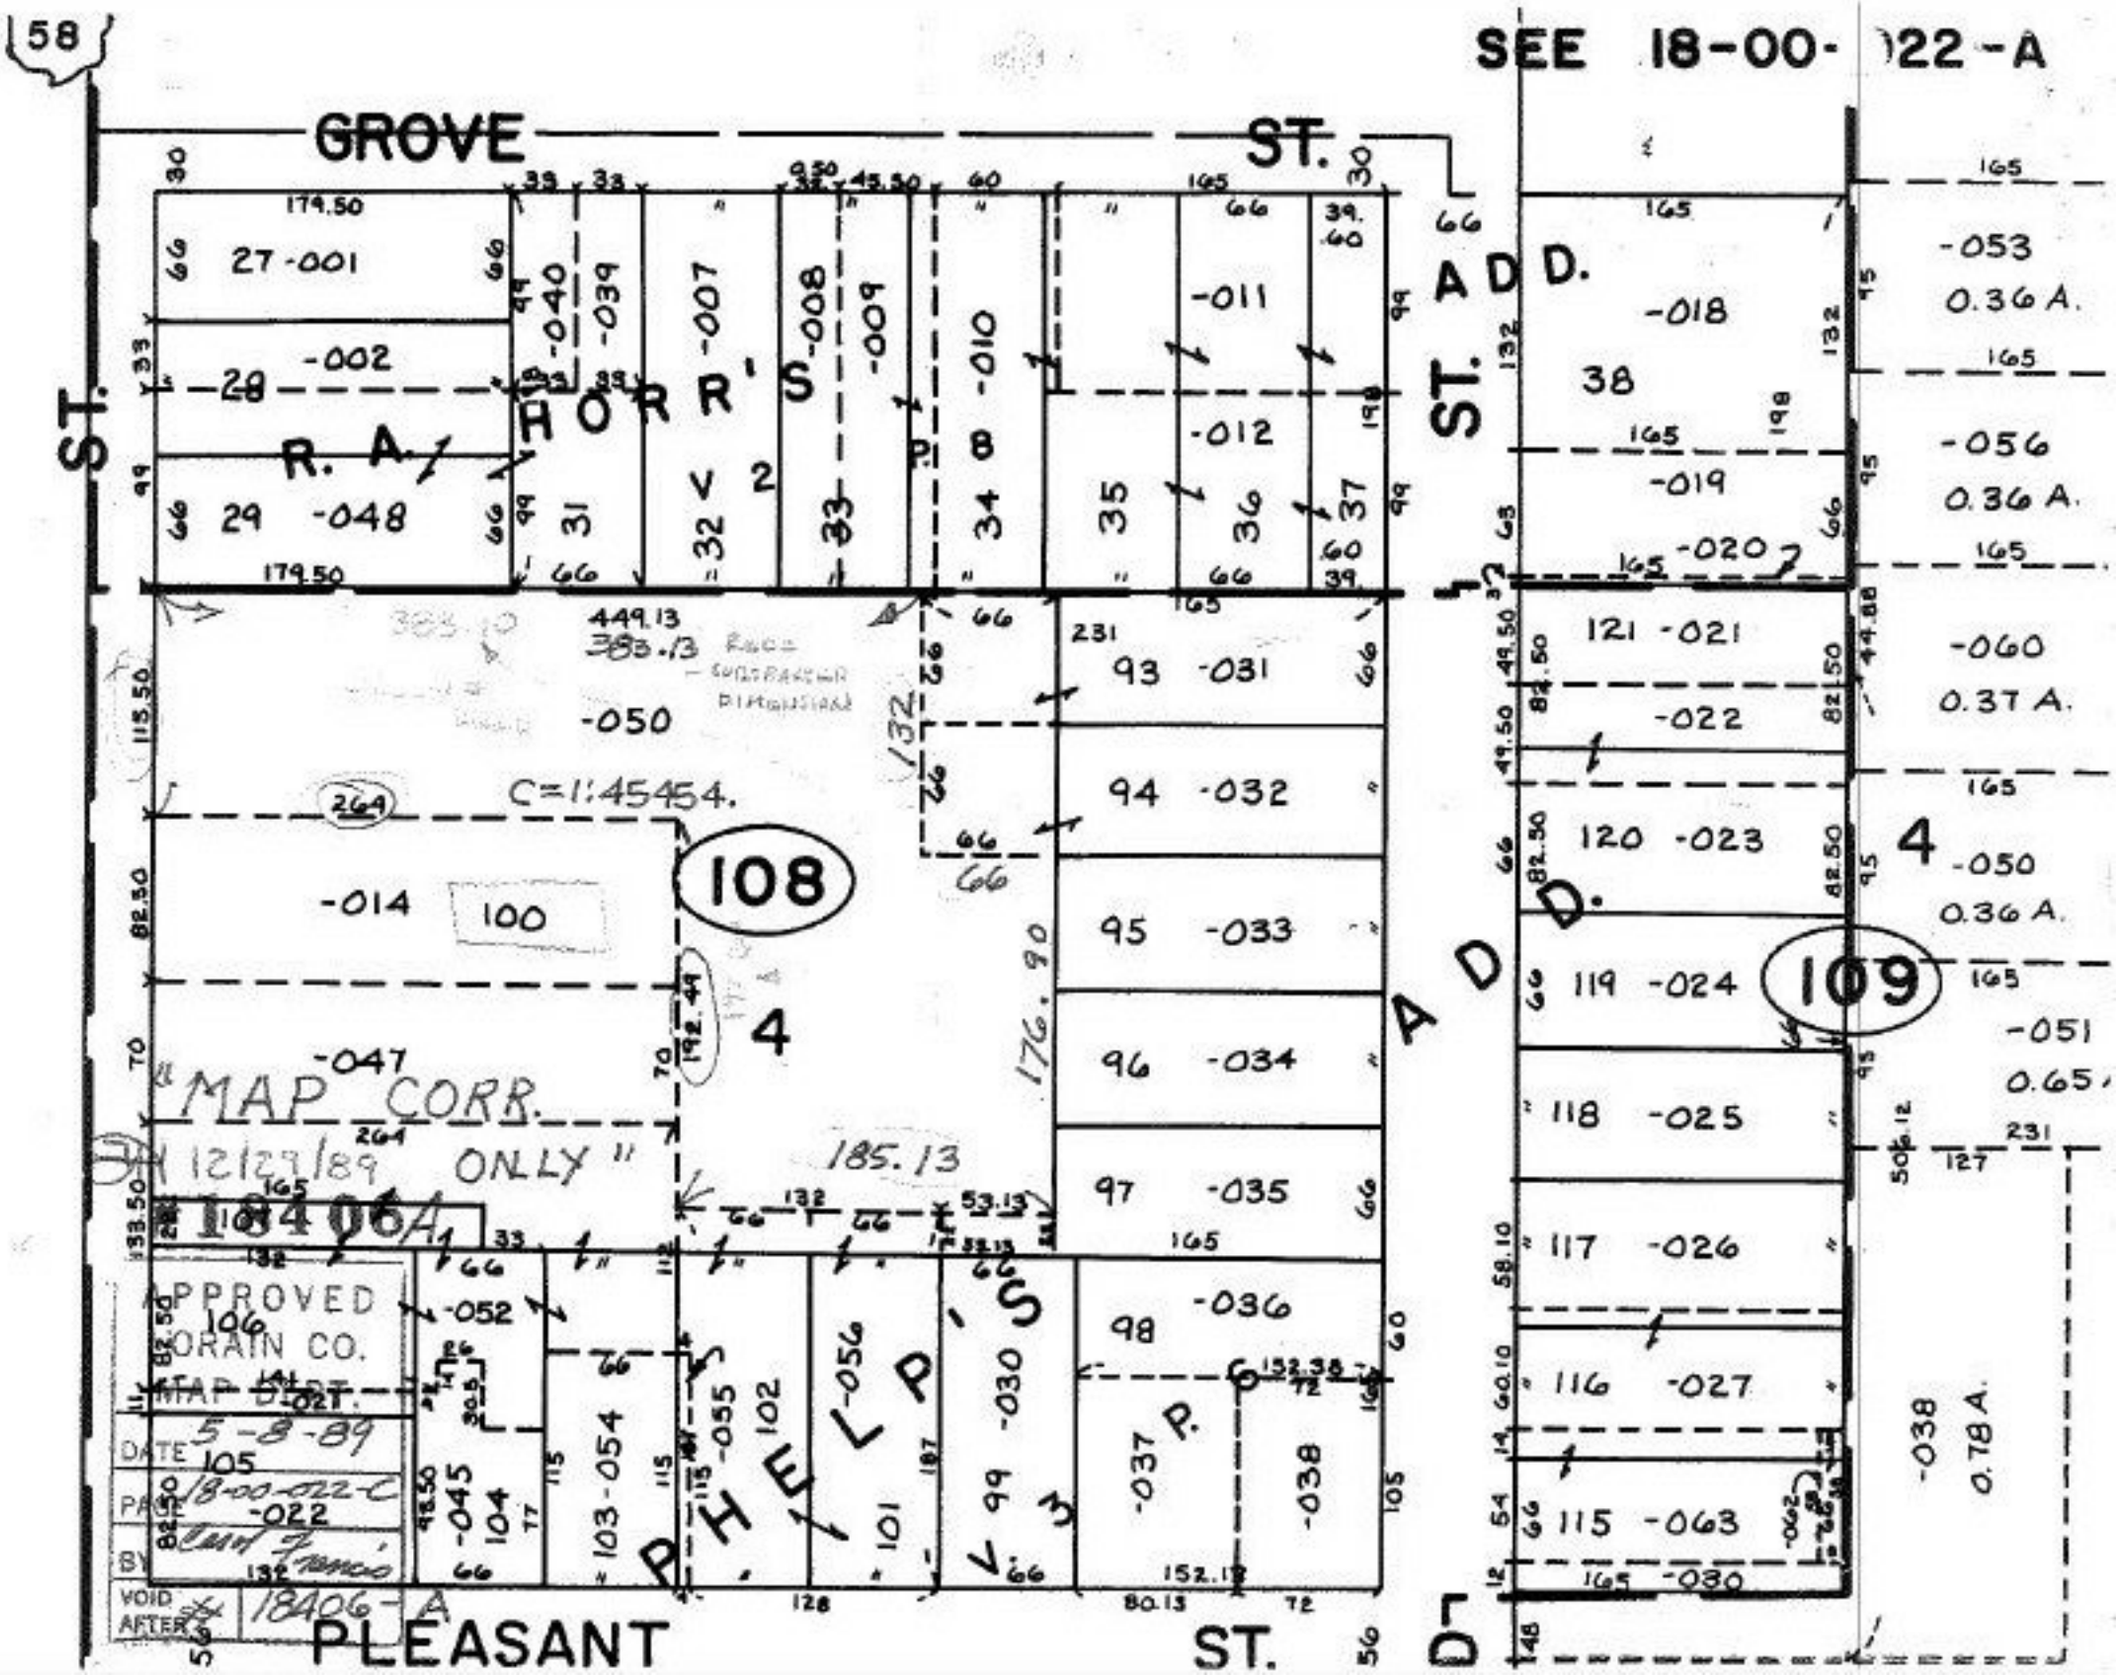
58
SEE 18-00-022-A
GROVE ST.
PLEASANT ST.
ST.
R. A. HORR'S
V 2
P. 8
ADD.
PHELP'S
V. 3
P. 6
ADD.
108
109
4
27-001
28 -002
29 -048
-040
-039
-007
-008
-009
-010
-011
-012
31
32
33
34
35
36
37
-050
-014
100
-047
93 -031
94 -032
95 -033
96 -034
97 -035
98 -036
-052
106
-045
104
103-054
-055
102
-056
101
99 -030
-037
-038
-018
38
-019
-020
121 -021
-022
120 -023
119 -024
118 -025
117 -026
116 -027
115 -063
-030
-053
0.36 A.
-056
0.36 A.
-060
0.37 A.
-050
0.36 A.
-051
0.65
-038
0.78 A.
C=1:45454.
"MAP CORR. ONLY"
12/29/89
18406A
APPROVED
LORAIN CO.
MAP DEPT.
DATE 5-8-89
PAGE 18-00-022-C
BY
VOID AFTER 18406-A