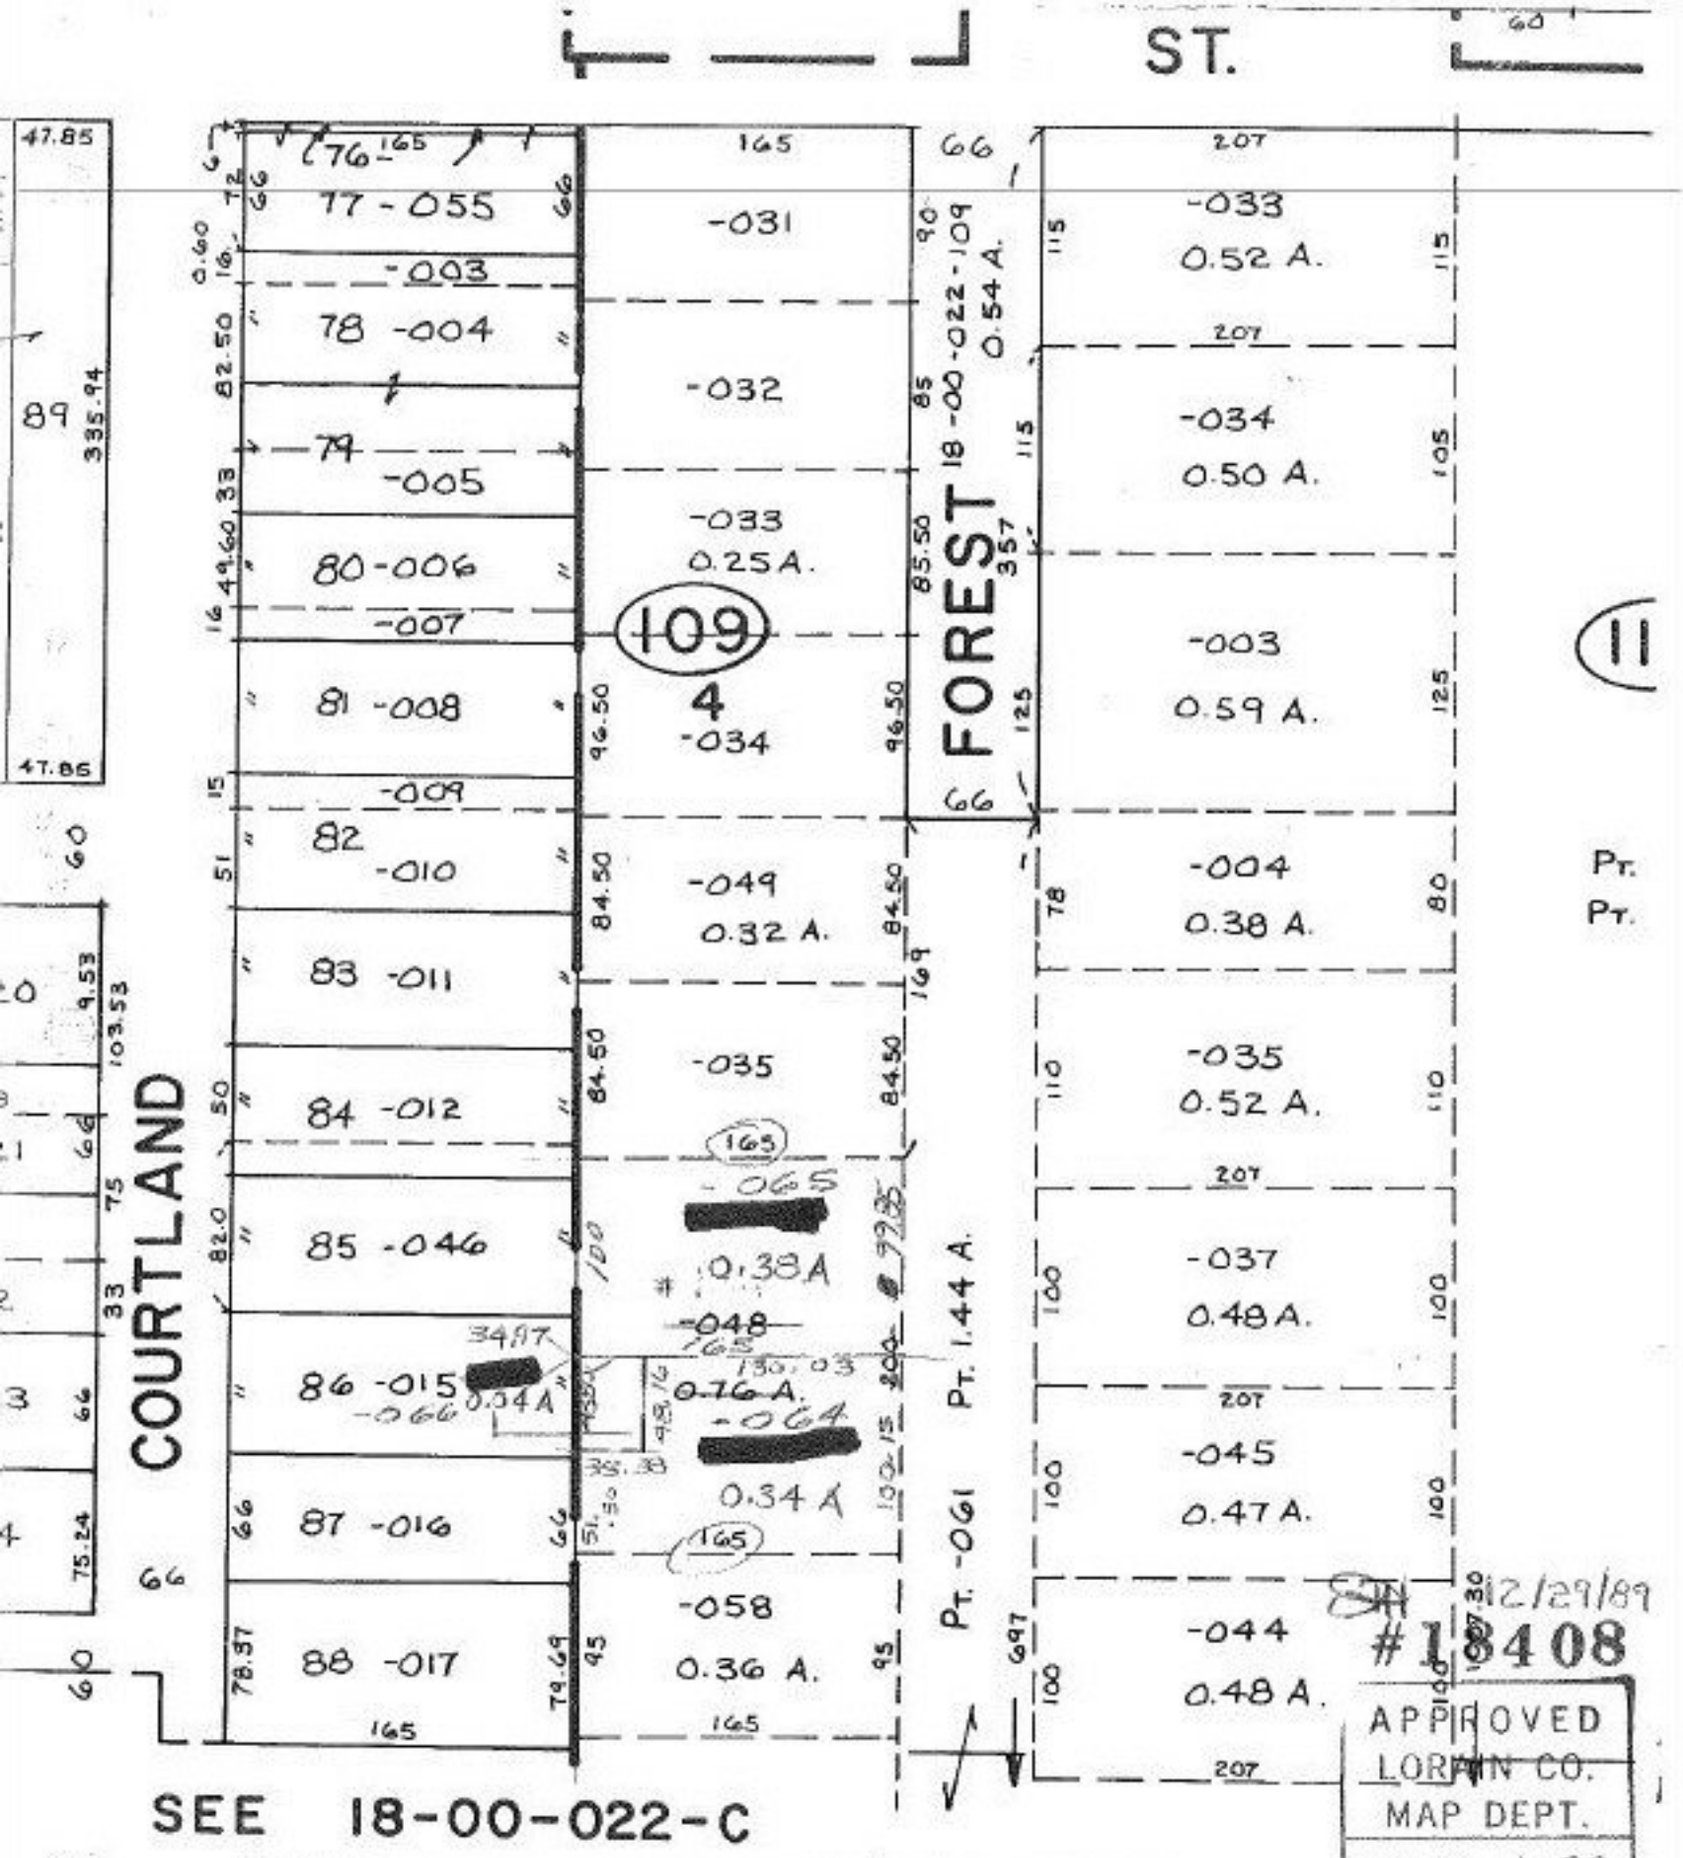

12/29/89

18408

APPROVED
LORAIN CO.
MAP DEPT.
DATE 5-1-89
PAGE 18-00-022-A
BY CARL-FRANCIS
VOID AFTER #: 18408

18-00-022-109-
PRIOR INST.

SURVEYED BY. KS. ASSOC.
C=1: 17241
C=1: 1100000.