SEE 4-00-016-G

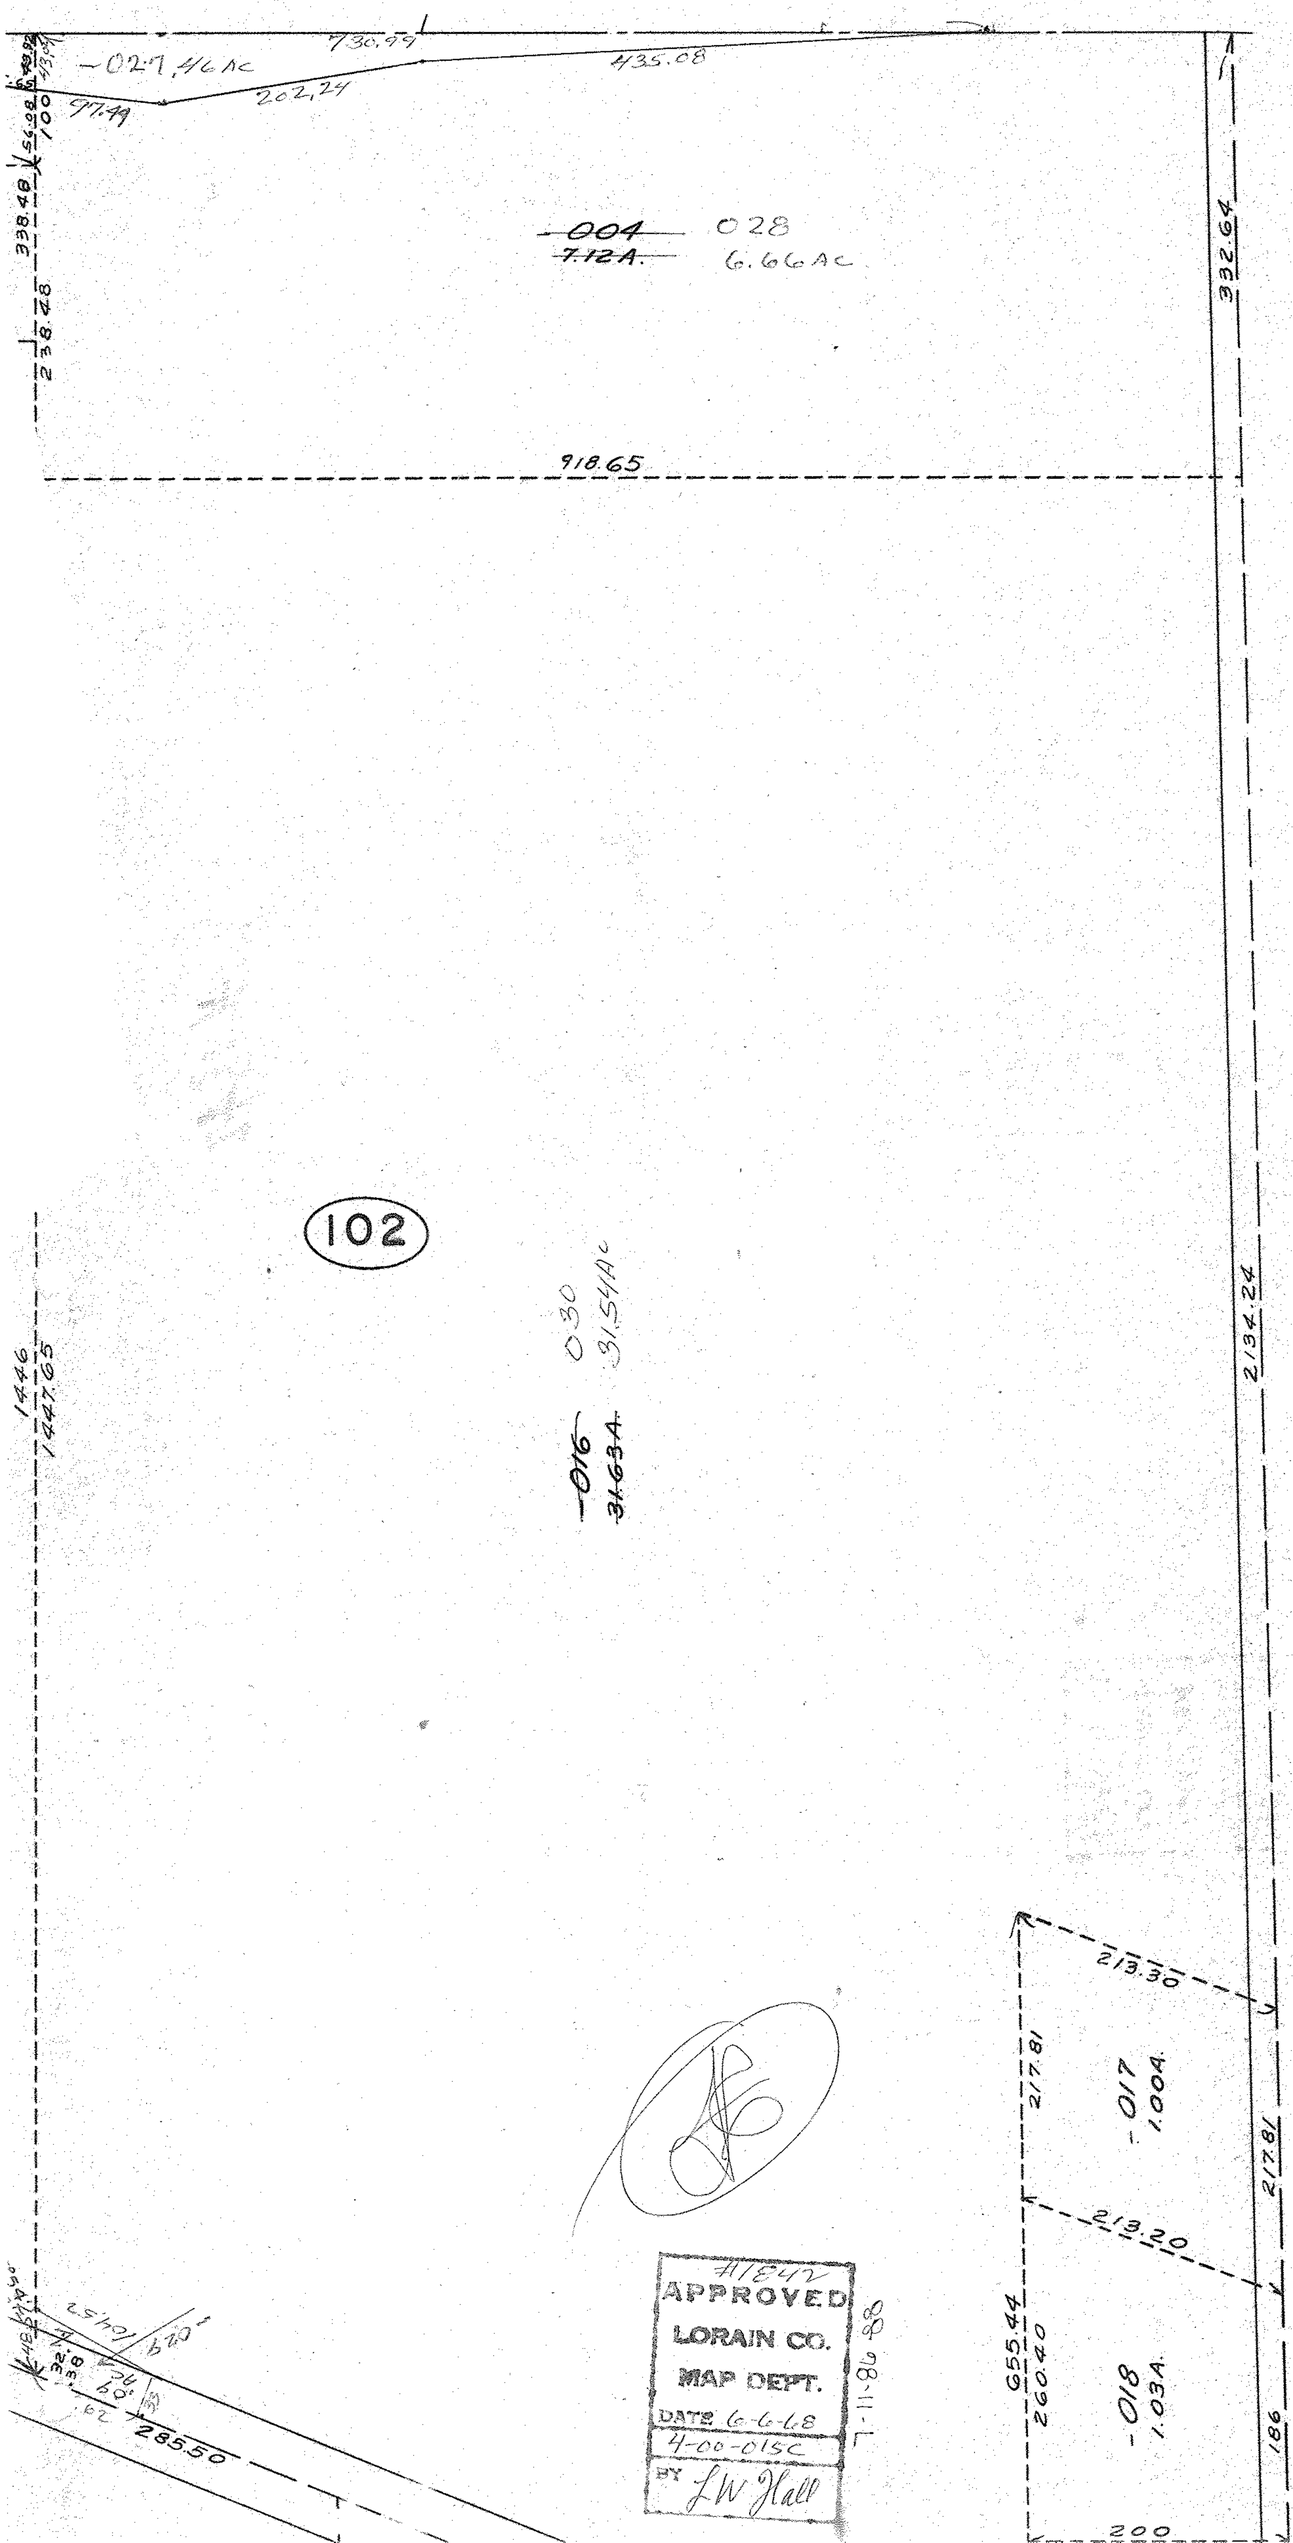

APPROVED
LORAIN CO.
MAP DEPT.
DATE 6-6-68
4-00-015C
BY LW Hall

7-11-86 88