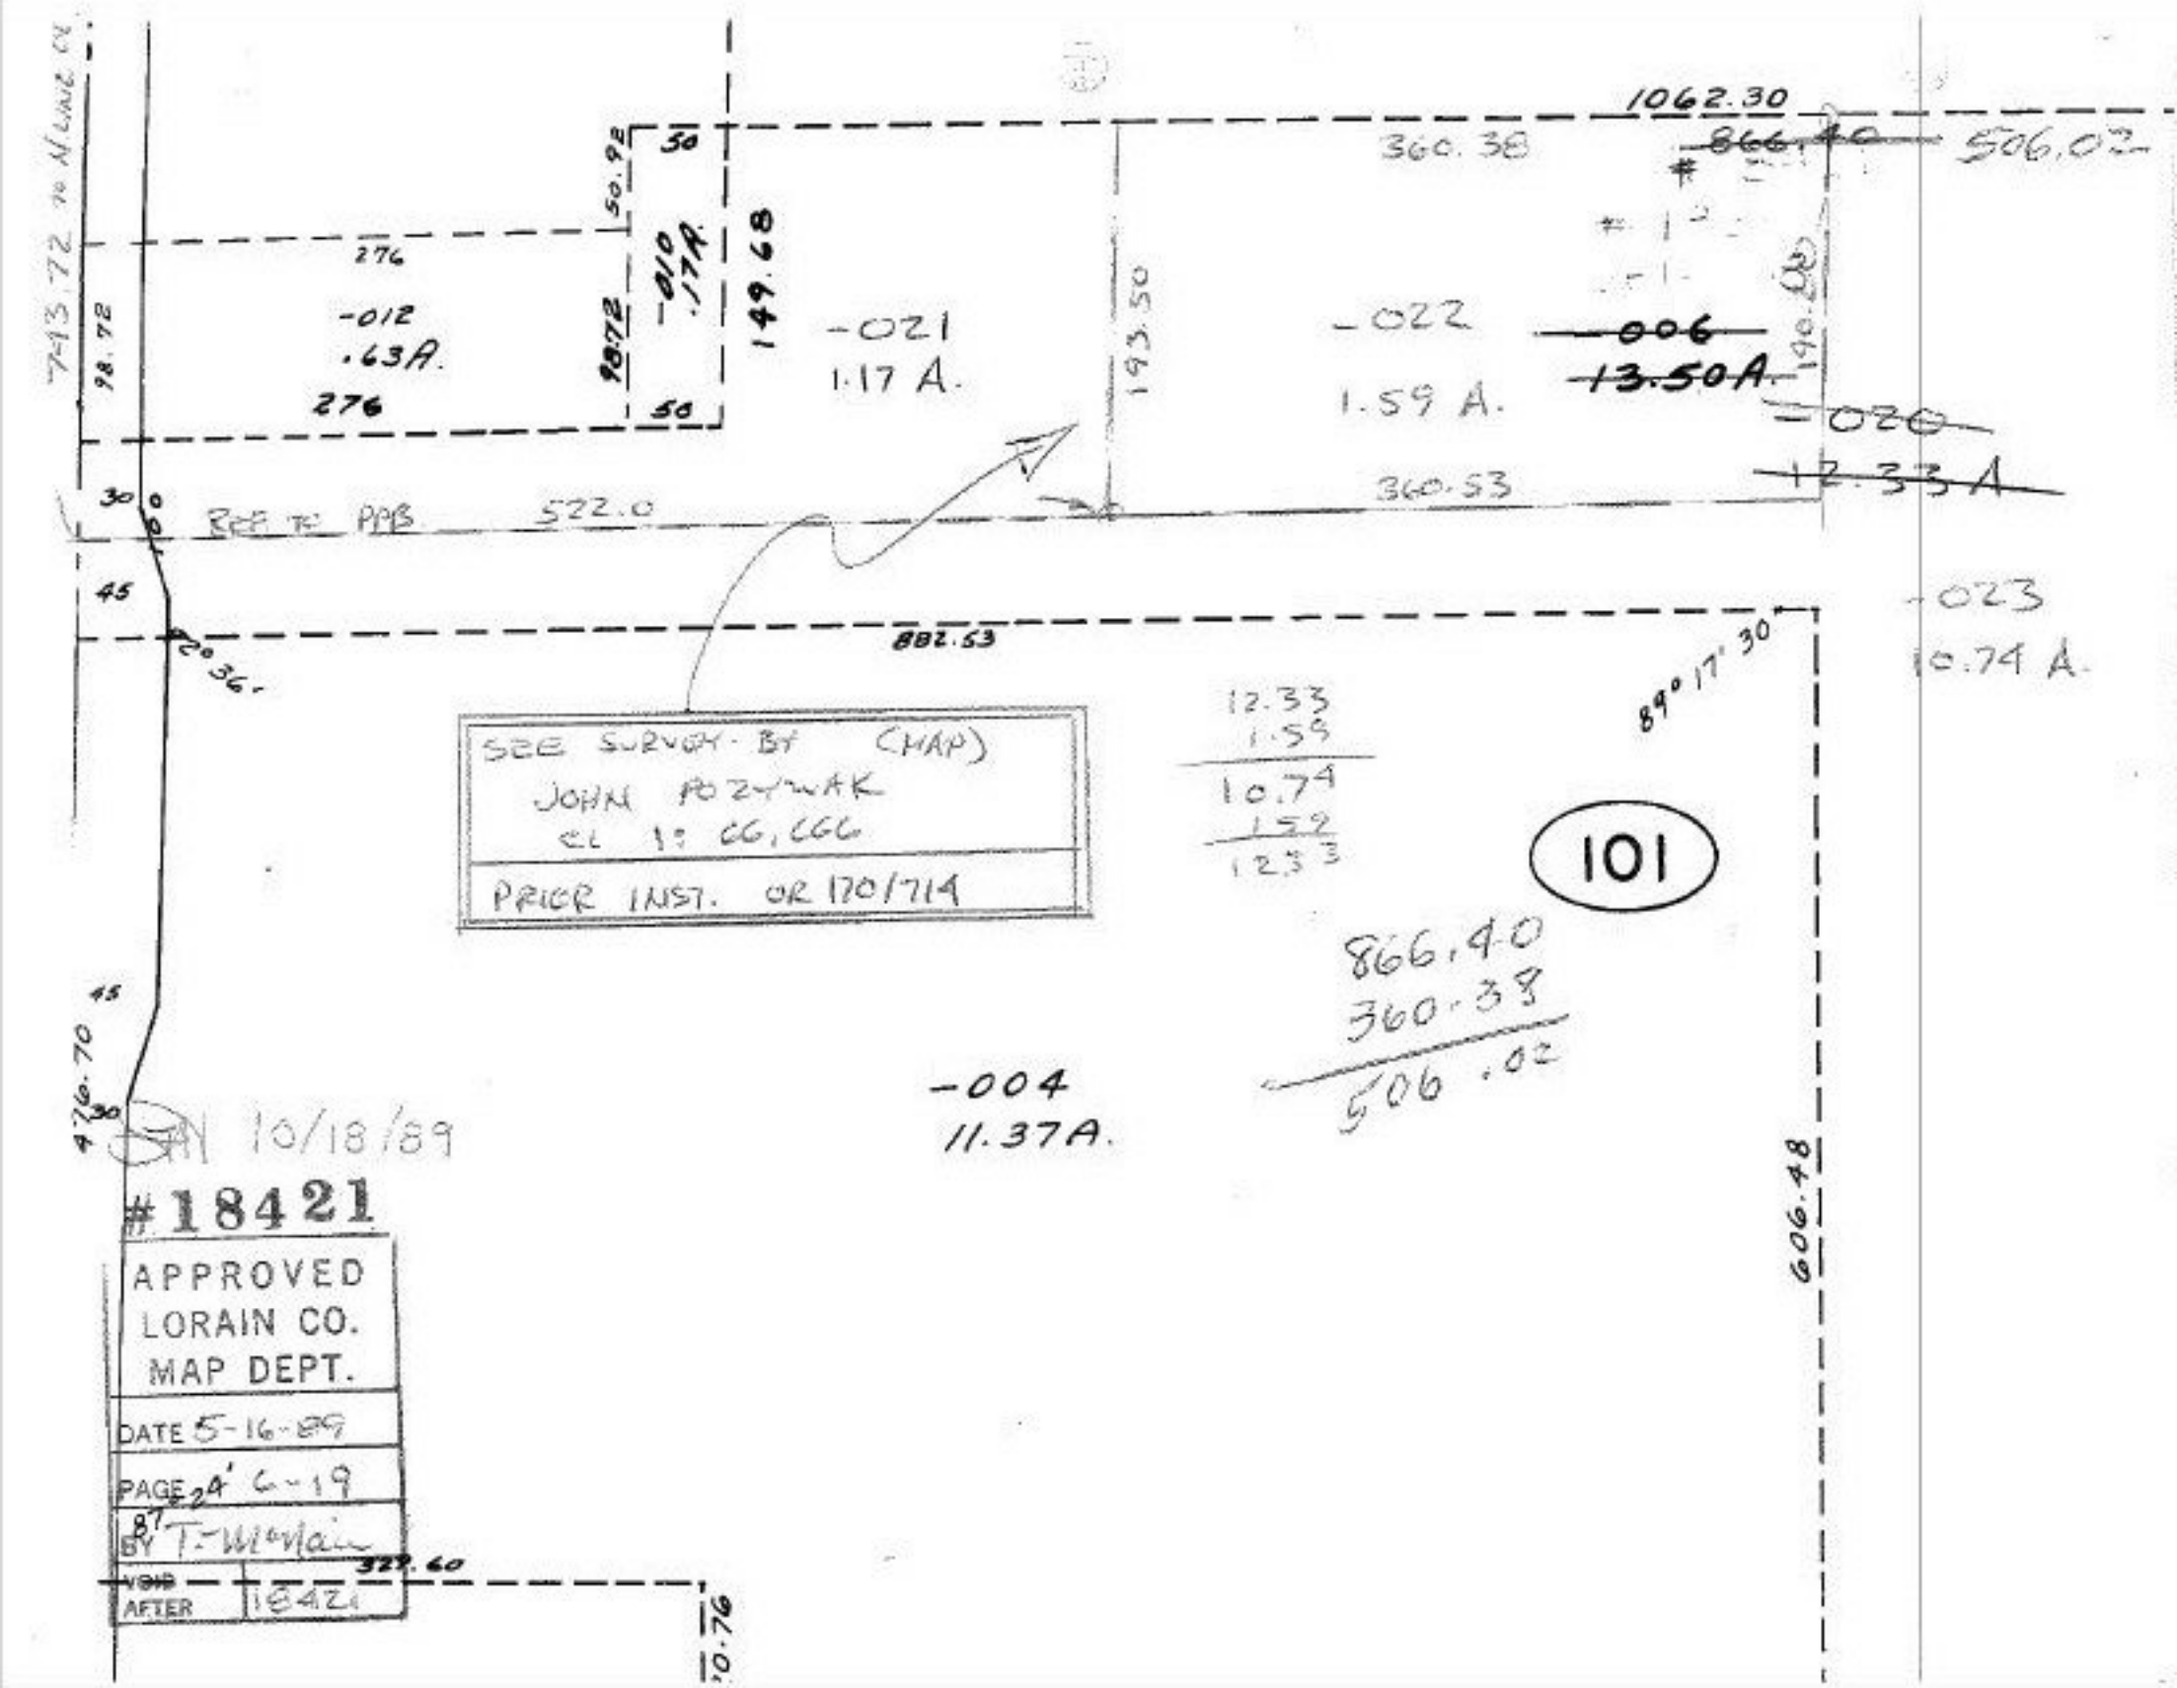
743.72 to N Line Co.
1062.30
360.38
866.40
506.02
276
-012
.63A.
28.72
276
50.92
30
98.72
-010
.17A.
50
149.68
-021
1.17 A.
193.50
-022
1.59 A.
006
13.50A.
190.20
020
12.33A
360.53
30
100
Ref to PPB
522.0
45
882.53
-023
10.74 A.
SEE SURVEY BY (MAP)
JOHN POZYWAK
CL 1: CG, CGG
PRIOR INST. OR 170/714
12.33
1.59
10.74
152
123
89° 17' 30"
101
866.40
360.38
506.02
-004
11.37A.
476.70
45
606.48
10/18/89
#18421
APPROVED
LORAIN CO.
MAP DEPT.
DATE 5-16-89
PAGE 24 & 19
BY T. Mahan
VOID
AFTER
18421
322.60
10.76