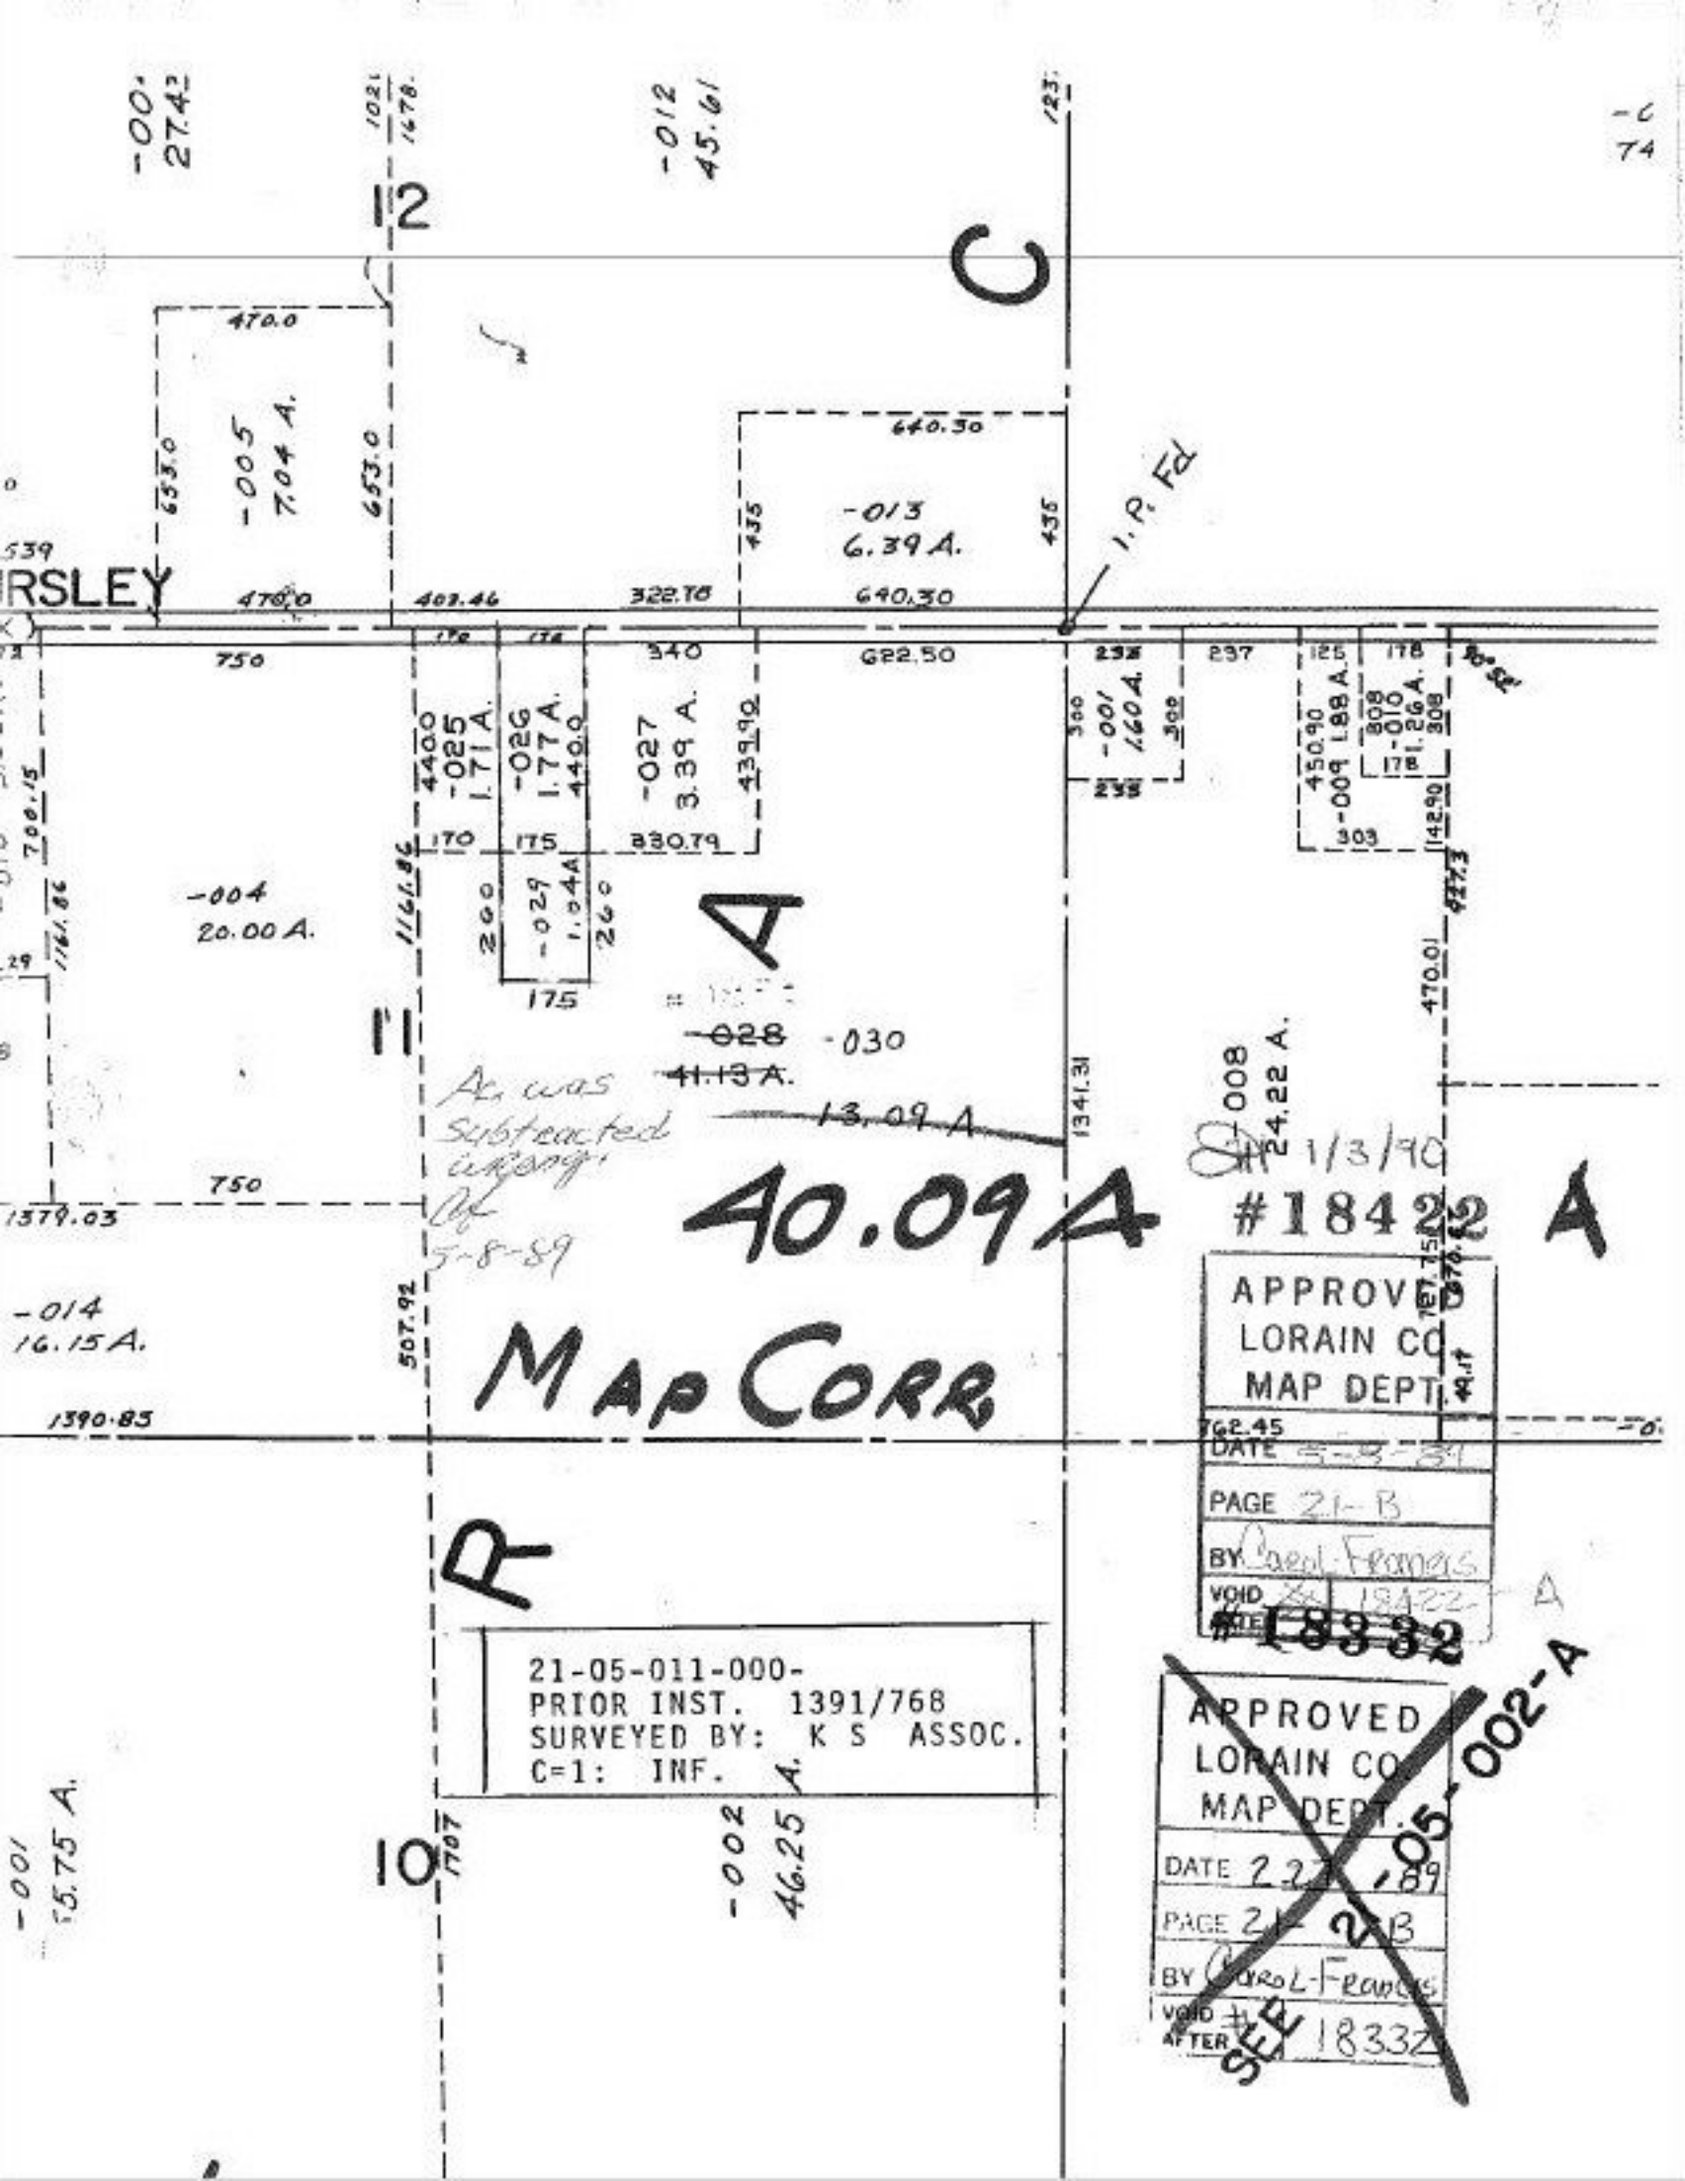

Ac. was subtracted wrong. Of 5-8-89

1/3/90

APPROVED
LORAIN CO
MAP DEPT.
DATE 5-8-89
PAGE 21-B
BY Carol Francis
VOID AFTER #18422 A

APPROVED
LORAIN CO
MAP DEPT.
DATE 2-27-89
PAGE 21-B
BY Carol Francis
VOID AFTER #18332

SEE 21-05-002-A