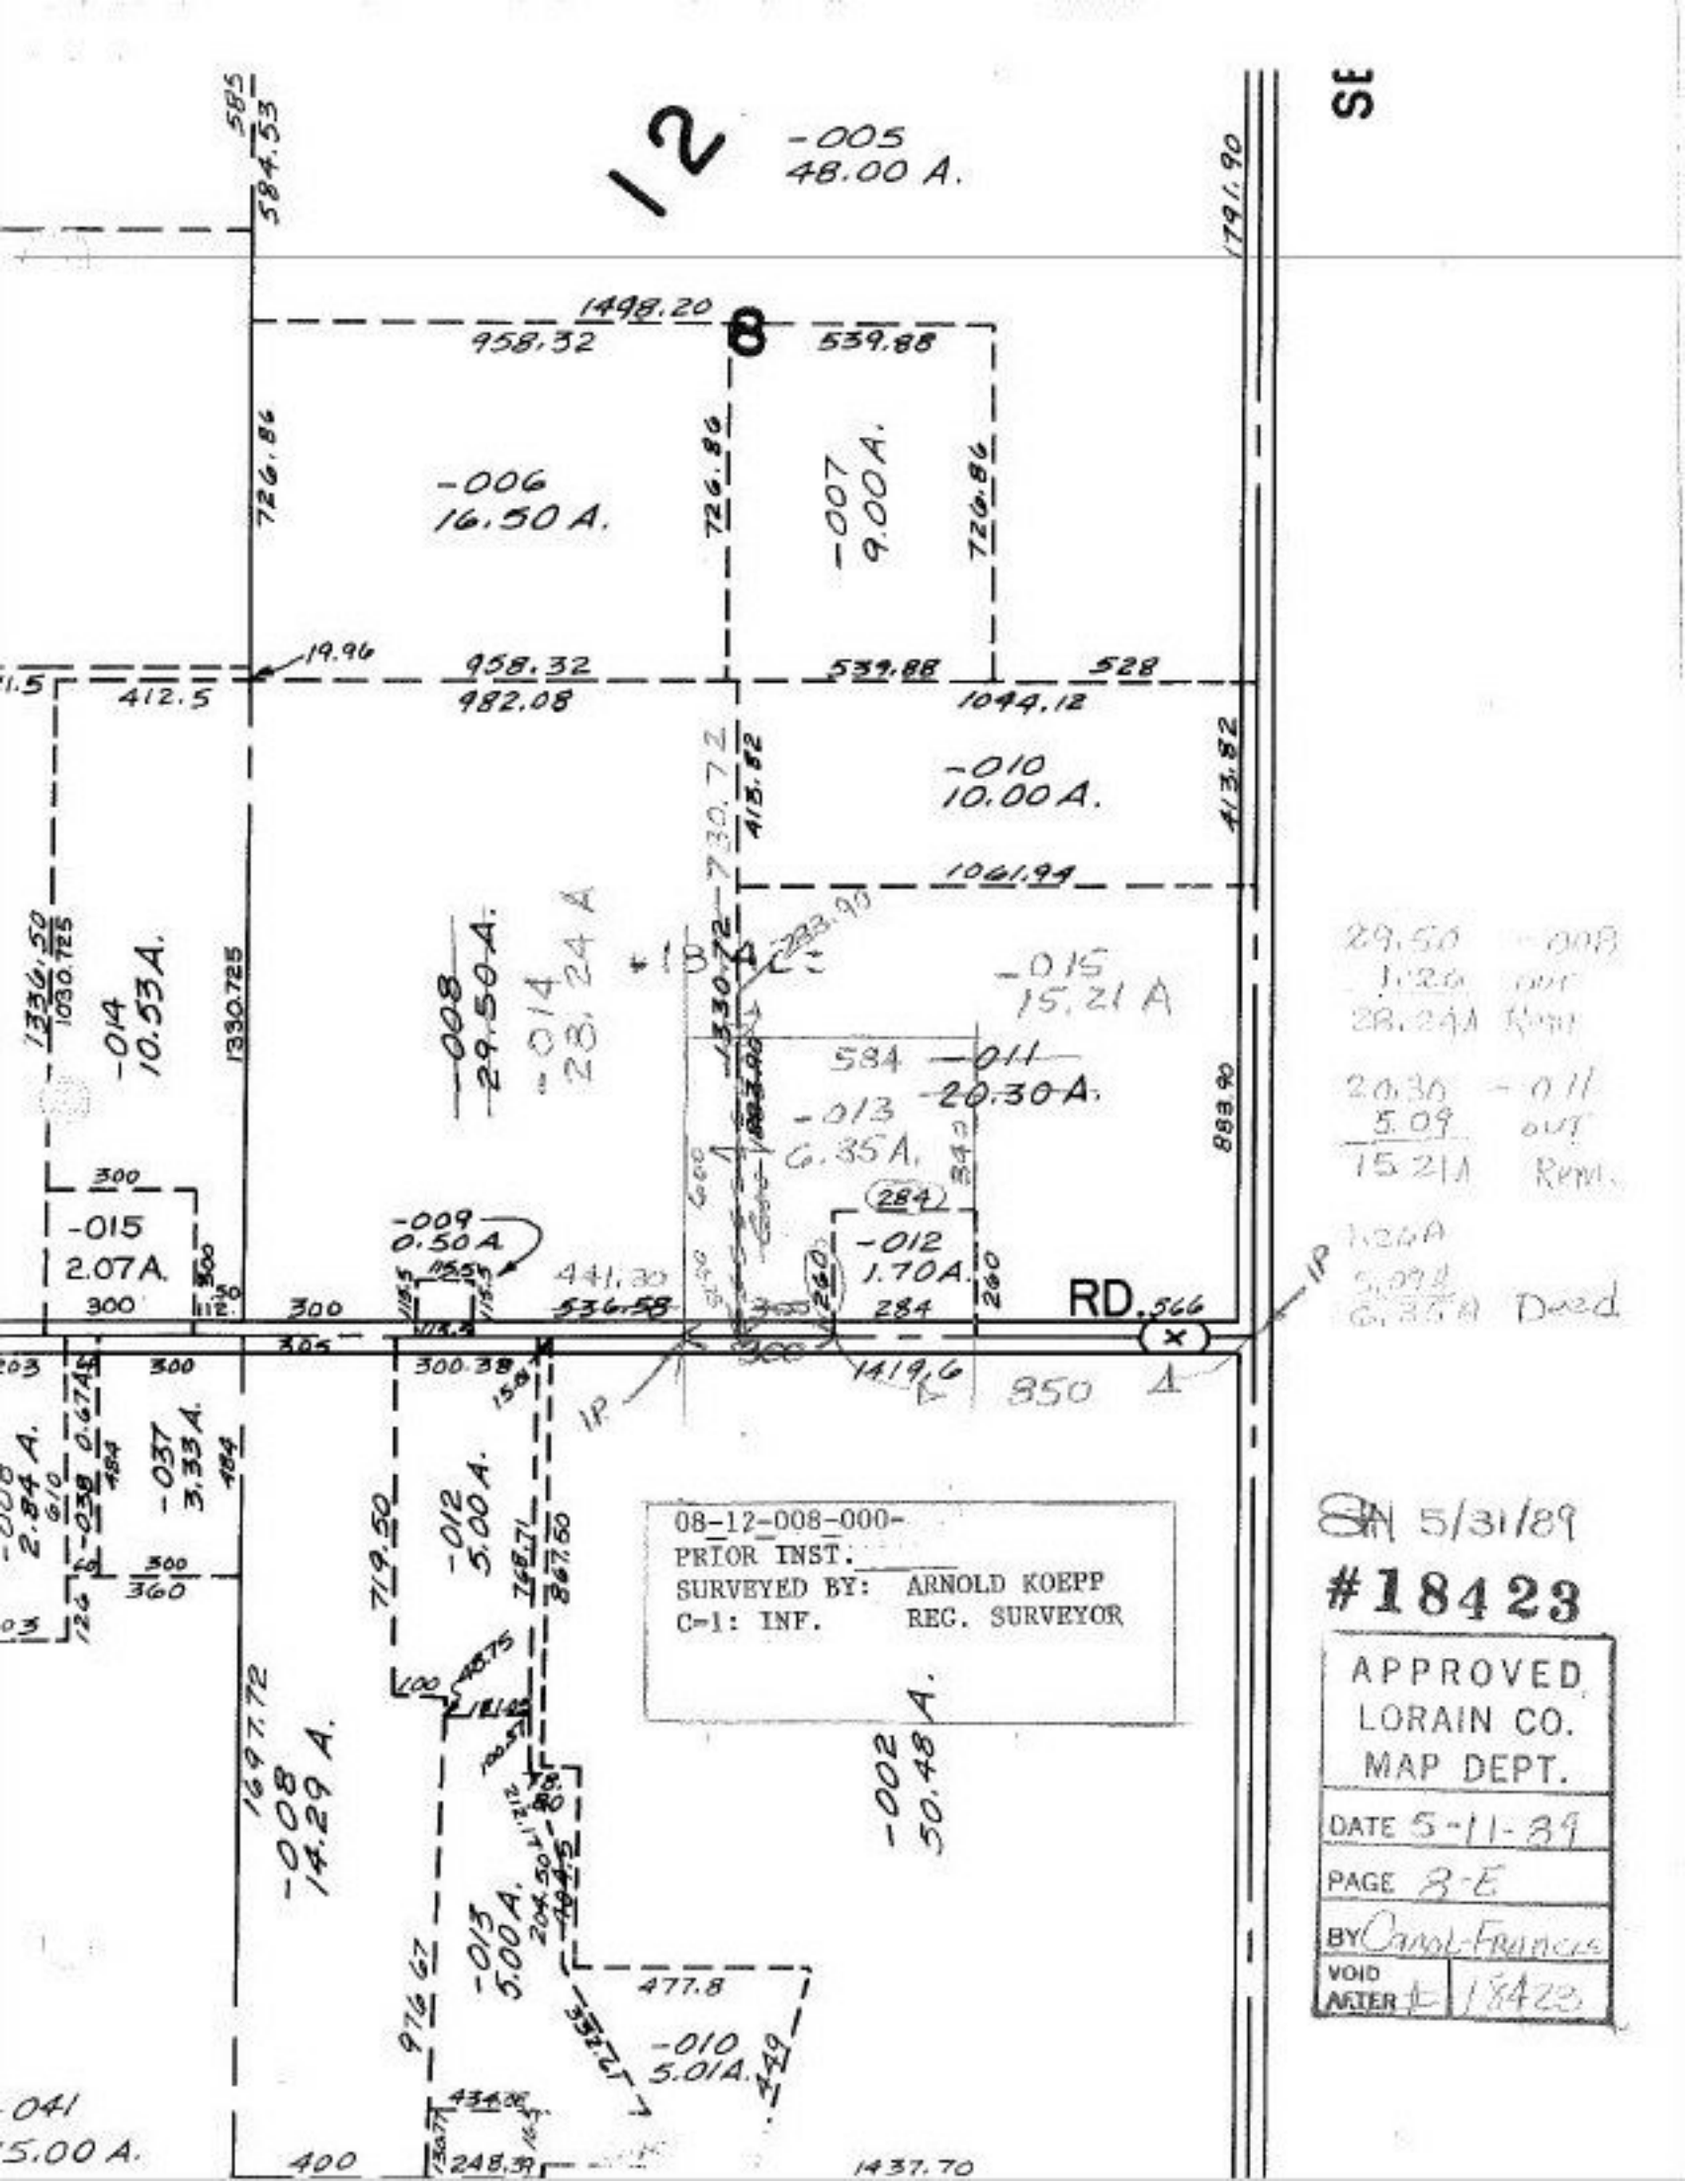
12
-005
48.00 A.
8
-006
16.50 A.
-007
9.00 A.
-010
10.00 A.
-014
10.53 A.
-008
29.50 A.
-014
28.24 A
-015
15.21 A
-011
20.30 A.
-013
6.35 A.
-009
0.50 A
-012
1.70 A.
-015
2.07 A.
RD. 566
08-12-008-000-
PRIOR INST.:
SURVEYED BY: ARNOLD KOEPP
C-1: INF. REG. SURVEYOR
-008
14.29 A.
-012
5.00 A.
-013
5.00 A.
-010
5.01 A.
-002
50.48 A.
-037
3.33 A.
-038
2.84 A.
-041
5.00 A.
SE
29.50 -008
1.26 out
28.24 A Rem
20.30 -011
5.09 out
15.21 A Rem
1.26 A
5.09 A
6.35 A Deed
5/31/89
#18423
APPROVED
LORAIN CO.
MAP DEPT.
DATE 5-11-89
PAGE 8-E
BY Carol-Frances
VOID AFTER # 18423