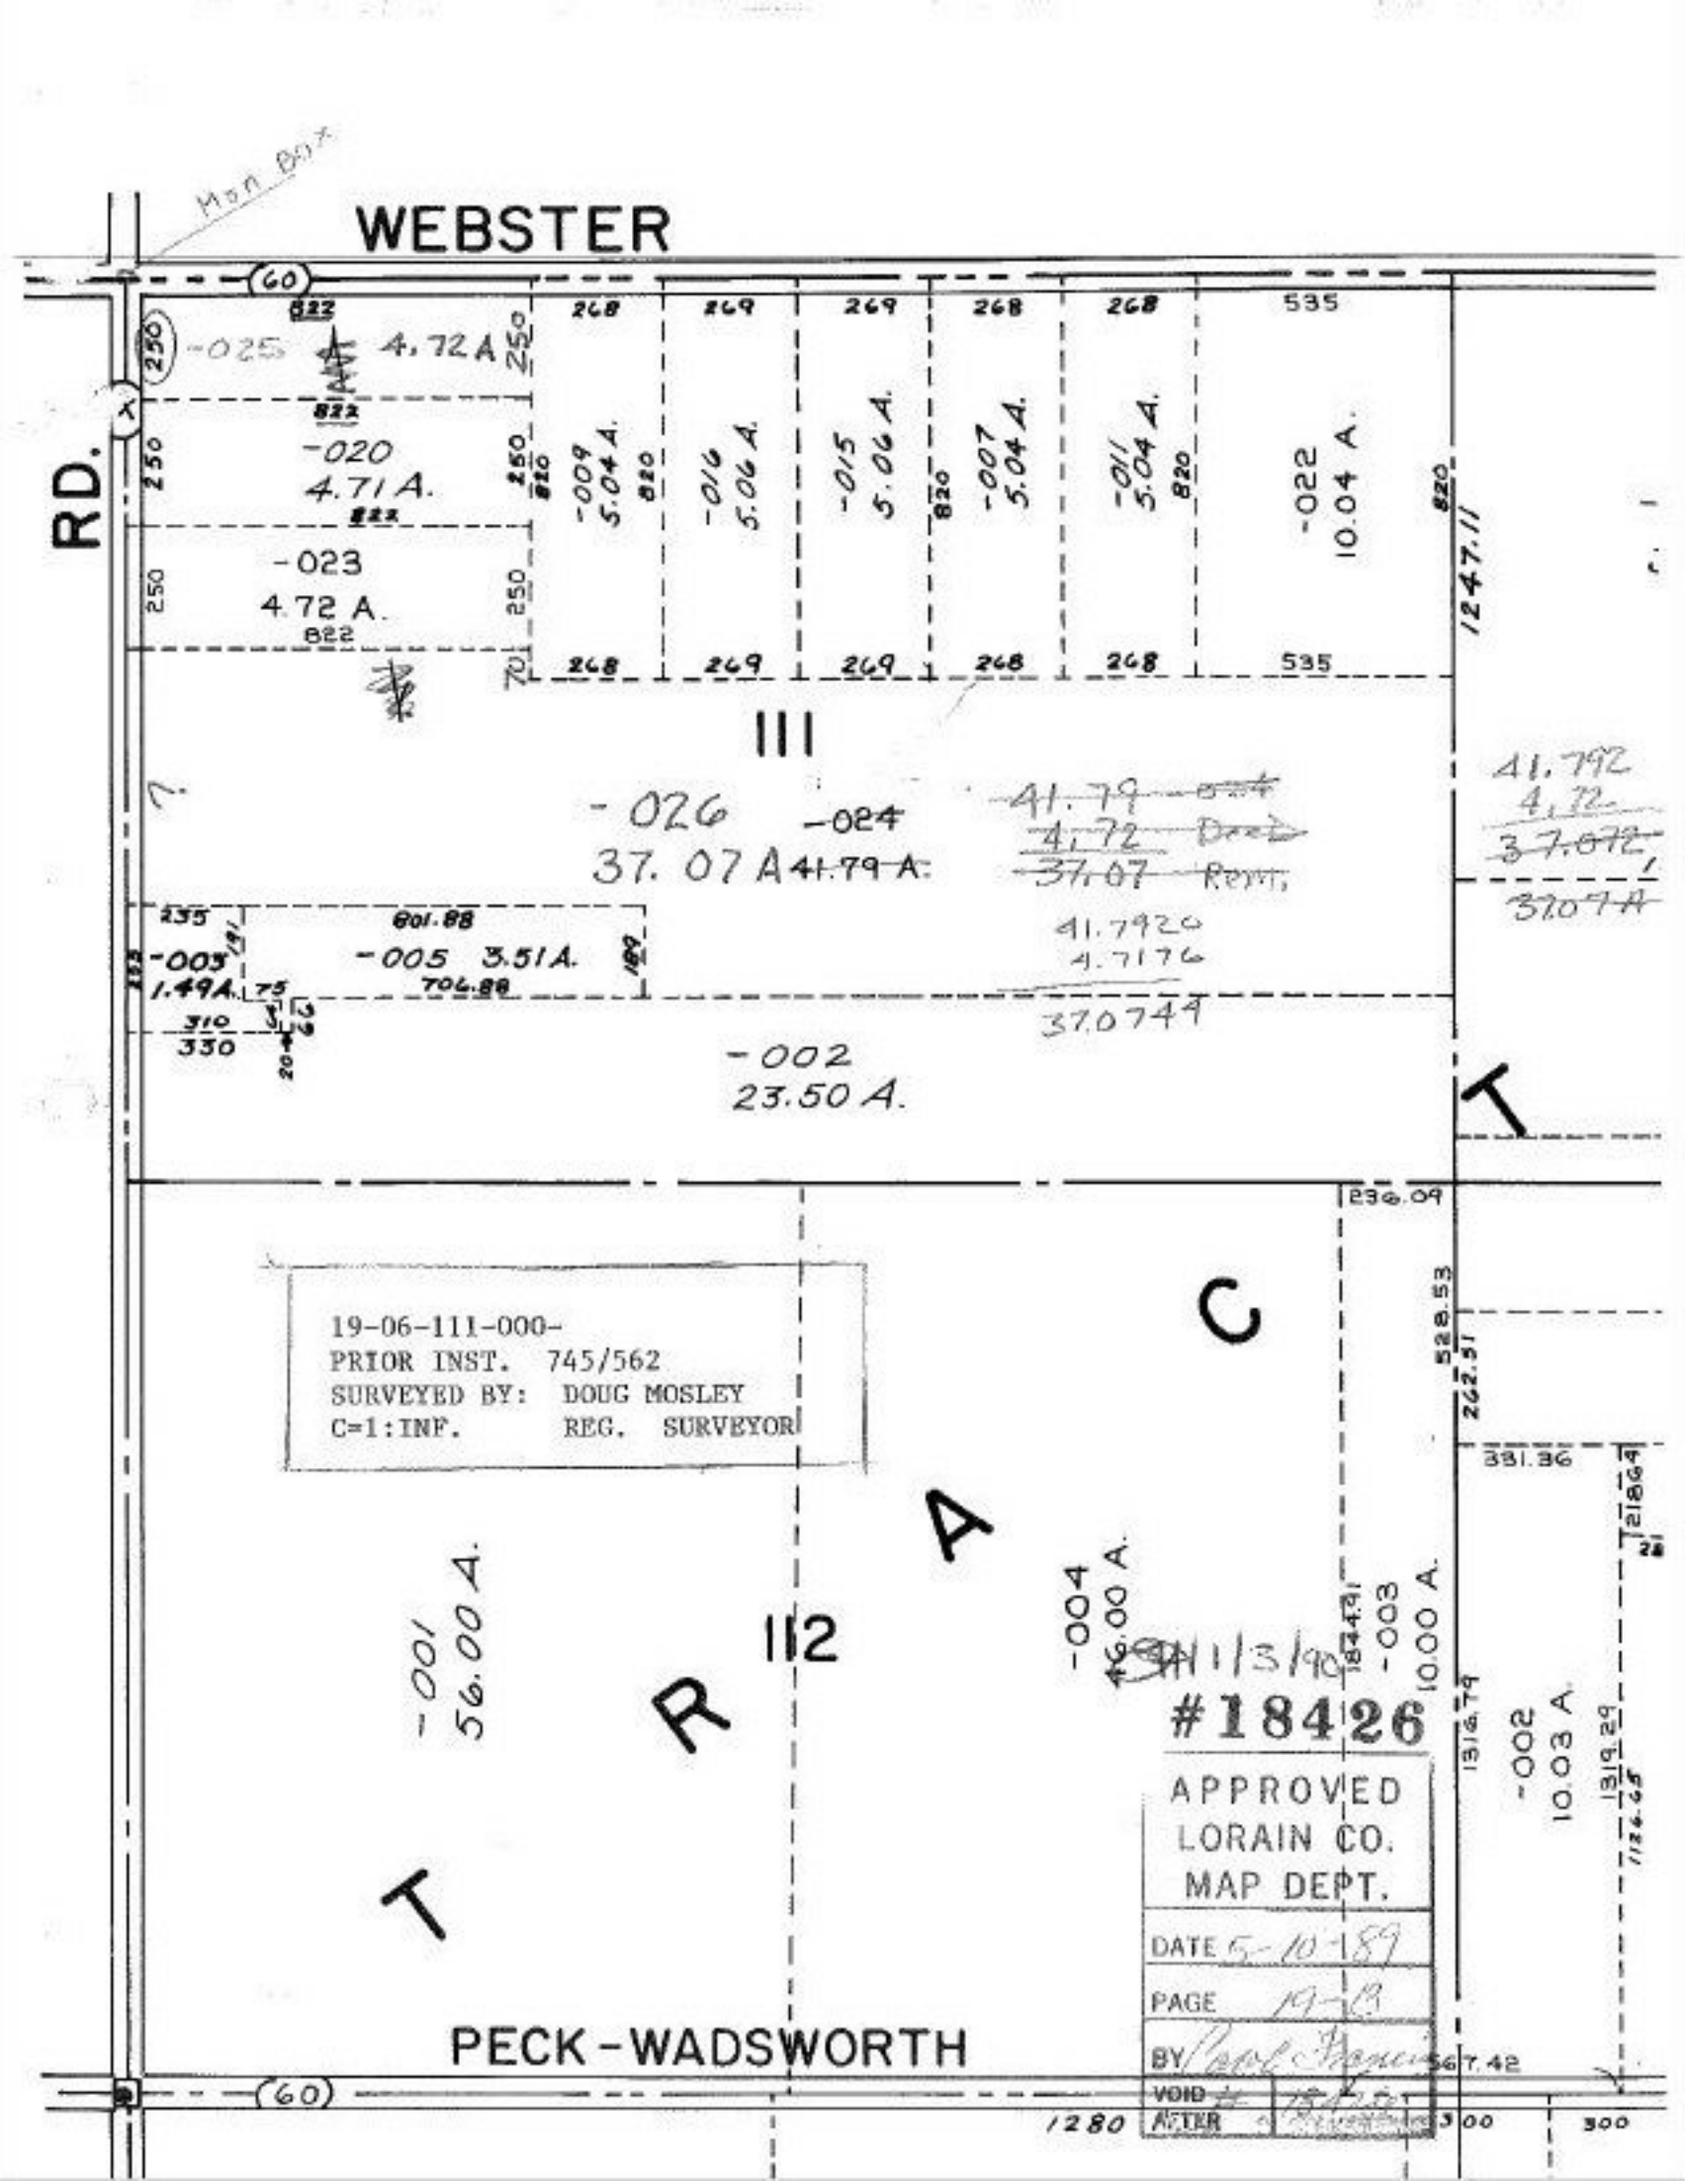

Mon Box
WEBSTER
RD.
(60)
-025 4.72 A
-020 4.71 A.
-023 4.72 A.
-009 5.04 A.
-016 5.06 A.
-015 5.06 A.
-007 5.04 A.
-011 5.04 A.
-022 10.04 A.
1247.11
111
-026 37.07 A
-024 41.79 A.
41.79 -024
4.72 Deed
37.07 Rem.
41.792
4.72
37.072
37.07 A
41.7920
4.7176
37.0744
-003 1.49 A.
-005 3.51 A.
-002 23.50 A.
236.09
528.53
262.51
331.36
218.64
19-06-111-000-
PRIOR INST. 745/562
SURVEYED BY: DOUG MOSLEY
C=1:INF. REG. SURVEYOR
-001 56.00 A.
112
-004 46.00 A.
-003 10.00 A.
-002 10.03 A.
1316.79
1319.29
1126.65
1844.91
1/3/90
#18426
APPROVED
LORAIN CO.
MAP DEPT.
DATE 5-10-89
PAGE 19-13
BY
VOID
AFTER
PECK-WADSWORTH
567.42
1280
300