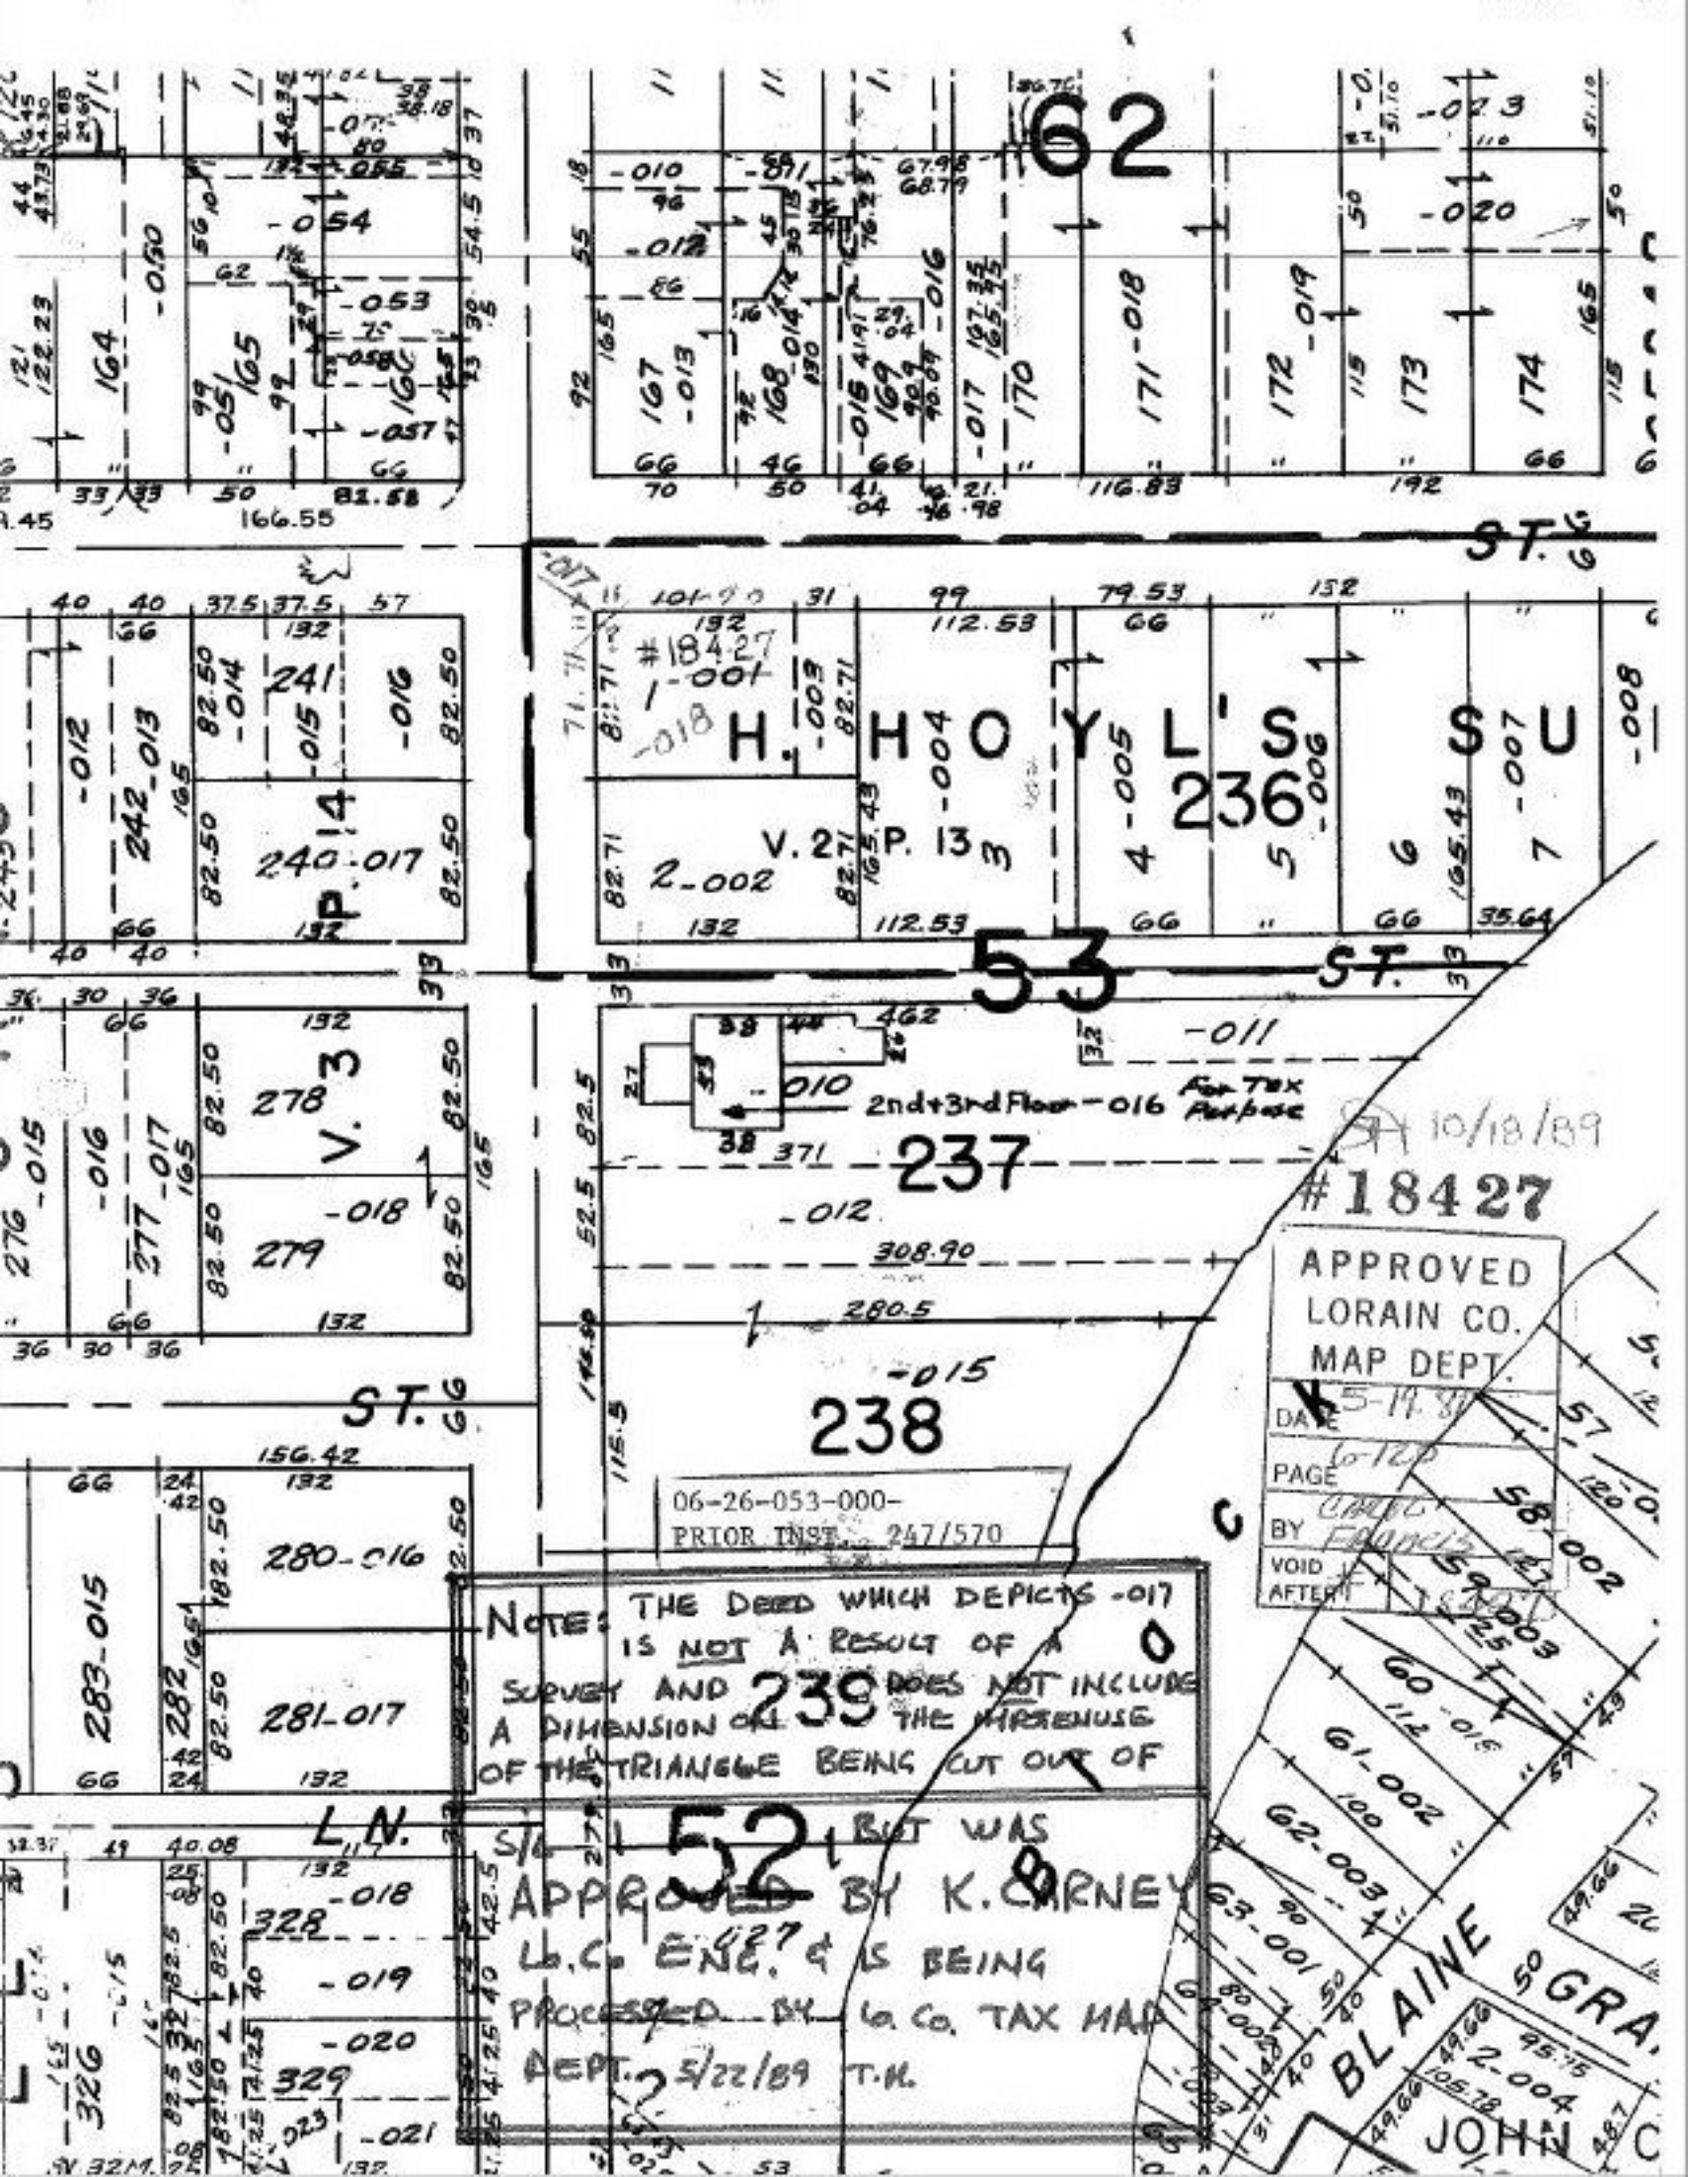
62
53
ST.
H. HOYL'S SU
236
V. 2 P. 13
#18427
237
2nd+3rd Floor -016 For Tax Purpose
238
239
52
L.N.
BLAINE
GRA
JOHN C
06-26-053-000-
PRIOR INST. 247/570
NOTE: THE DEED WHICH DEPICTS -017 IS NOT A RESULT OF A SURVEY AND DOES NOT INCLUDE A DIMENSION ON THE HYPTENUSE OF THE TRIANGLE BEING CUT OUT OF S/L 1 BUT WAS APPROVED BY K. CARNEY Lo. Co. ENG. & IS BEING PROCESSED BY Lo. Co. TAX MAP DEPT. 5/22/89 T.M.
APPROVED
LORAIN CO.
MAP DEPT.
DATE 5-19-89
PAGE 6-120
BY CAROL FRANCIS
VOID AFTER
10/18/89
#18427