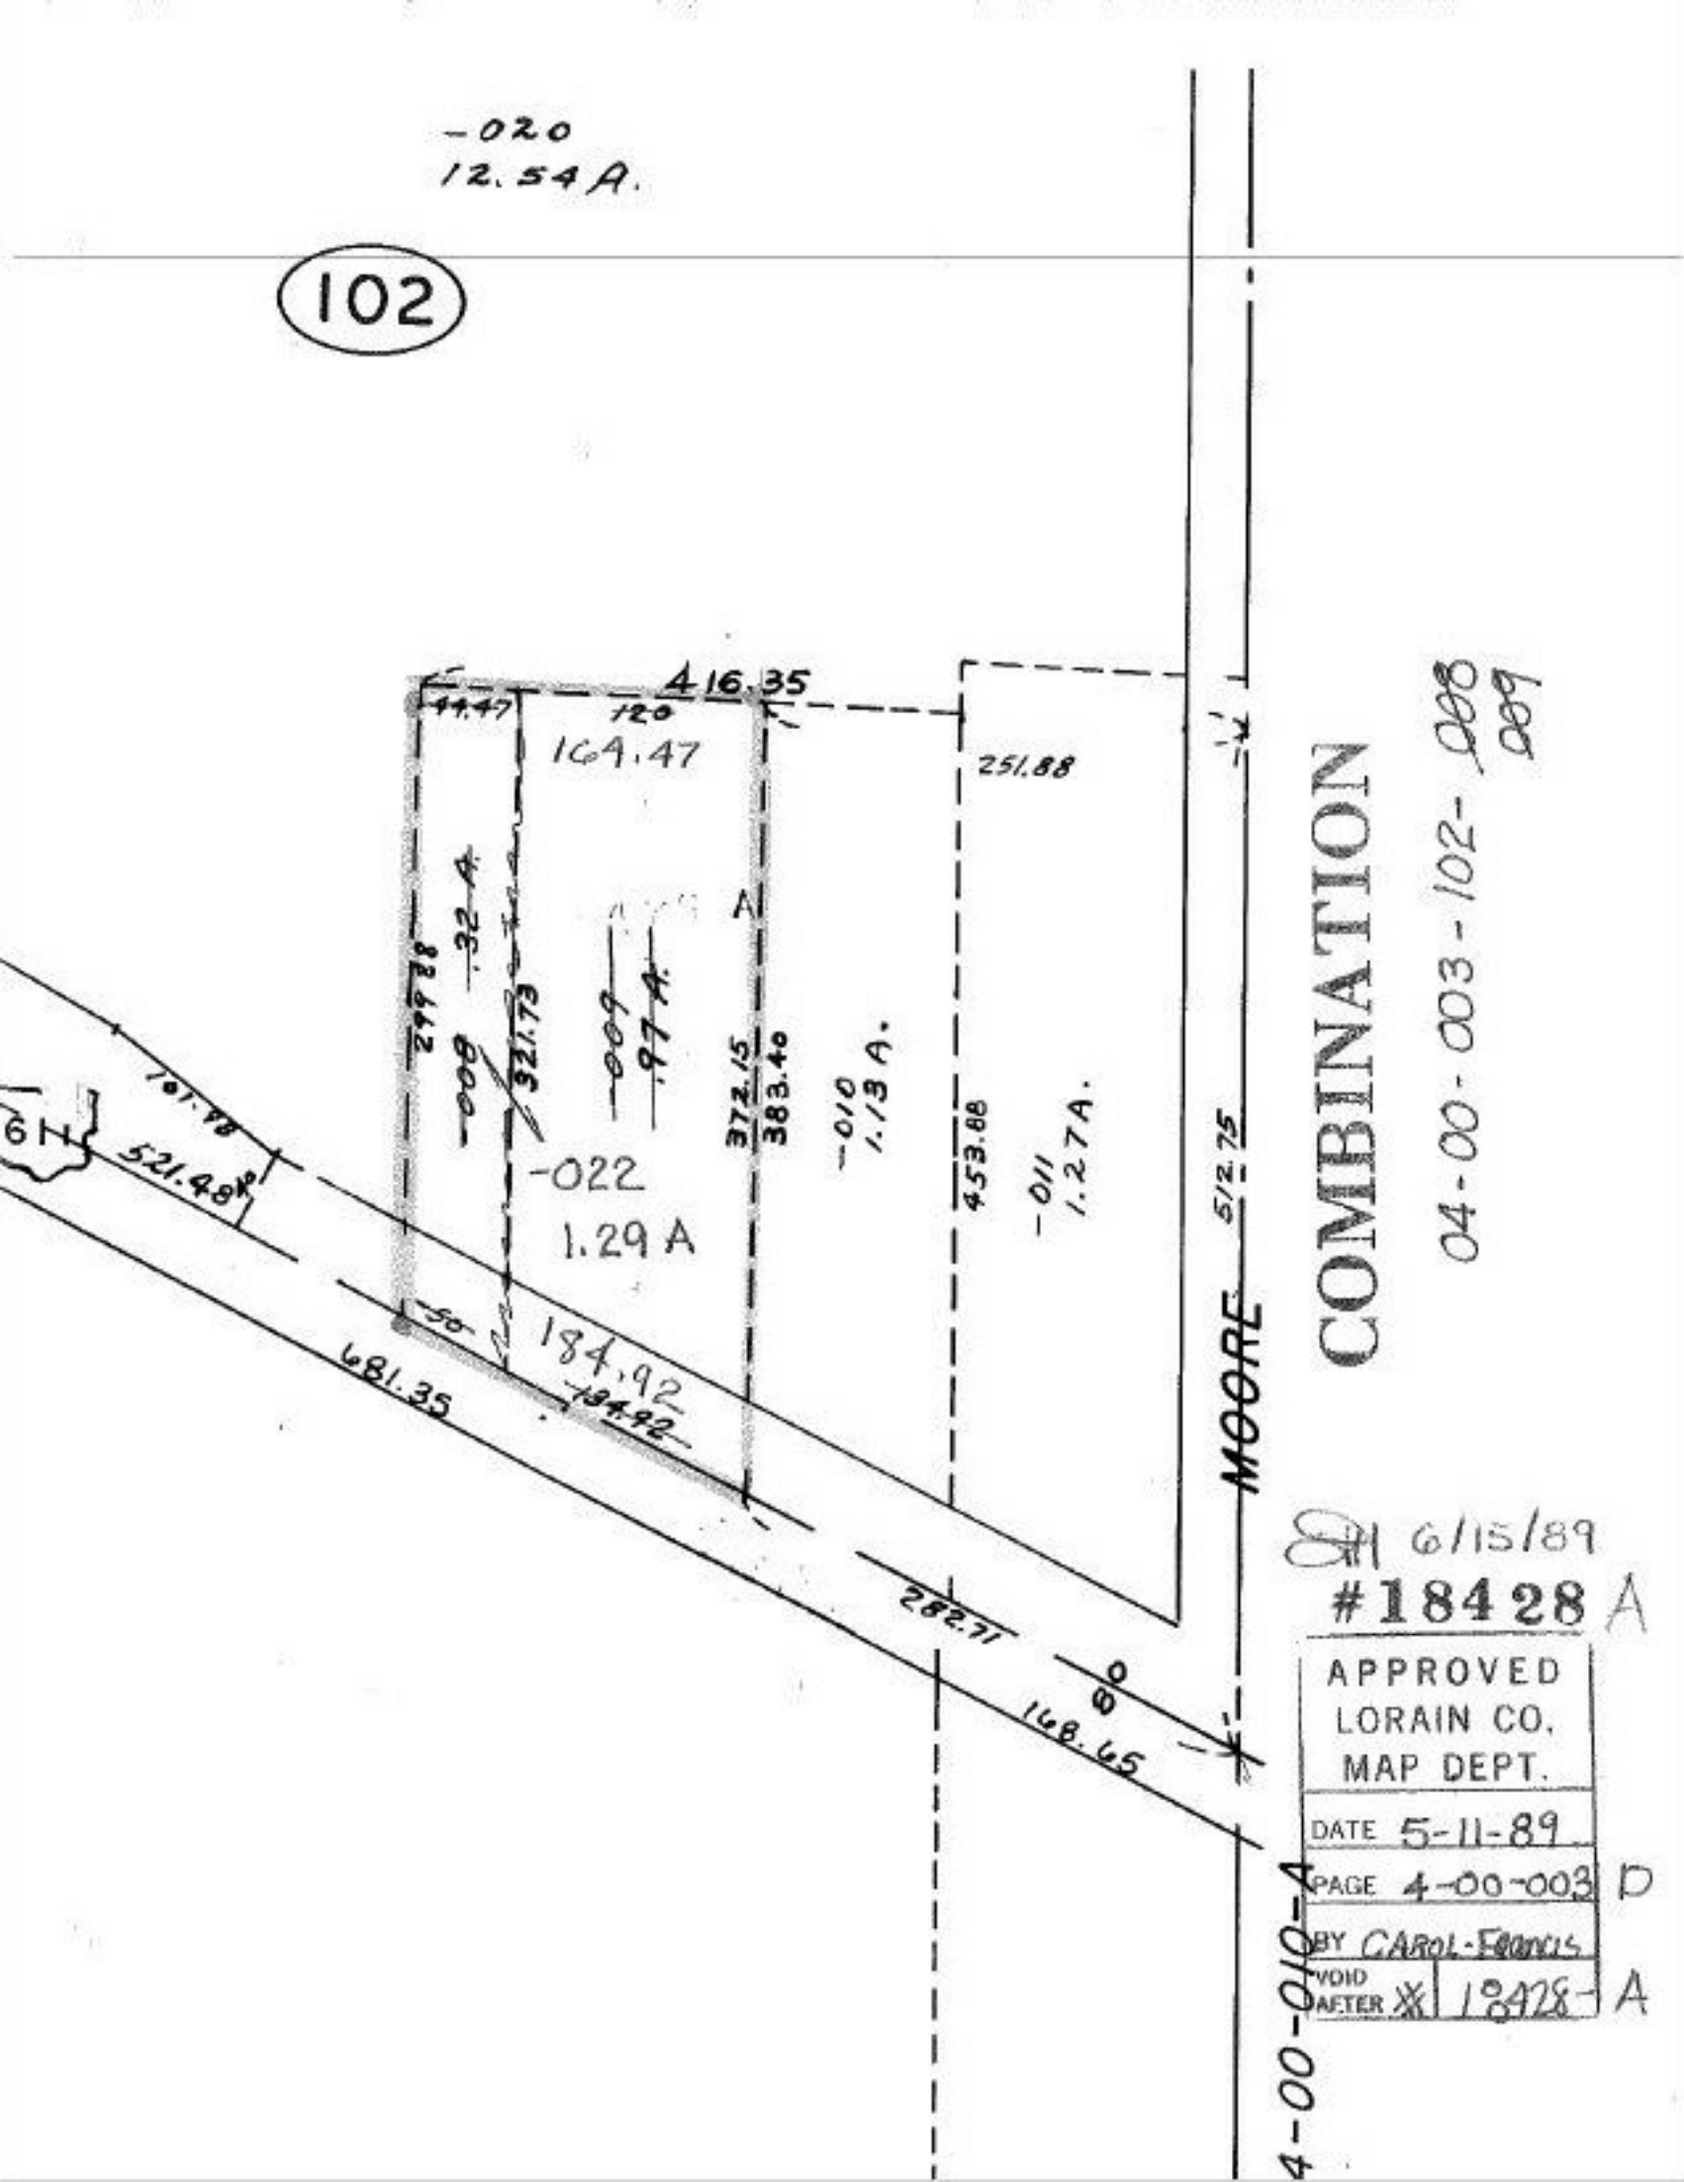
-020
12.54 A.
102
416.35
120
44.47
164.47
251.88
COMBINATION
04-00-003-102-008
009
MOORE
512.75
-010
1.13 A.
-011
1.27 A.
453.88
372.15
383.40
321.73
219.18
-022
1.29 A
97.4
101.78
521.48
681.35
50
184.92
282.71
80
168.65
4-00-010-4
6/15/89
#18428 A
APPROVED
LORAIN CO.
MAP DEPT.
DATE 5-11-89
PAGE 4-00-003 D
BY CAROL-FRANCIS
VOID AFTER XX 18428 A