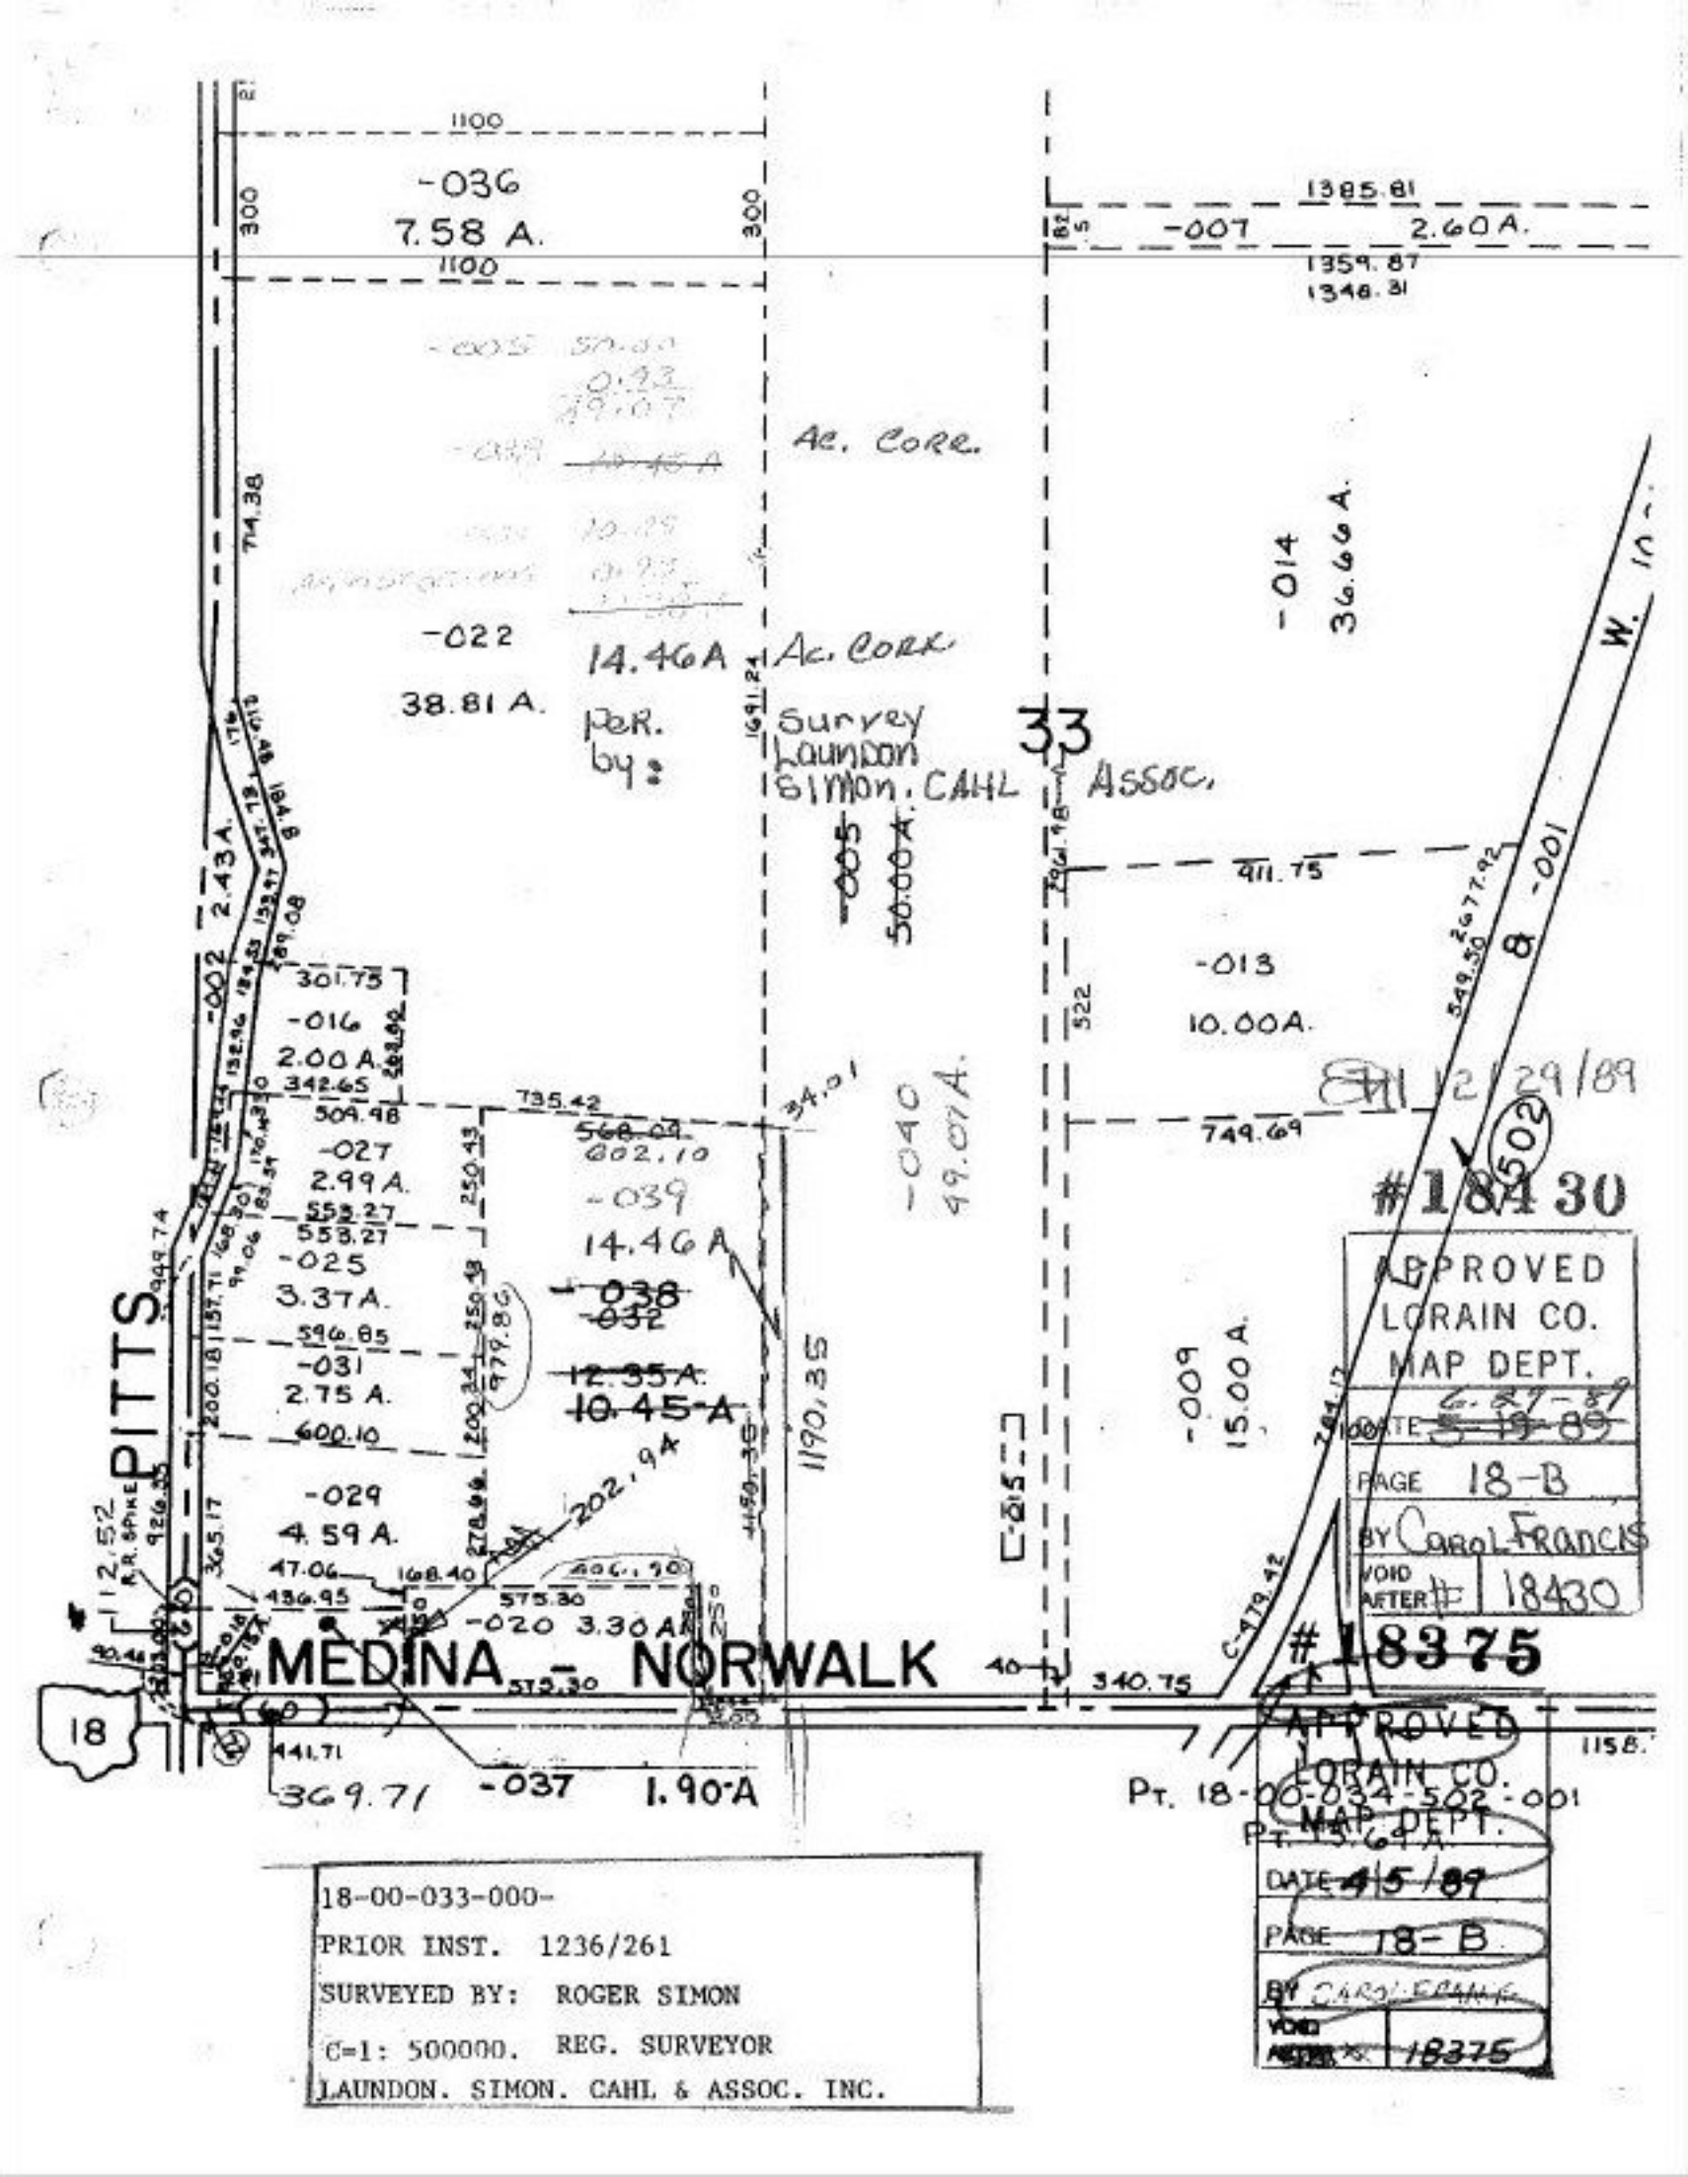
-036
7.58 A.
1100
300
1385.81
-007
2.60A.
1359.87
1348.31
Ac. Core.
-014
36.66 A.
-022
14.46A
Ac. Corr.
38.81 A.
Per.
by:
Survey
Laundon
Simon. CAHL
Assoc.
33
-005
50.00A.
-013
10.00A.
-040
49.07A.
-039
14.46A
-038
-032
12.35A.
10.45A
-009
15.00 A.
-016
2.00 A.
-027
2.99A.
-025
3.37A.
-031
2.75 A.
-029
4.59 A.
-020 3.30A
-037 1.90A
1190.35
C-215
PITTS
MEDINA
NORWALK
18
Pt. 18-00-034-502-001
Pt. 15.64A
E-11 12/29/89
#18430
APPROVED
LORAIN CO.
MAP DEPT.
DATE 5-19-89
PAGE 18-B
BY CAROL FRANCIS
VOID AFTER # 18430
#18375
APPROVED
LORAIN CO.
MAP DEPT.
DATE 4/5/89
PAGE 18-B
BY CAROL FRANCIS
VOID AFTER # 18375
18-00-033-000-
PRIOR INST. 1236/261
SURVEYED BY: ROGER SIMON
C=1: 500000. REG. SURVEYOR
LAUNDON. SIMON. CAHL & ASSOC. INC.