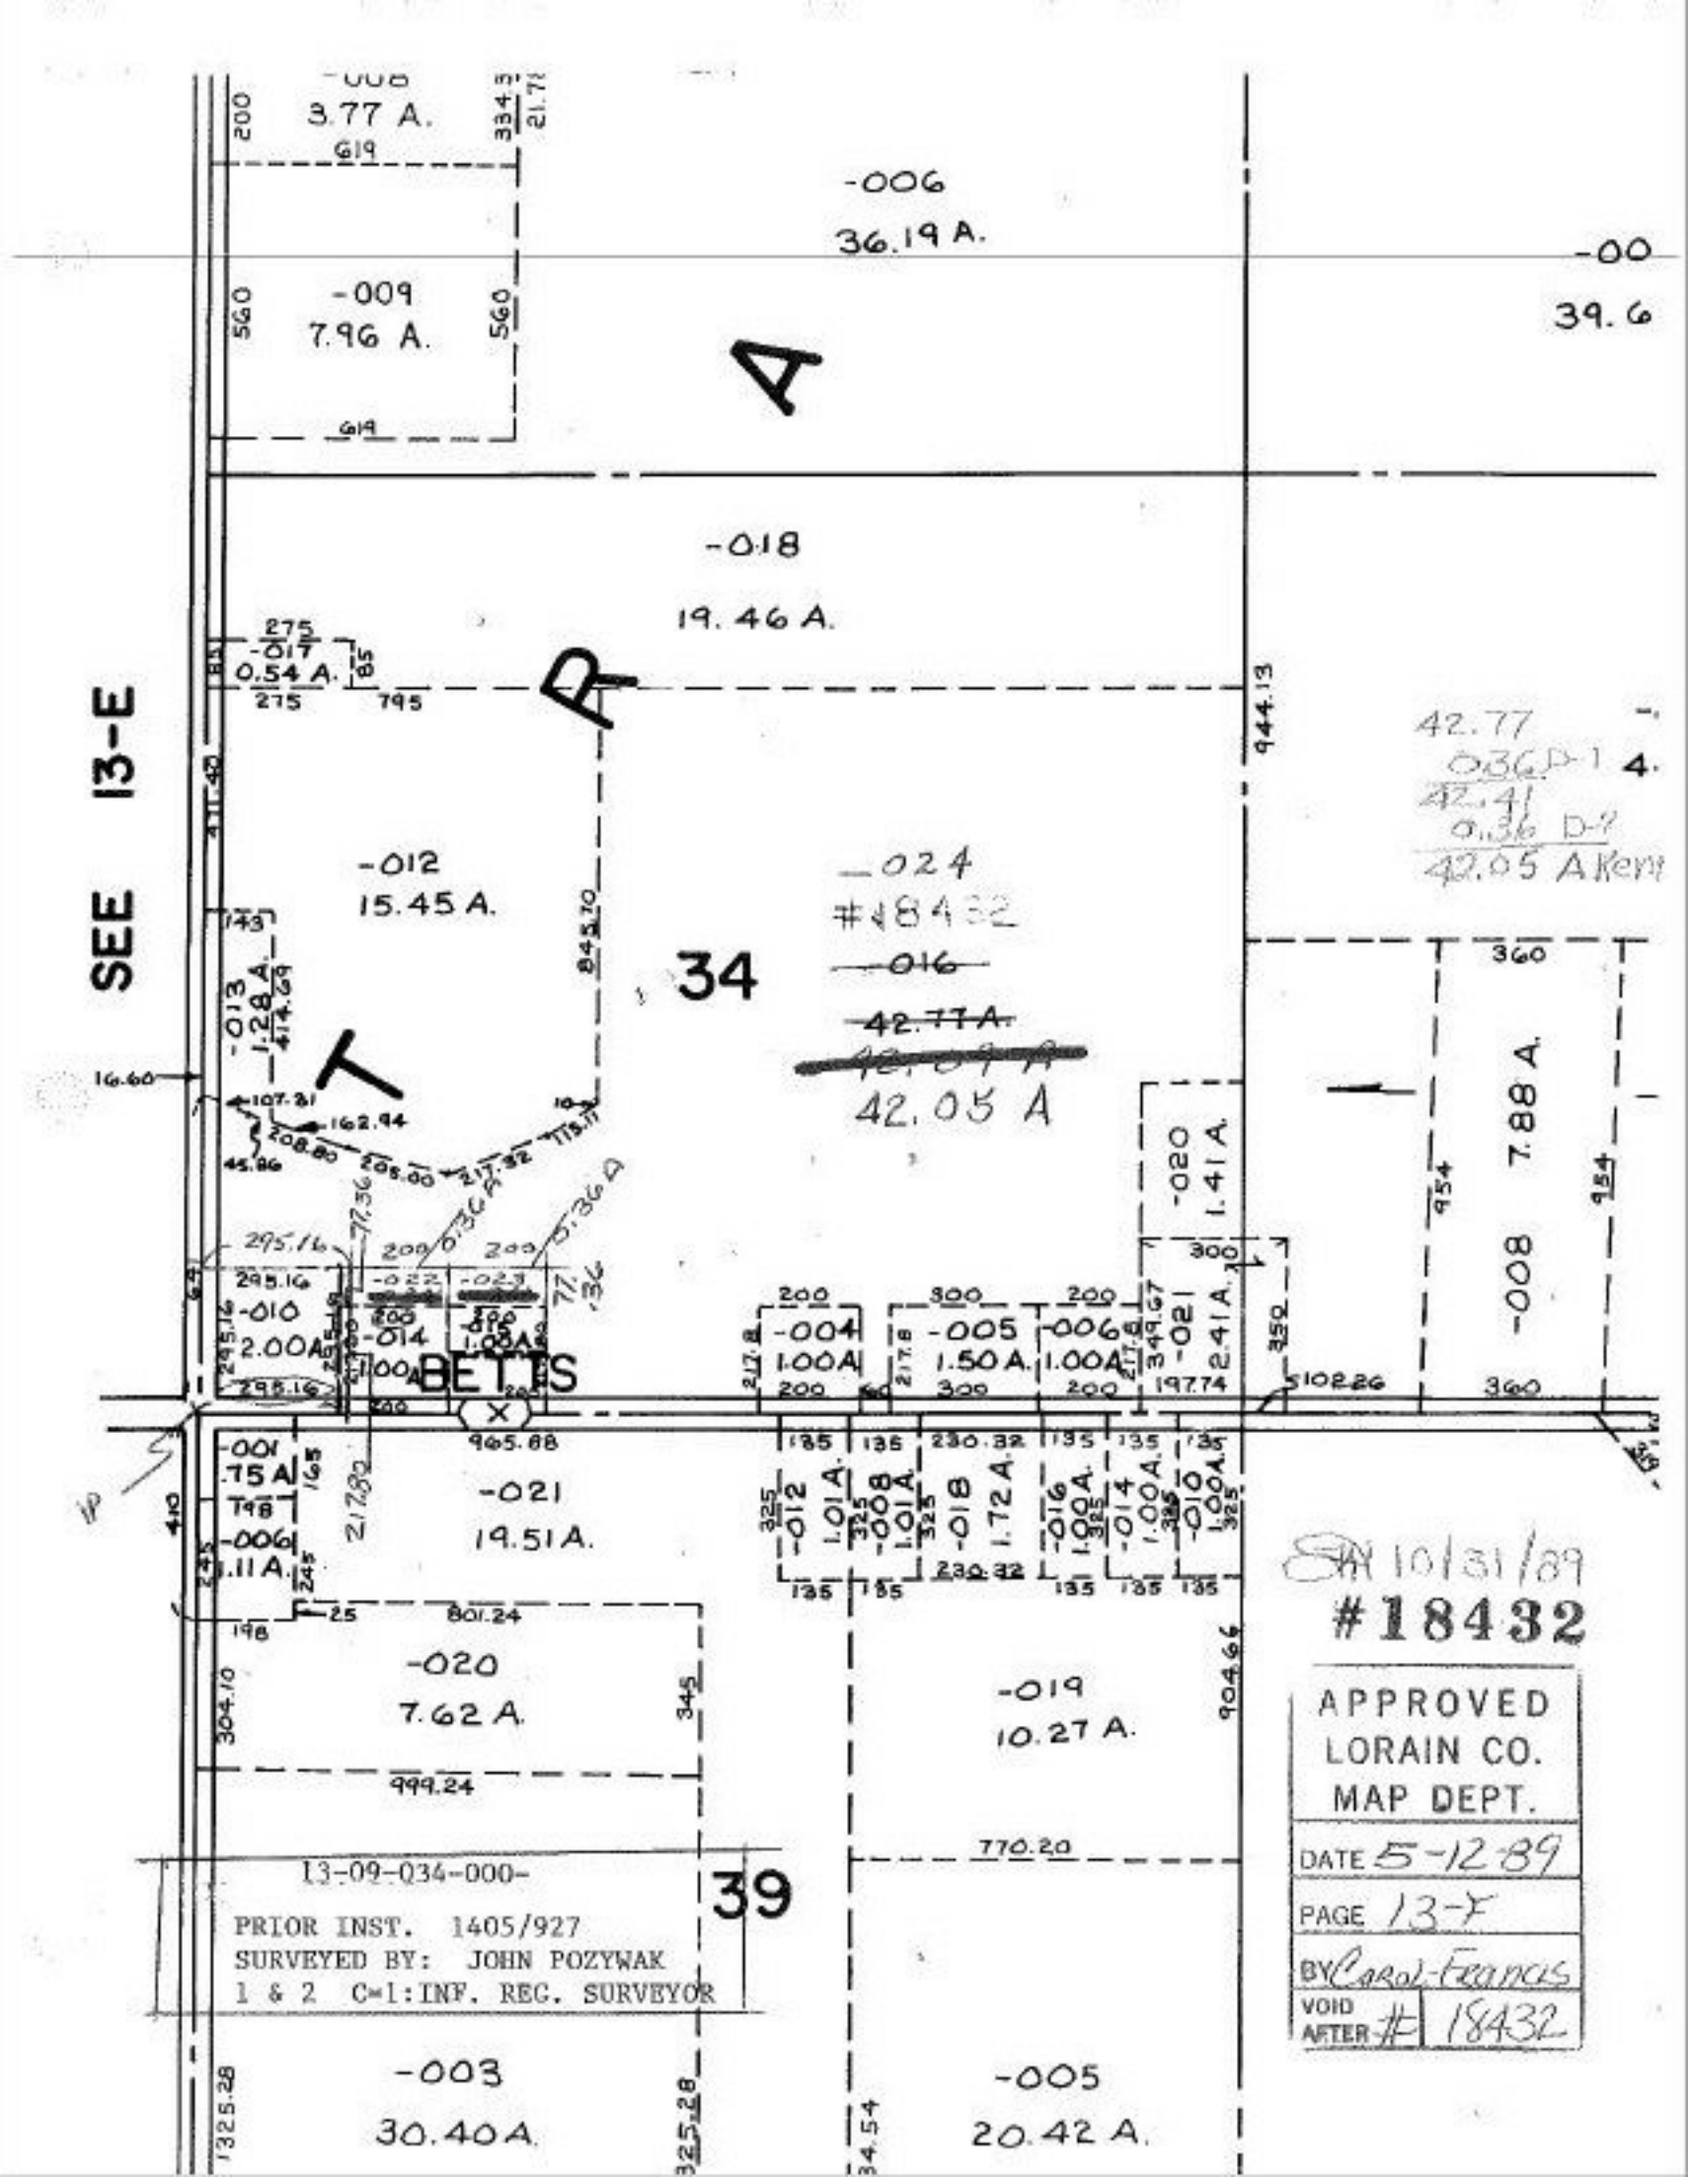

SEE 13-E
-008
3.77 A.
-006
36.19 A.
-009
7.96 A.
-00
39.6
-018
19.46 A.
-017
0.54 A.
-012
15.45 A.
-024
#18432
~~-016~~
~~42.77 A.~~
~~42.09 A~~
42.05 A
34
-013
1.28 A.
-020
1.41 A.
-021
2.41 A.
-008
7.88 A.
-010
2.00 A.
-014
1.00 A.
BETTS
-004
1.00 A.
-005
1.50 A.
-006
1.00 A.
-001
.75 A.
-006
1.11 A.
-021
19.51 A.
-012
1.01 A.
-008
1.01 A.
-018
1.72 A.
-016
1.00 A.
-014
1.00 A.
-010
1.00 A.
-020
7.62 A.
-019
10.27 A.
39
-003
30.40 A.
-005
20.42 A.
13-09-034-000-
PRIOR INST. 1405/927
SURVEYED BY: JOHN POZYWAK
1 & 2 C=1:INF. REG. SURVEYOR
10/31/89
#18432
APPROVED
LORAIN CO.
MAP DEPT.
DATE 5-12-89
PAGE 13-F
BY Carol Francis
VOID AFTER # 18432