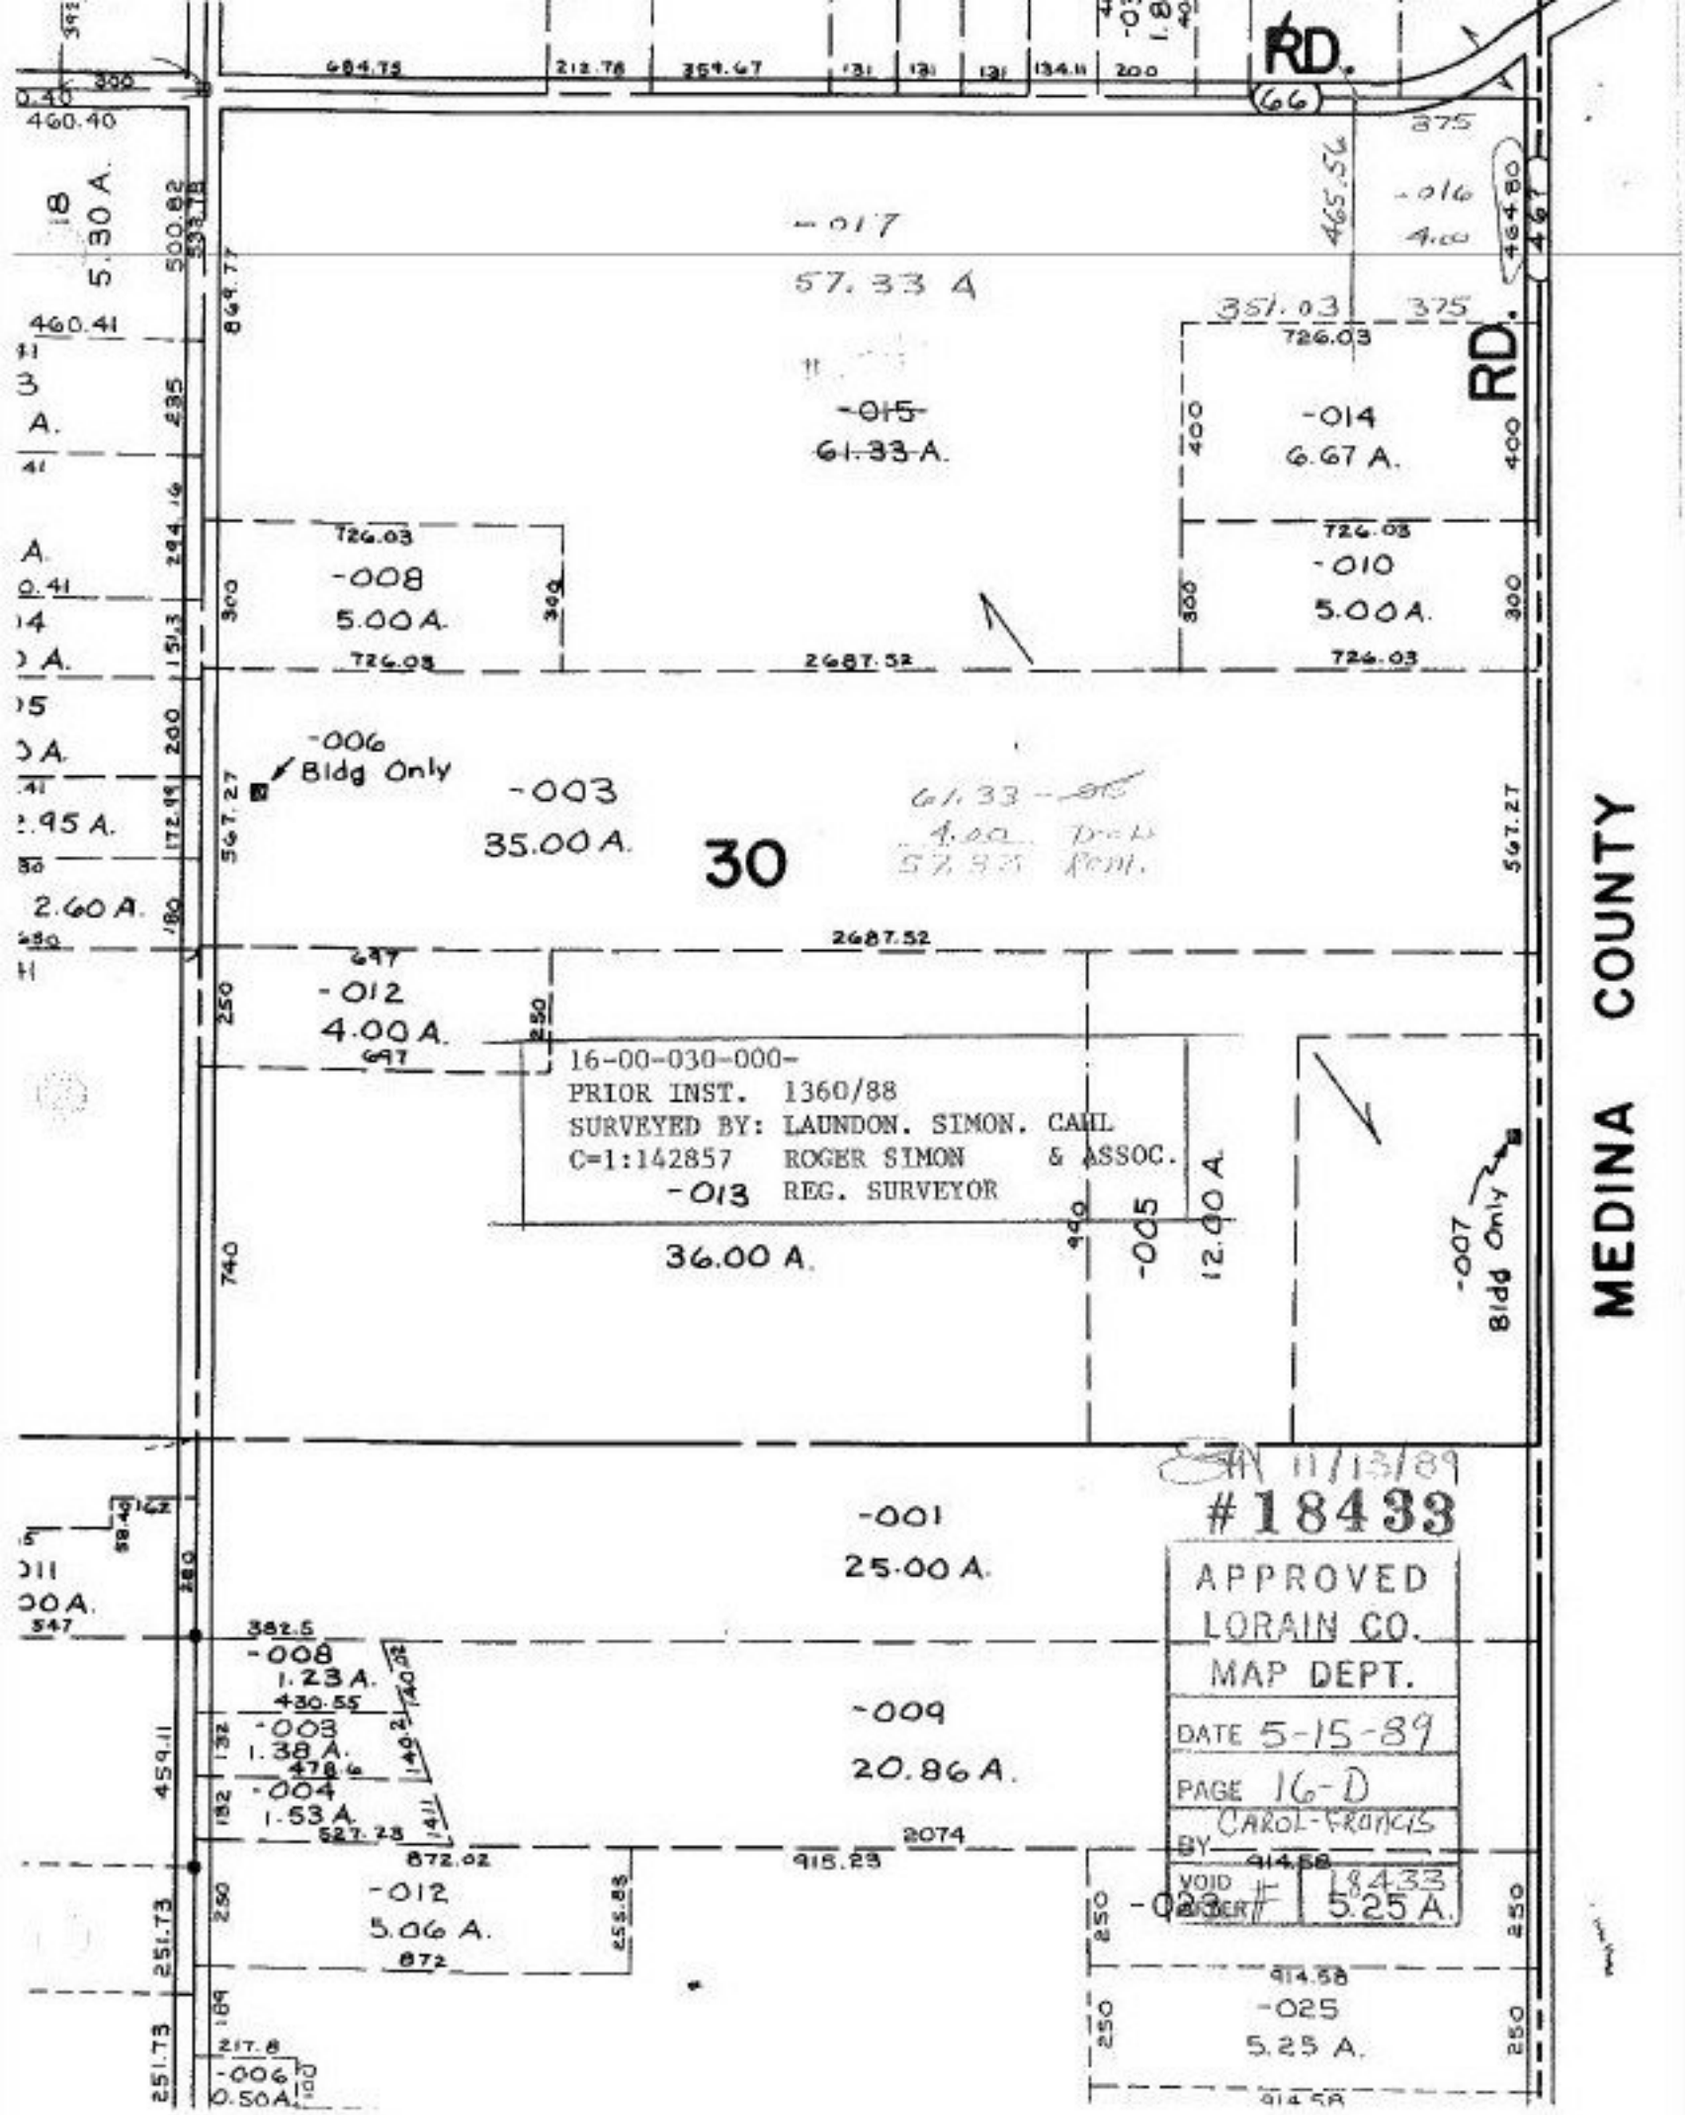
MEDINA COUNTY
RD.
RD.
-017
57.33 A
-015
61.33 A.
-014
6.67 A.
-008
5.00 A.
-010
5.00 A.
-006
Bldg Only
-003
35.00 A.
30
-012
4.00 A.
16-00-030-000-
PRIOR INST. 1360/88
SURVEYED BY: LAUNDON. SIMON. CAHL
C=1:142857 ROGER SIMON & ASSOC.
-013 REG. SURVEYOR
36.00 A.
-005
12.00 A.
-007
Bldg Only
-001
25.00 A.
-009
20.86 A.
-008
1.23 A.
-003
1.38 A.
-004
1.53 A.
-012
5.06 A.
-006
0.50 A.
-023
5.25 A.
-025
5.25 A.
#18433
APPROVED
LORAIN CO.
MAP DEPT.
DATE 5-15-89
PAGE 16-D
BY CAROL-FRANCIS
VOID ORDER #
L8433