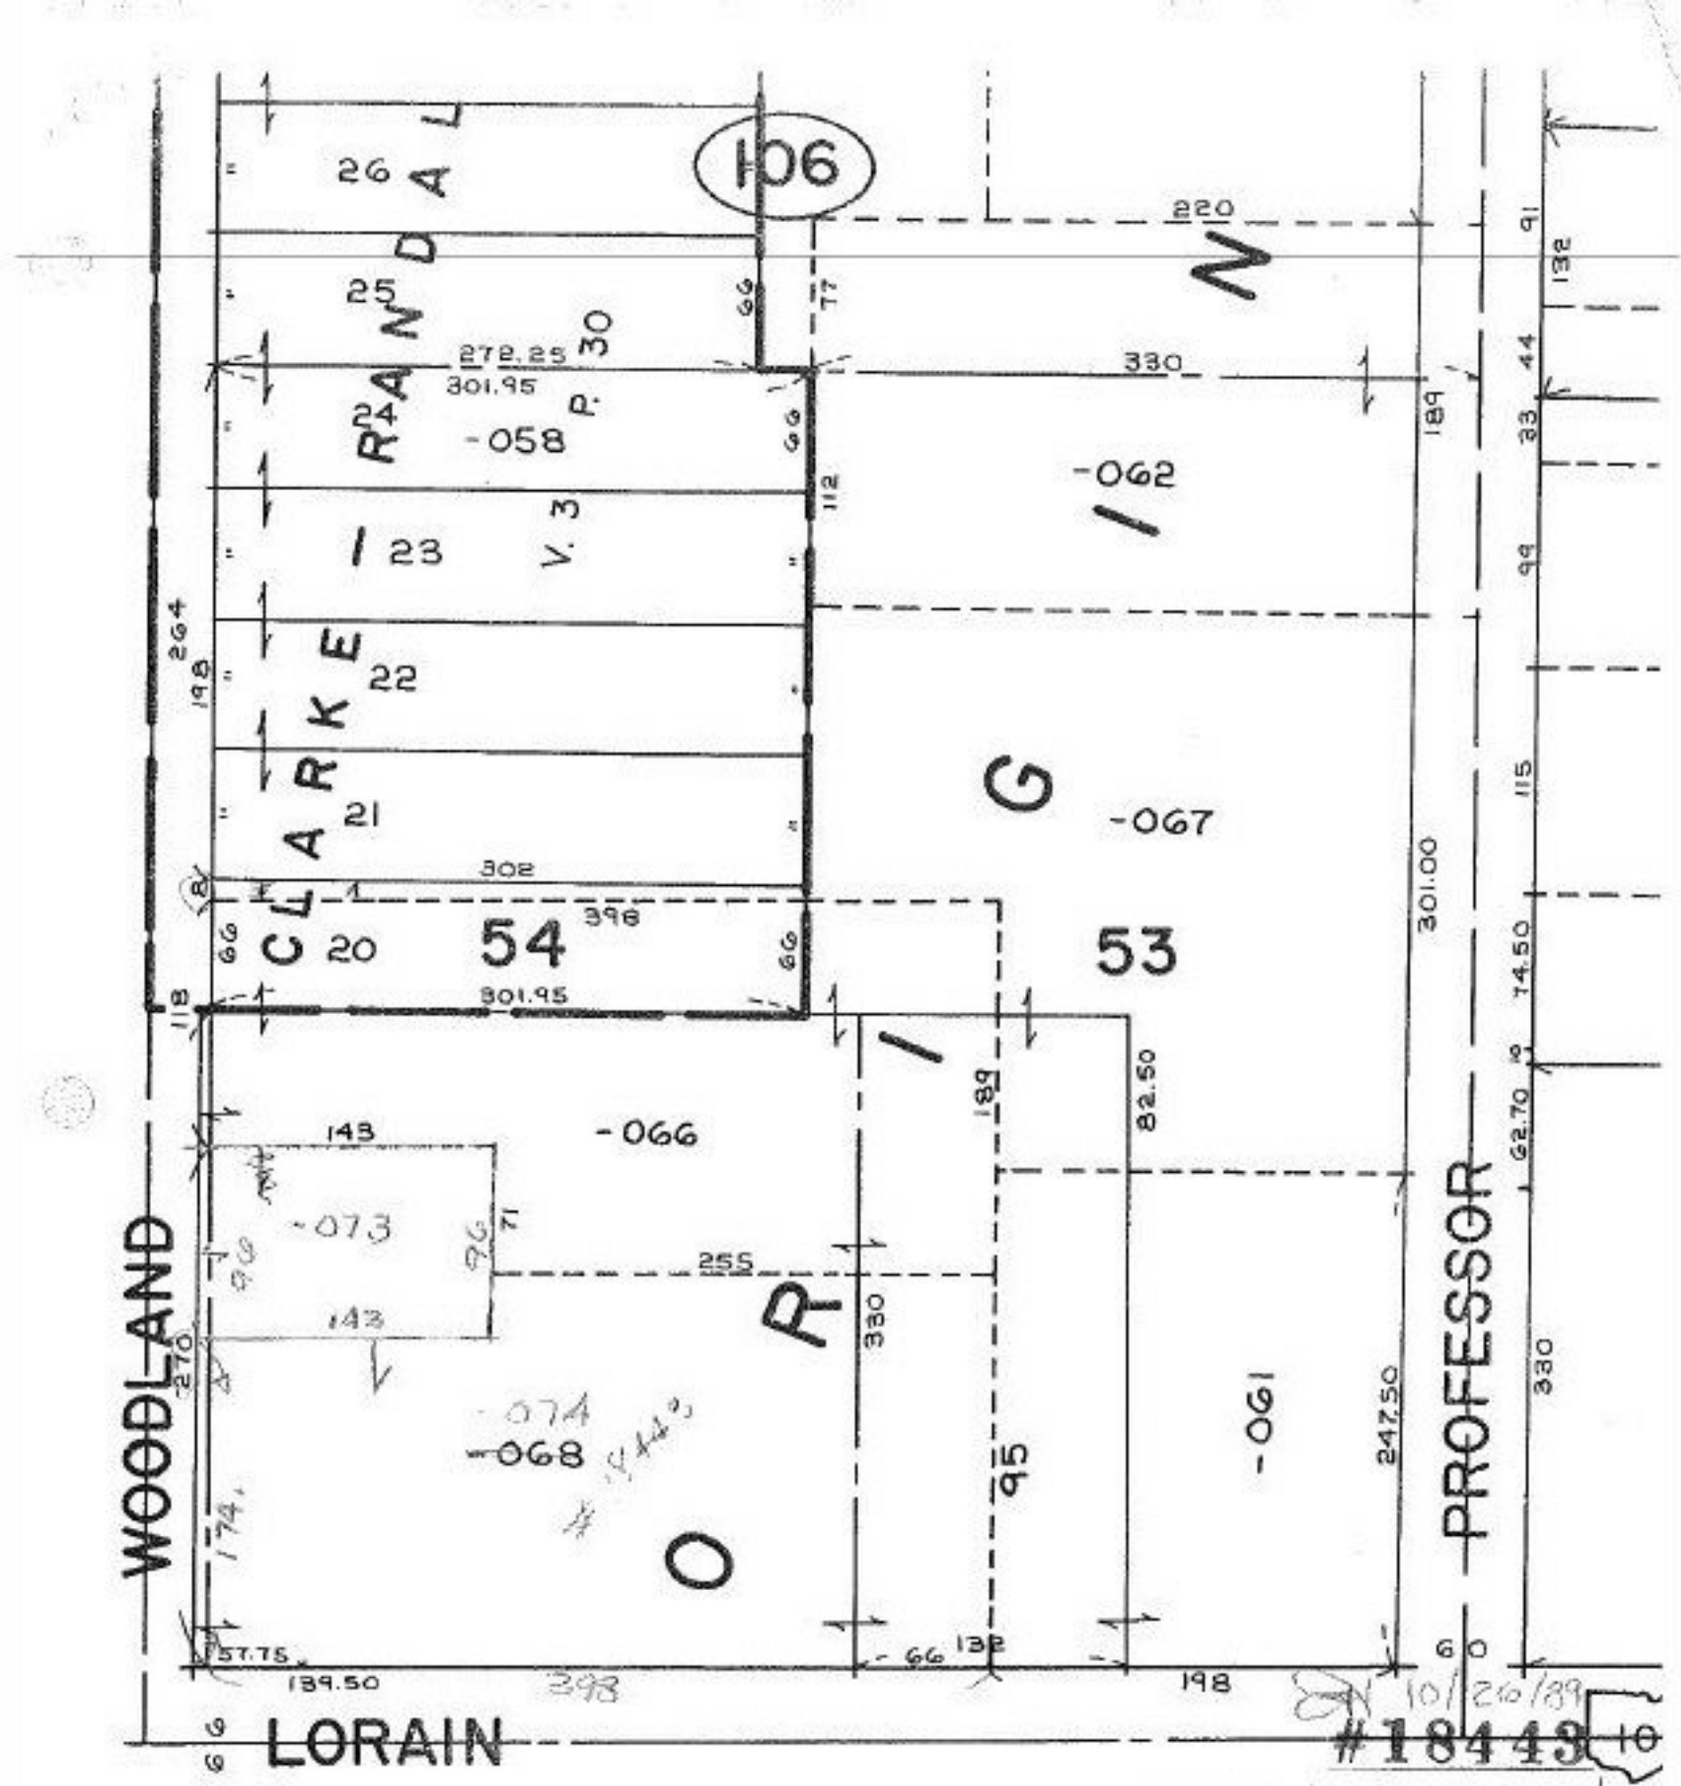

09-00-075-106-
PRIOR INST. 92/946

LORAIN CO.
MAP DEPT.
DATE 5-17-89
PAGE 9-00-075-B
BY CAROL FRANCIS
VOID AFTER # 18443