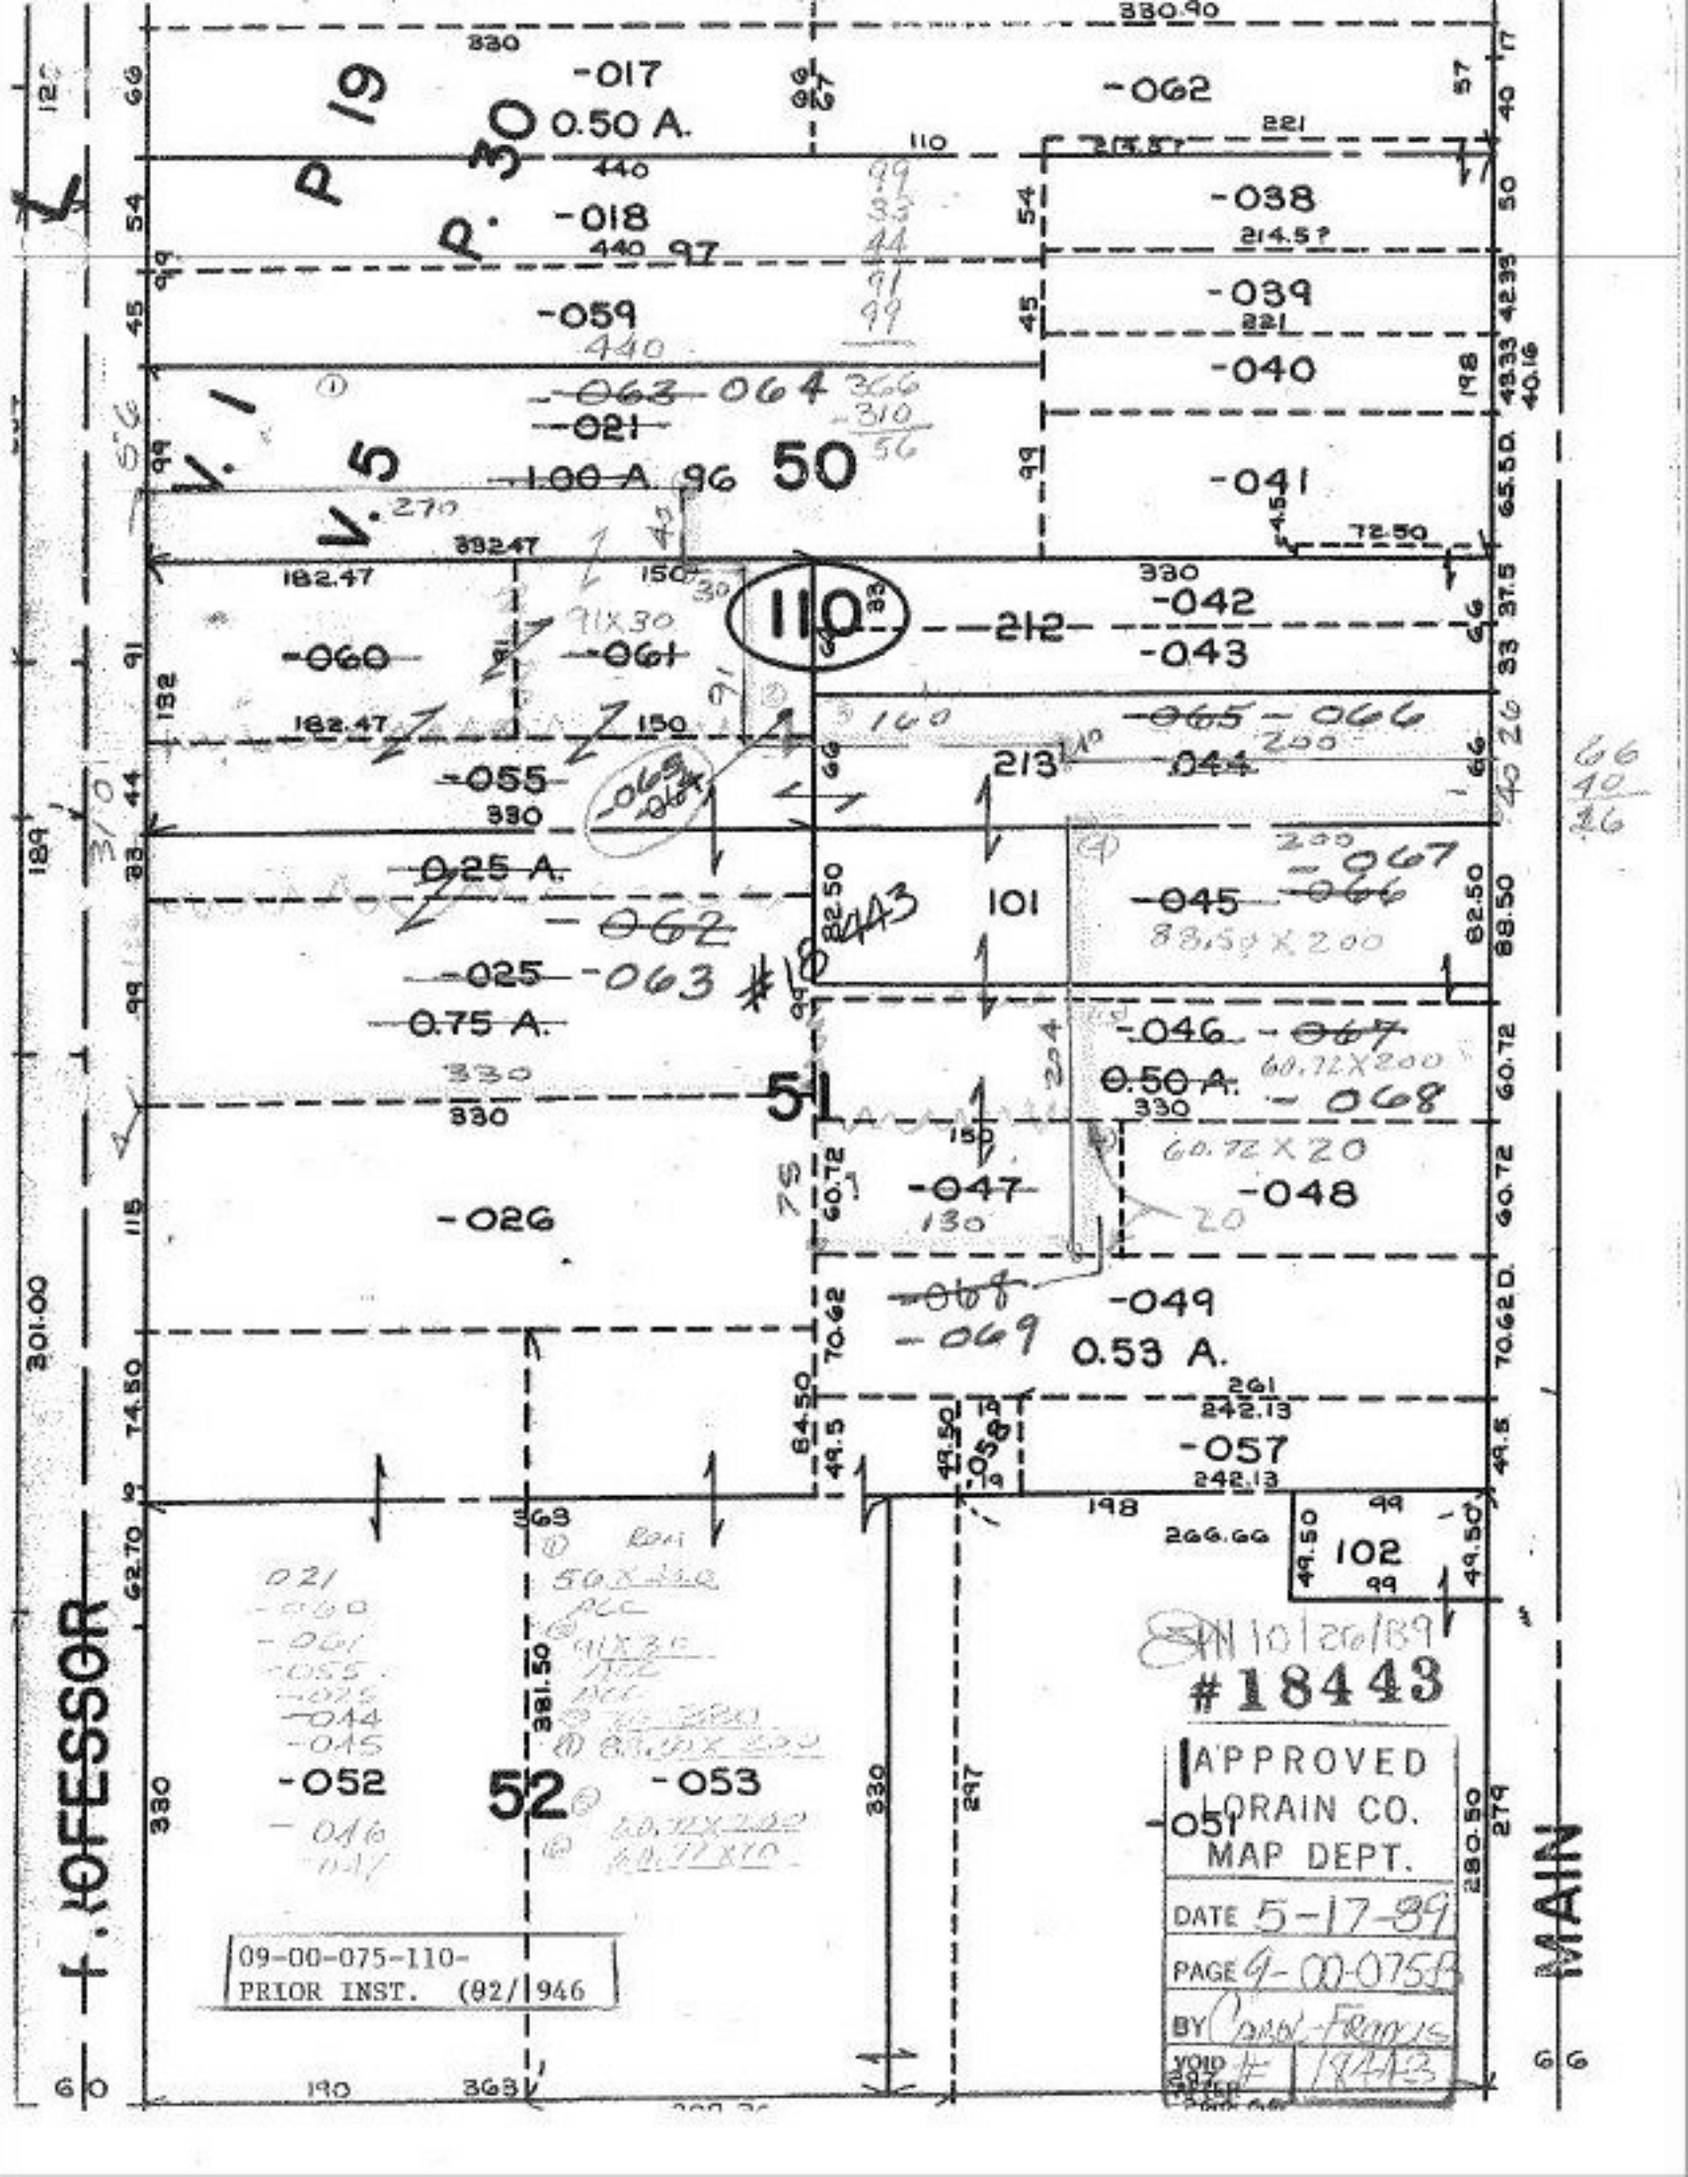

PROFESSOR
MAIN
P 19
P. 30
V. 1
V. 5
-017
0.50 A.
-062
-018
-038
-059
-039
-040
-063 064
-021
1.00 A.
50
-041
110
-042
-060
-061
-212
-043
-065 -066
-055
213
-044
0.25 A.
-067
-062
101
-045
-025 -063
0.75 A.
-046 -067
0.50 A.
-068
51
-047
-048
-026
-068
-049
-069
0.53 A.
-057
102
-052
52
-053
-051
#18443
APPROVED
LORAIN CO.
MAP DEPT.
DATE 5-17-89
PAGE 9-00-075B
BY Carol Francis
VOID # 18443
09-00-075-110-
PRIOR INST. (82/946