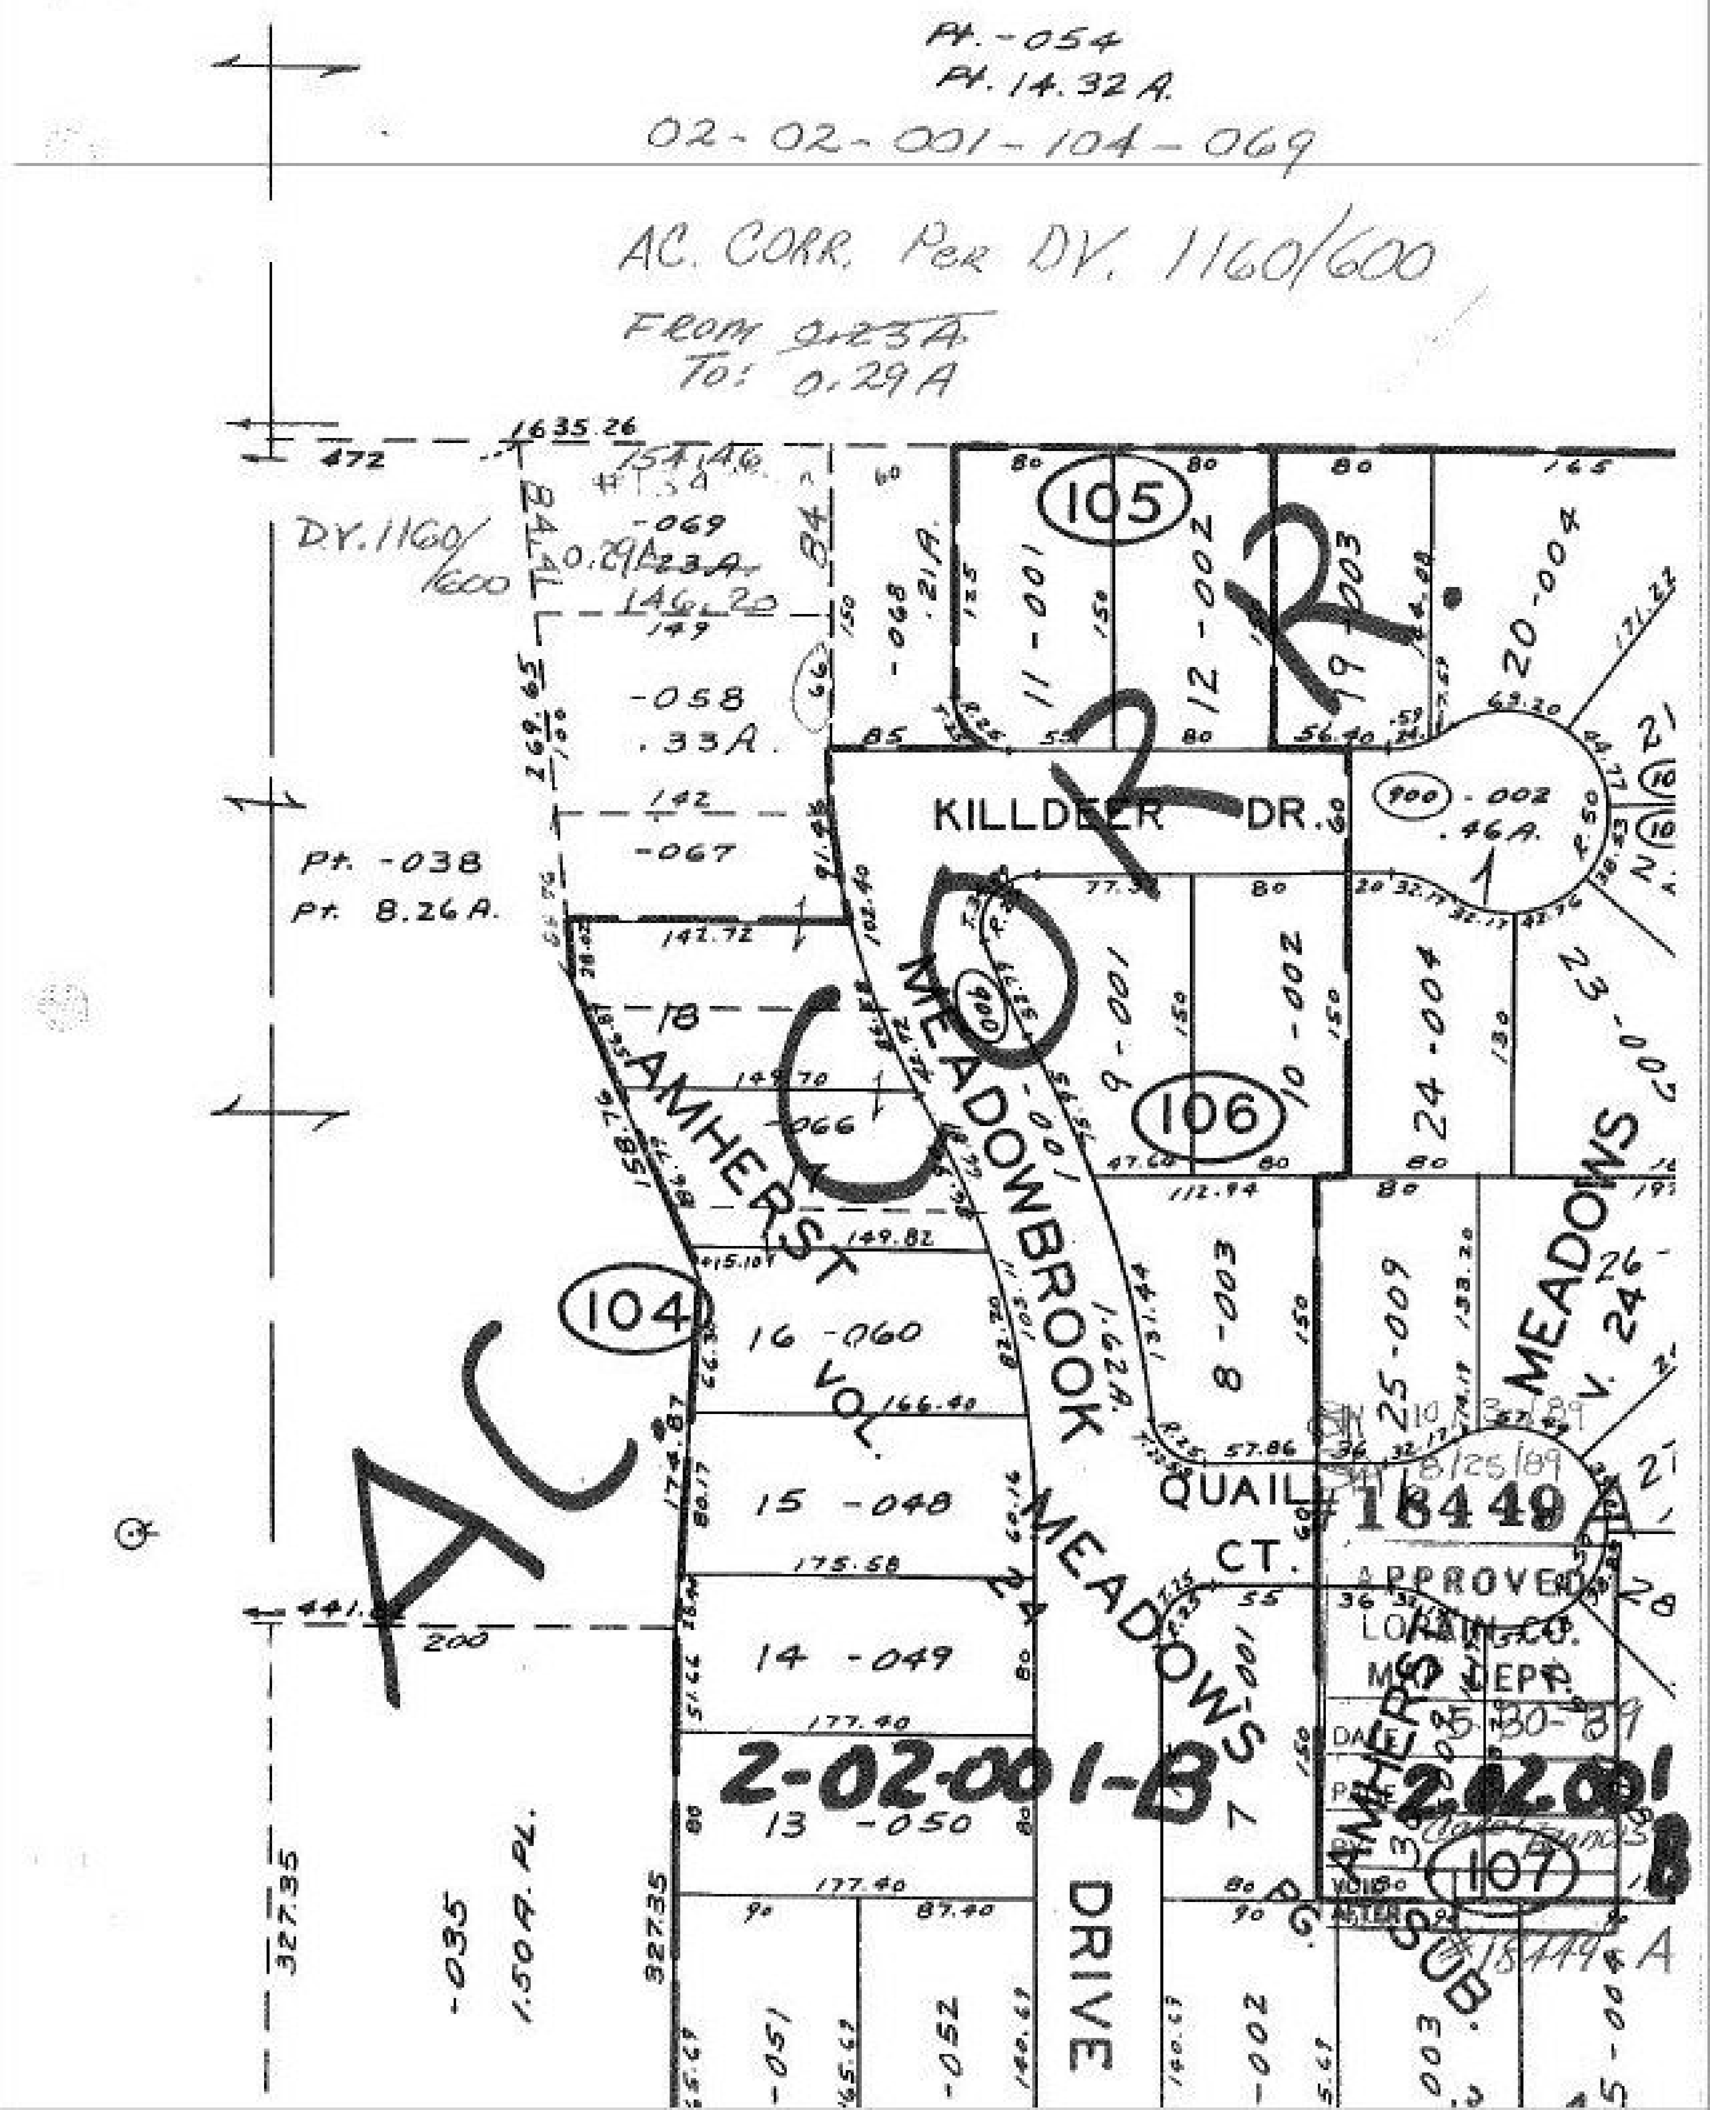
Pt. -054
Pt. 14.32 A.
02-02-001-104-069
AC. CORR. Per DV. 1160/600
FROM 0.23A
To: 0.29A
1635.26
472
DY. 1160/600
-069
0.29A
146.20
149
-058
.33A.
142
-067
Pt. -038
Pt. 8.26A.
142.72
18
149.70
-066
149.82
105
11-001
12-002
19-003
20-004
KILLDEER DR.
900
-002
.46A.
106
9-001
10-002
24-004
23-007
MEADOWBROOK
1.62A.
MEADOWS
104
AMHERST
VOL.
16 -060
15 -048
14 -049
13 -050
441.
200
327.35
-035
1.50A. PL.
8-003
25-009
QUAIL CT.
#18449
APPROVED
LORAIN CO.
MAP DEPT.
DATE 5-30-89
2-02-001-B
2-02-001-B
107
MEADOWS 7
AMHERST SUB.
DRIVE
-051
-052
-002
-003
18449 A
AC
CR