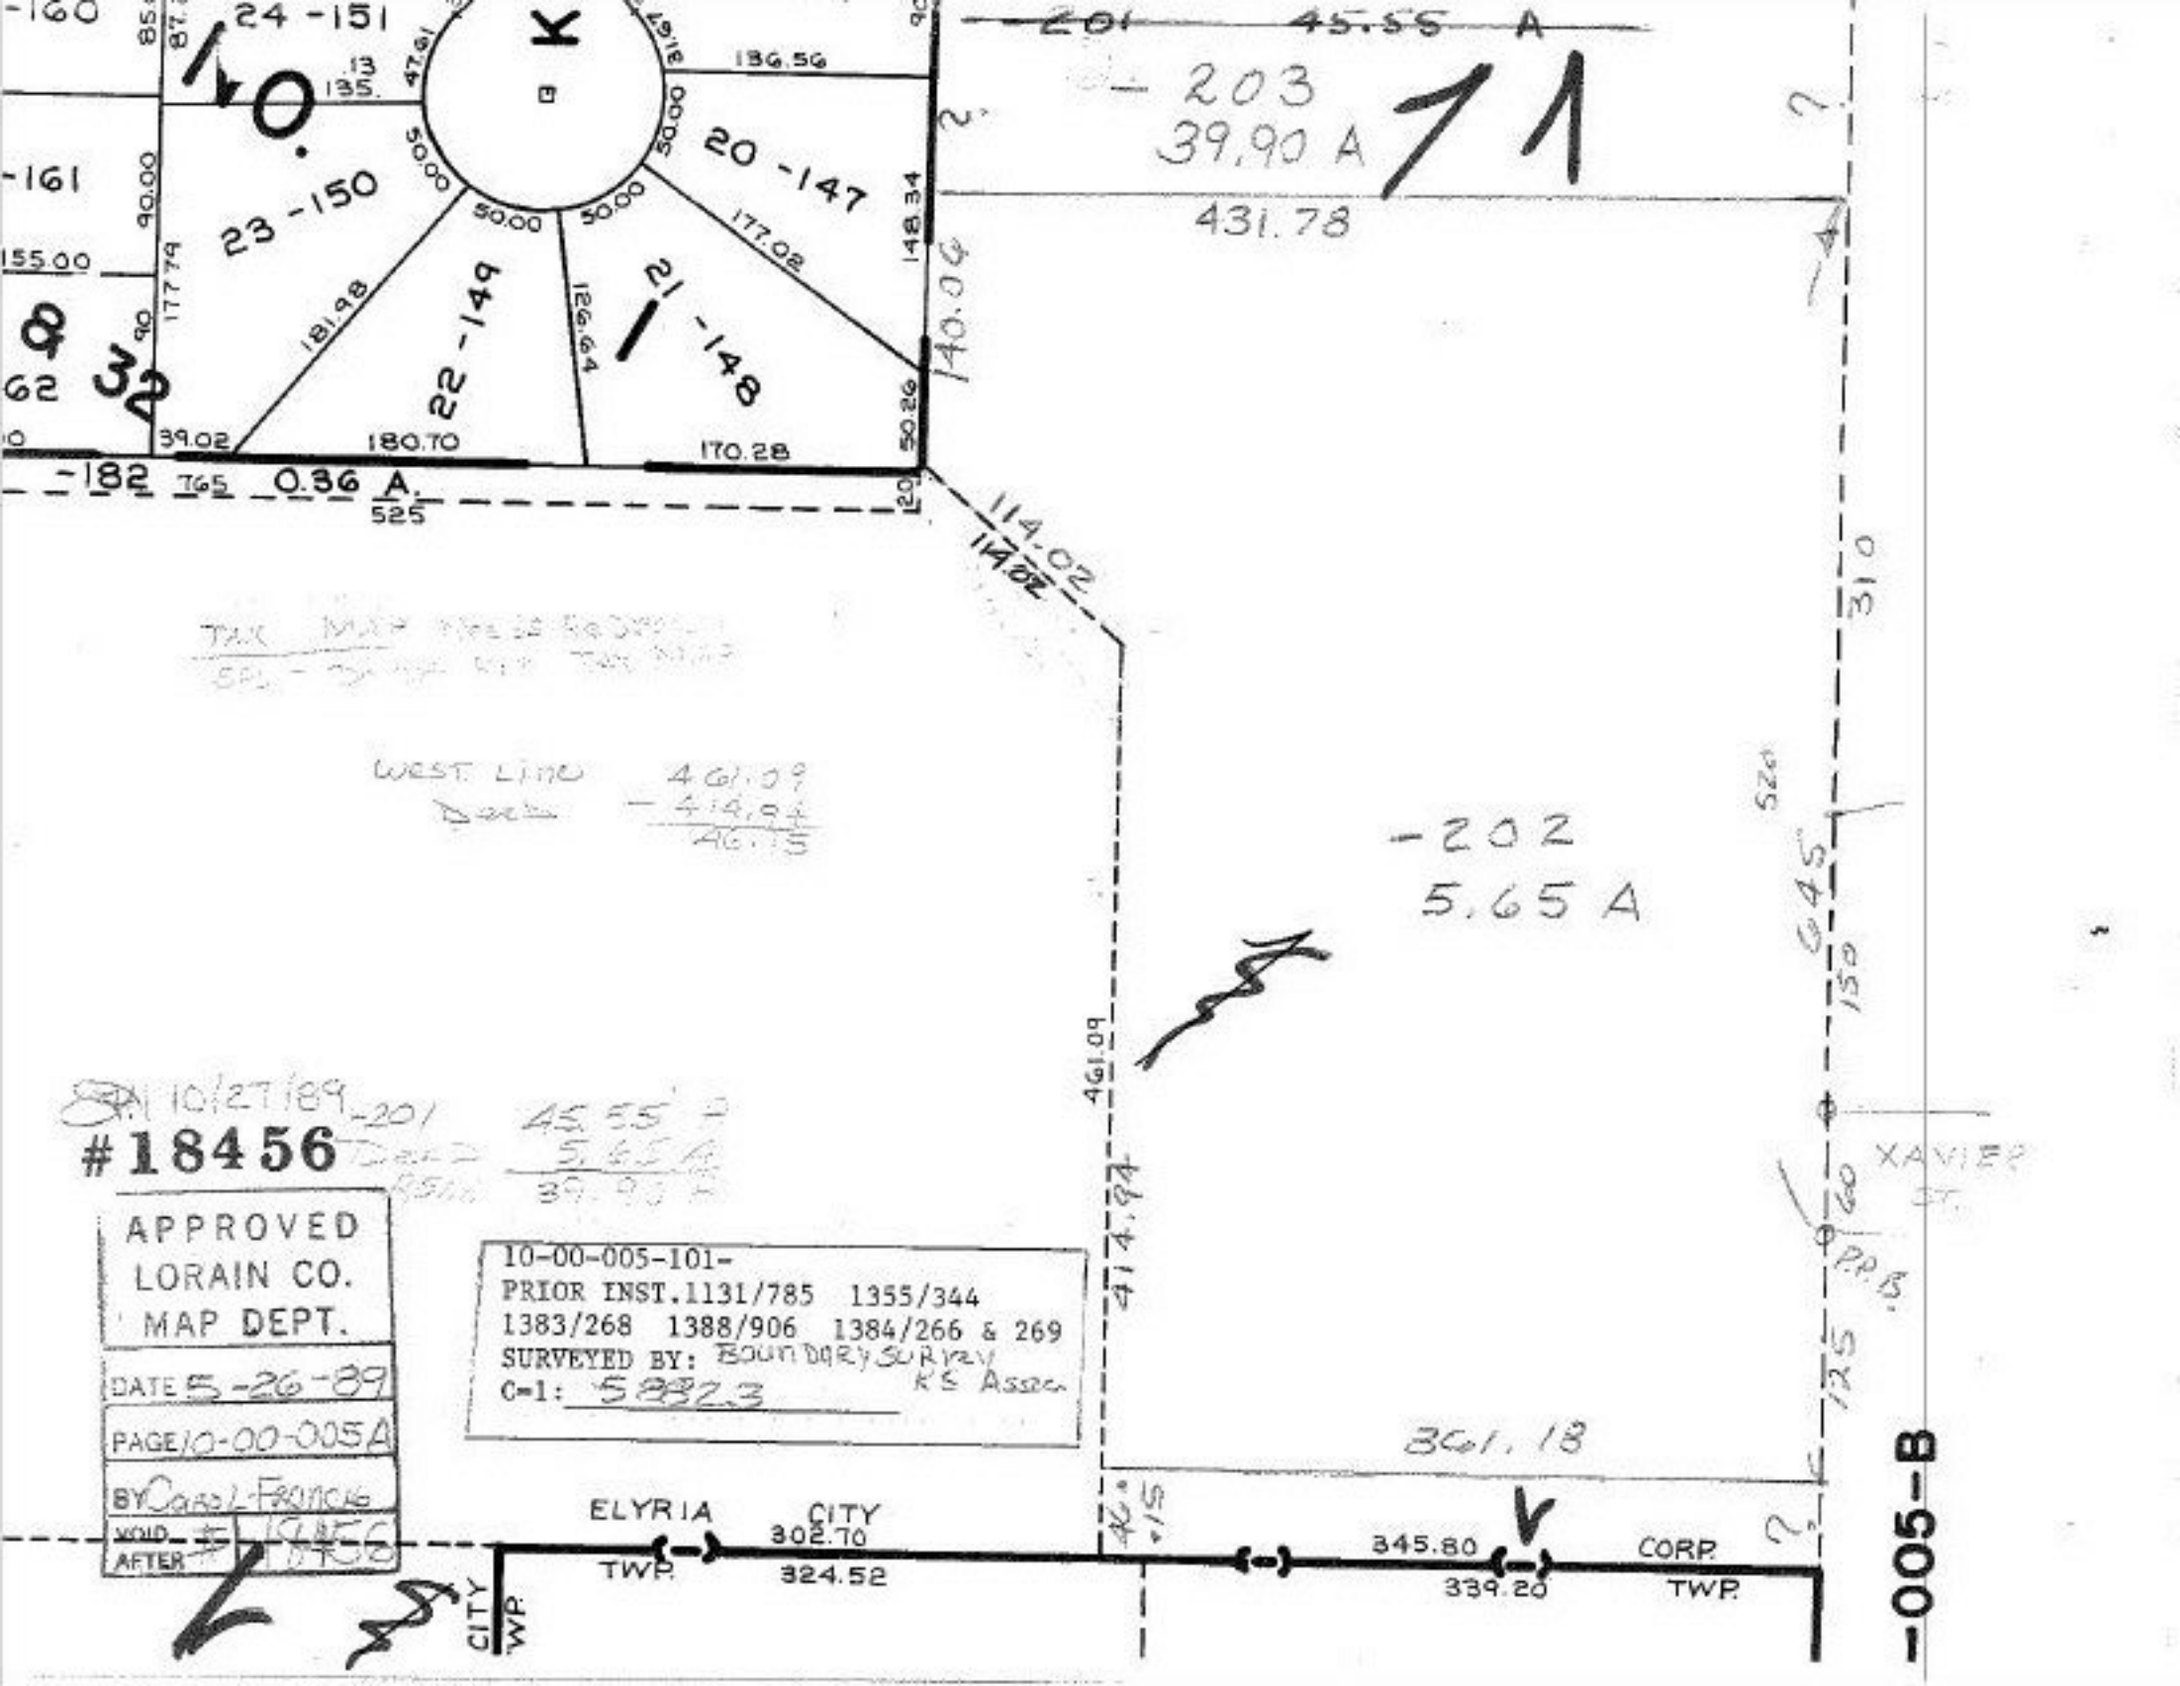
24 -151
-160
-161
155.00
90.00
177.79
135.
13
47.61
87.
85
90
90.00
50.00
50.00
50.00
50.00
50.00
50.00
136.56
148.34
177.02
126.64
181.98
39.02
180.70
170.28
50.26
140.06
431.78
-203
39.90 A
71
-201
45.55 A
23 -150
20 -147
22 -149
21 -148
-182
165
0.36 A.
525
120
114.02
114.02
461.09
414.94
-202
5.65 A
520
645
310
150
125
60
XAVIER
ST.
P.P.
361.18
345.80
339.20
CORP
TWP.
ELYRIA
CITY
TWP.
302.70
324.52
CITY
TWP.
-005-B
#18456
APPROVED
LORAIN CO.
MAP DEPT.
DATE 5-26-89
PAGE 10-00-005A
BY Carol Francis
VOID AFTER #
10-00-005-101-
PRIOR INST. 1131/785 1355/344
1383/268 1388/906 1384/266 & 269
SURVEYED BY: Boundary Survey KS Assoc
C-1: 5882.3