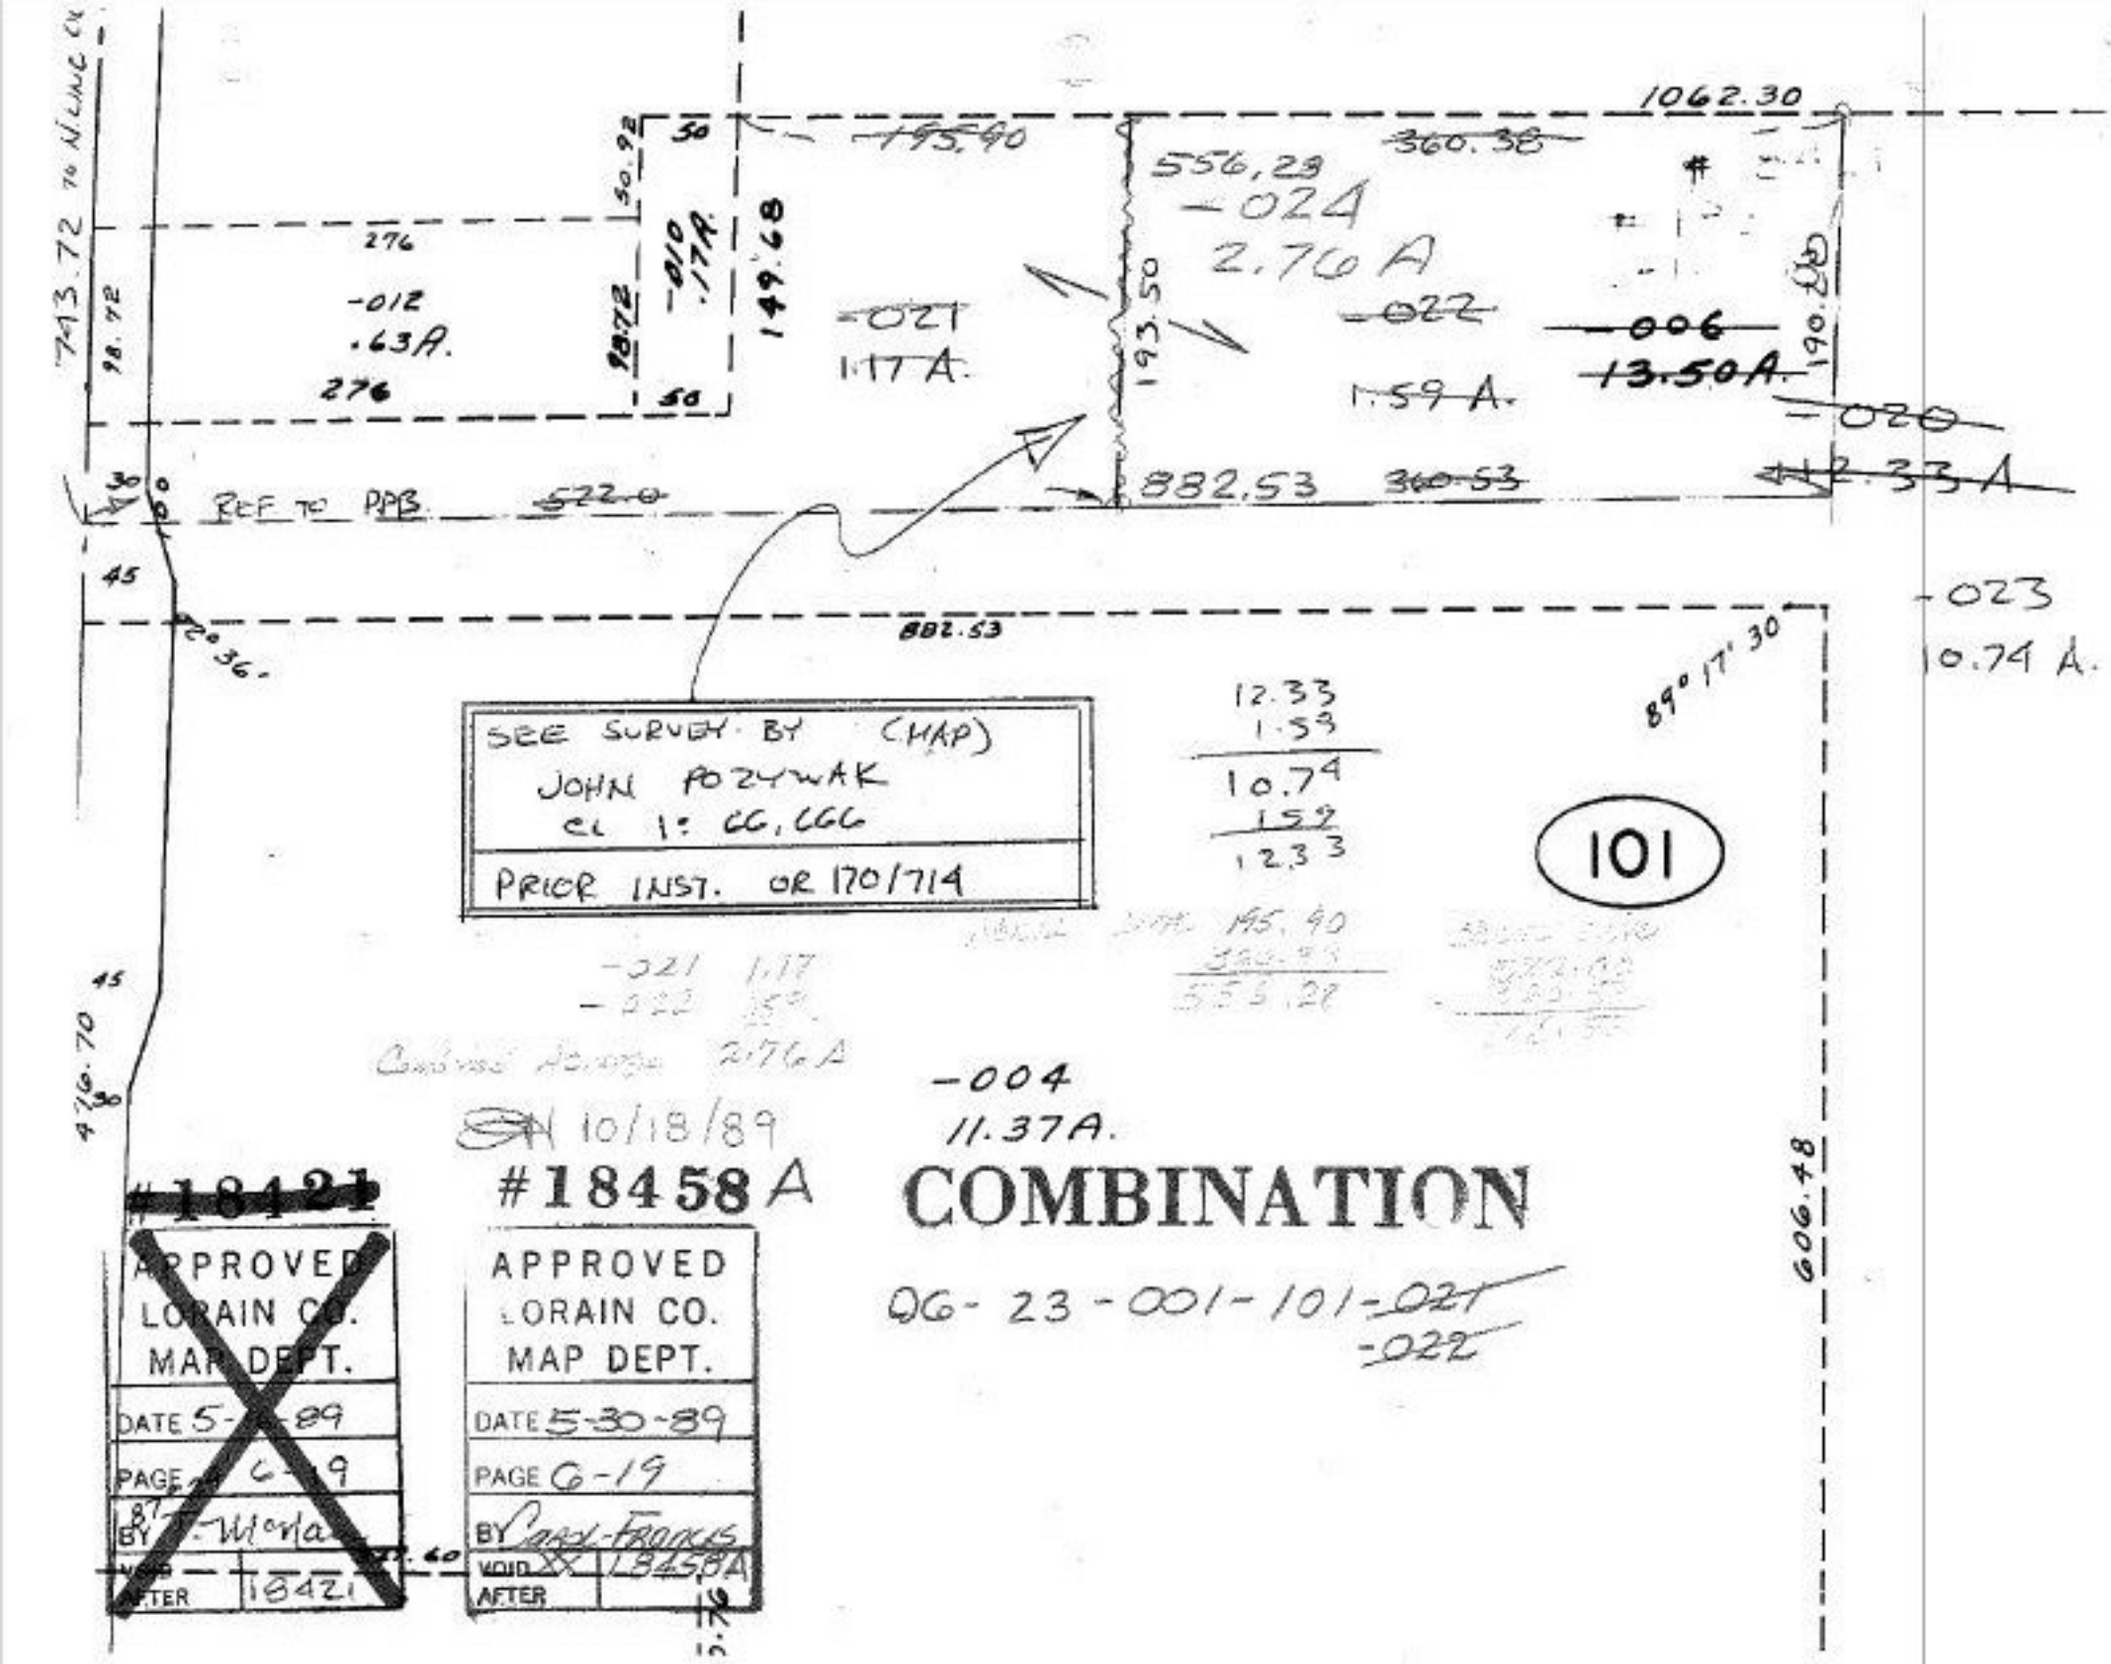

1062.30
195.90
360.38
556.28
-024
2.76 A
276
-012
.63A.
276
-010
.17A.
149.68
-021
1.17 A.
193.50
-022
1.59 A.
-006
13.50A.
190.20
-020
12.33 A
882.53
360.53
REF TO PPB
522.0
882.53
-023
10.74 A.
89° 17' 30
SEE SURVEY BY (MAP)
JOHN POZYWAK
CL 1: 66,666
PRIOR INST. OR 170/714
12.33
1.59
10.74
1.59
12.33
101
-021 1.17
-022 1.59
Combined Acreage 2.76 A
-004
11.37A.
10/18/89
#18421
APPROVED
LORAIN CO.
MAP DEPT.
DATE 5-[illegible]-89
PAGE 6-19
BY
VOID
AFTER 18421
#18458 A
APPROVED
LORAIN CO.
MAP DEPT.
DATE 5-30-89
PAGE 6-19
BY Carol Francis
VOID XX 18458A
AFTER
COMBINATION
06-23-001-101-021
-022
606.48