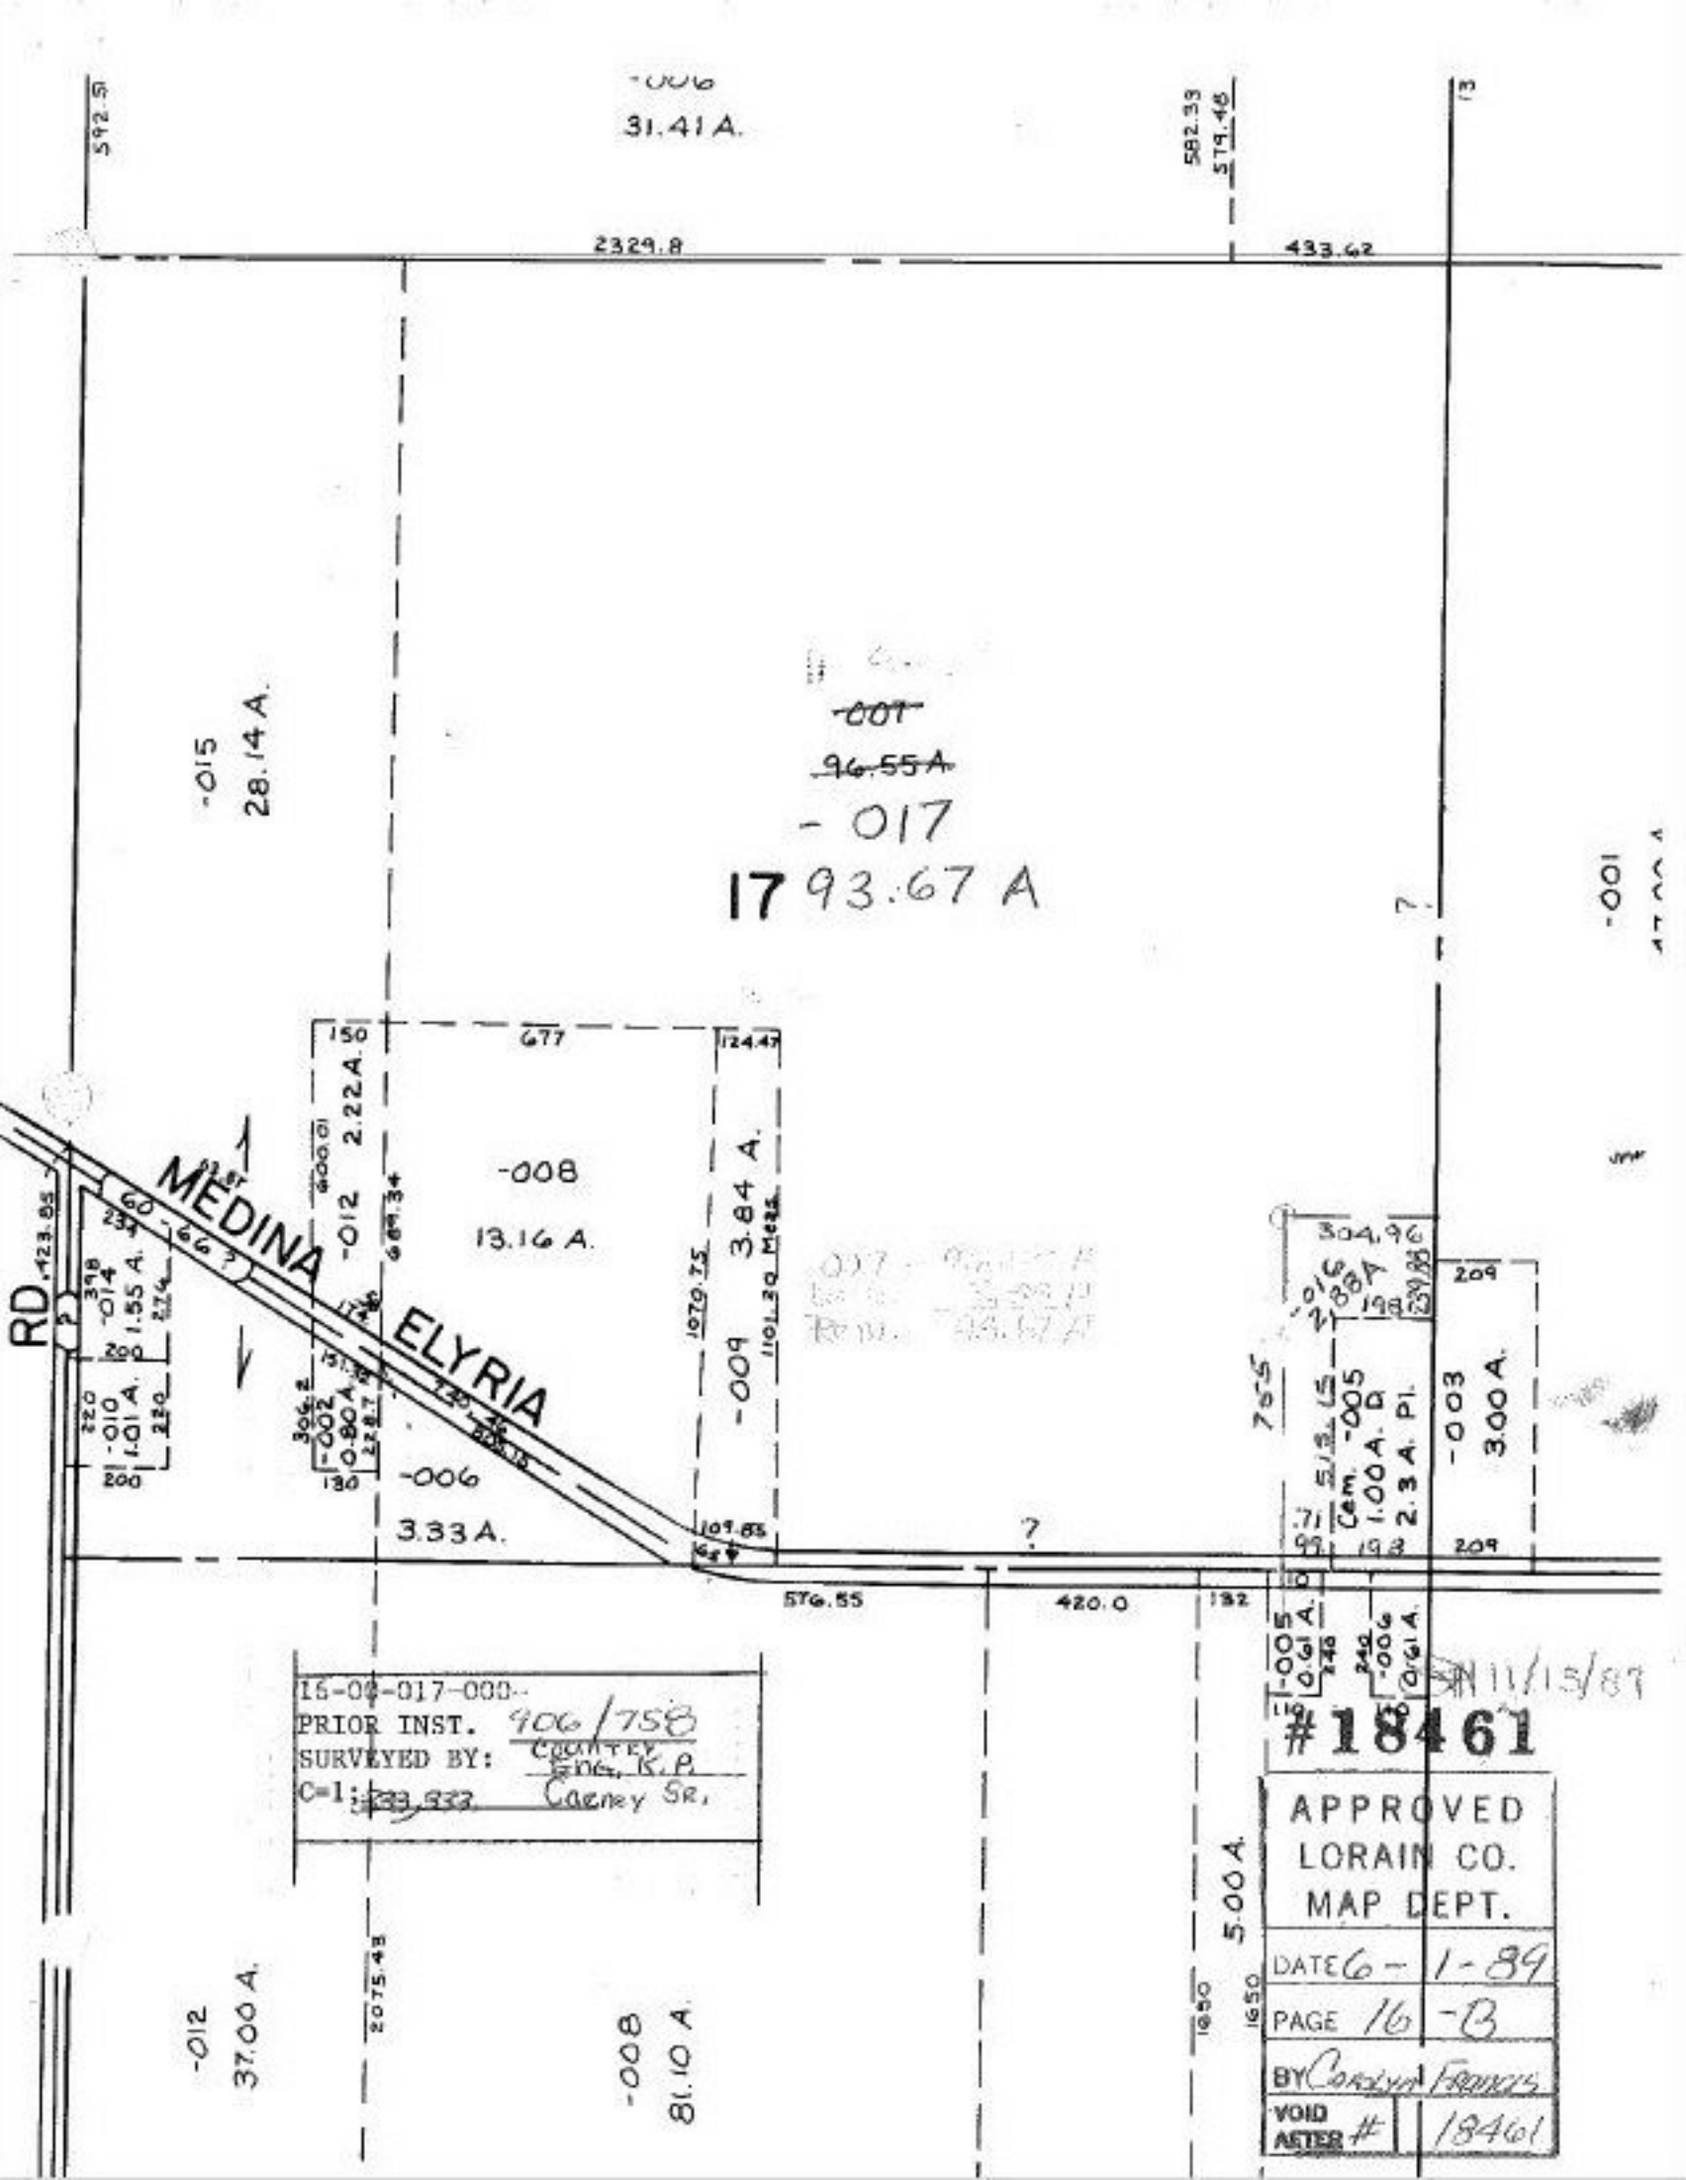

-006
31.41 A.
592.51
582.33
579.48
2329.8
433.62
-015
28.14 A.
~~-007~~
~~96.55 A.~~
-017
17 93.67 A
-001
-008
13.16 A.
-012
2.22 A.
-009
3.84 A.
MEDINA
ELYRIA
RD.
-014
1.55 A.
-010
1.01 A.
-002
0.80 A.
-006
3.33 A.
304.96
-005
1.00 A. D.
2.3 A. Pl.
-003
3.00 A.
576.55
420.0
-005
0.61 A.
-006
0.61 A.
5.00 A.
-012
37.00 A.
-008
81.10 A.
2075.43
15-00-017-000-
PRIOR INST. 906/758
SURVEYED BY: Country Eng. K.P.
C=1: 333,933 Carney Sr.
#18461
APPROVED
LORAIN CO.
MAP DEPT.
DATE 6-1-89
PAGE 16-B
BY Carolyn Francis
VOID AFTER # 18461