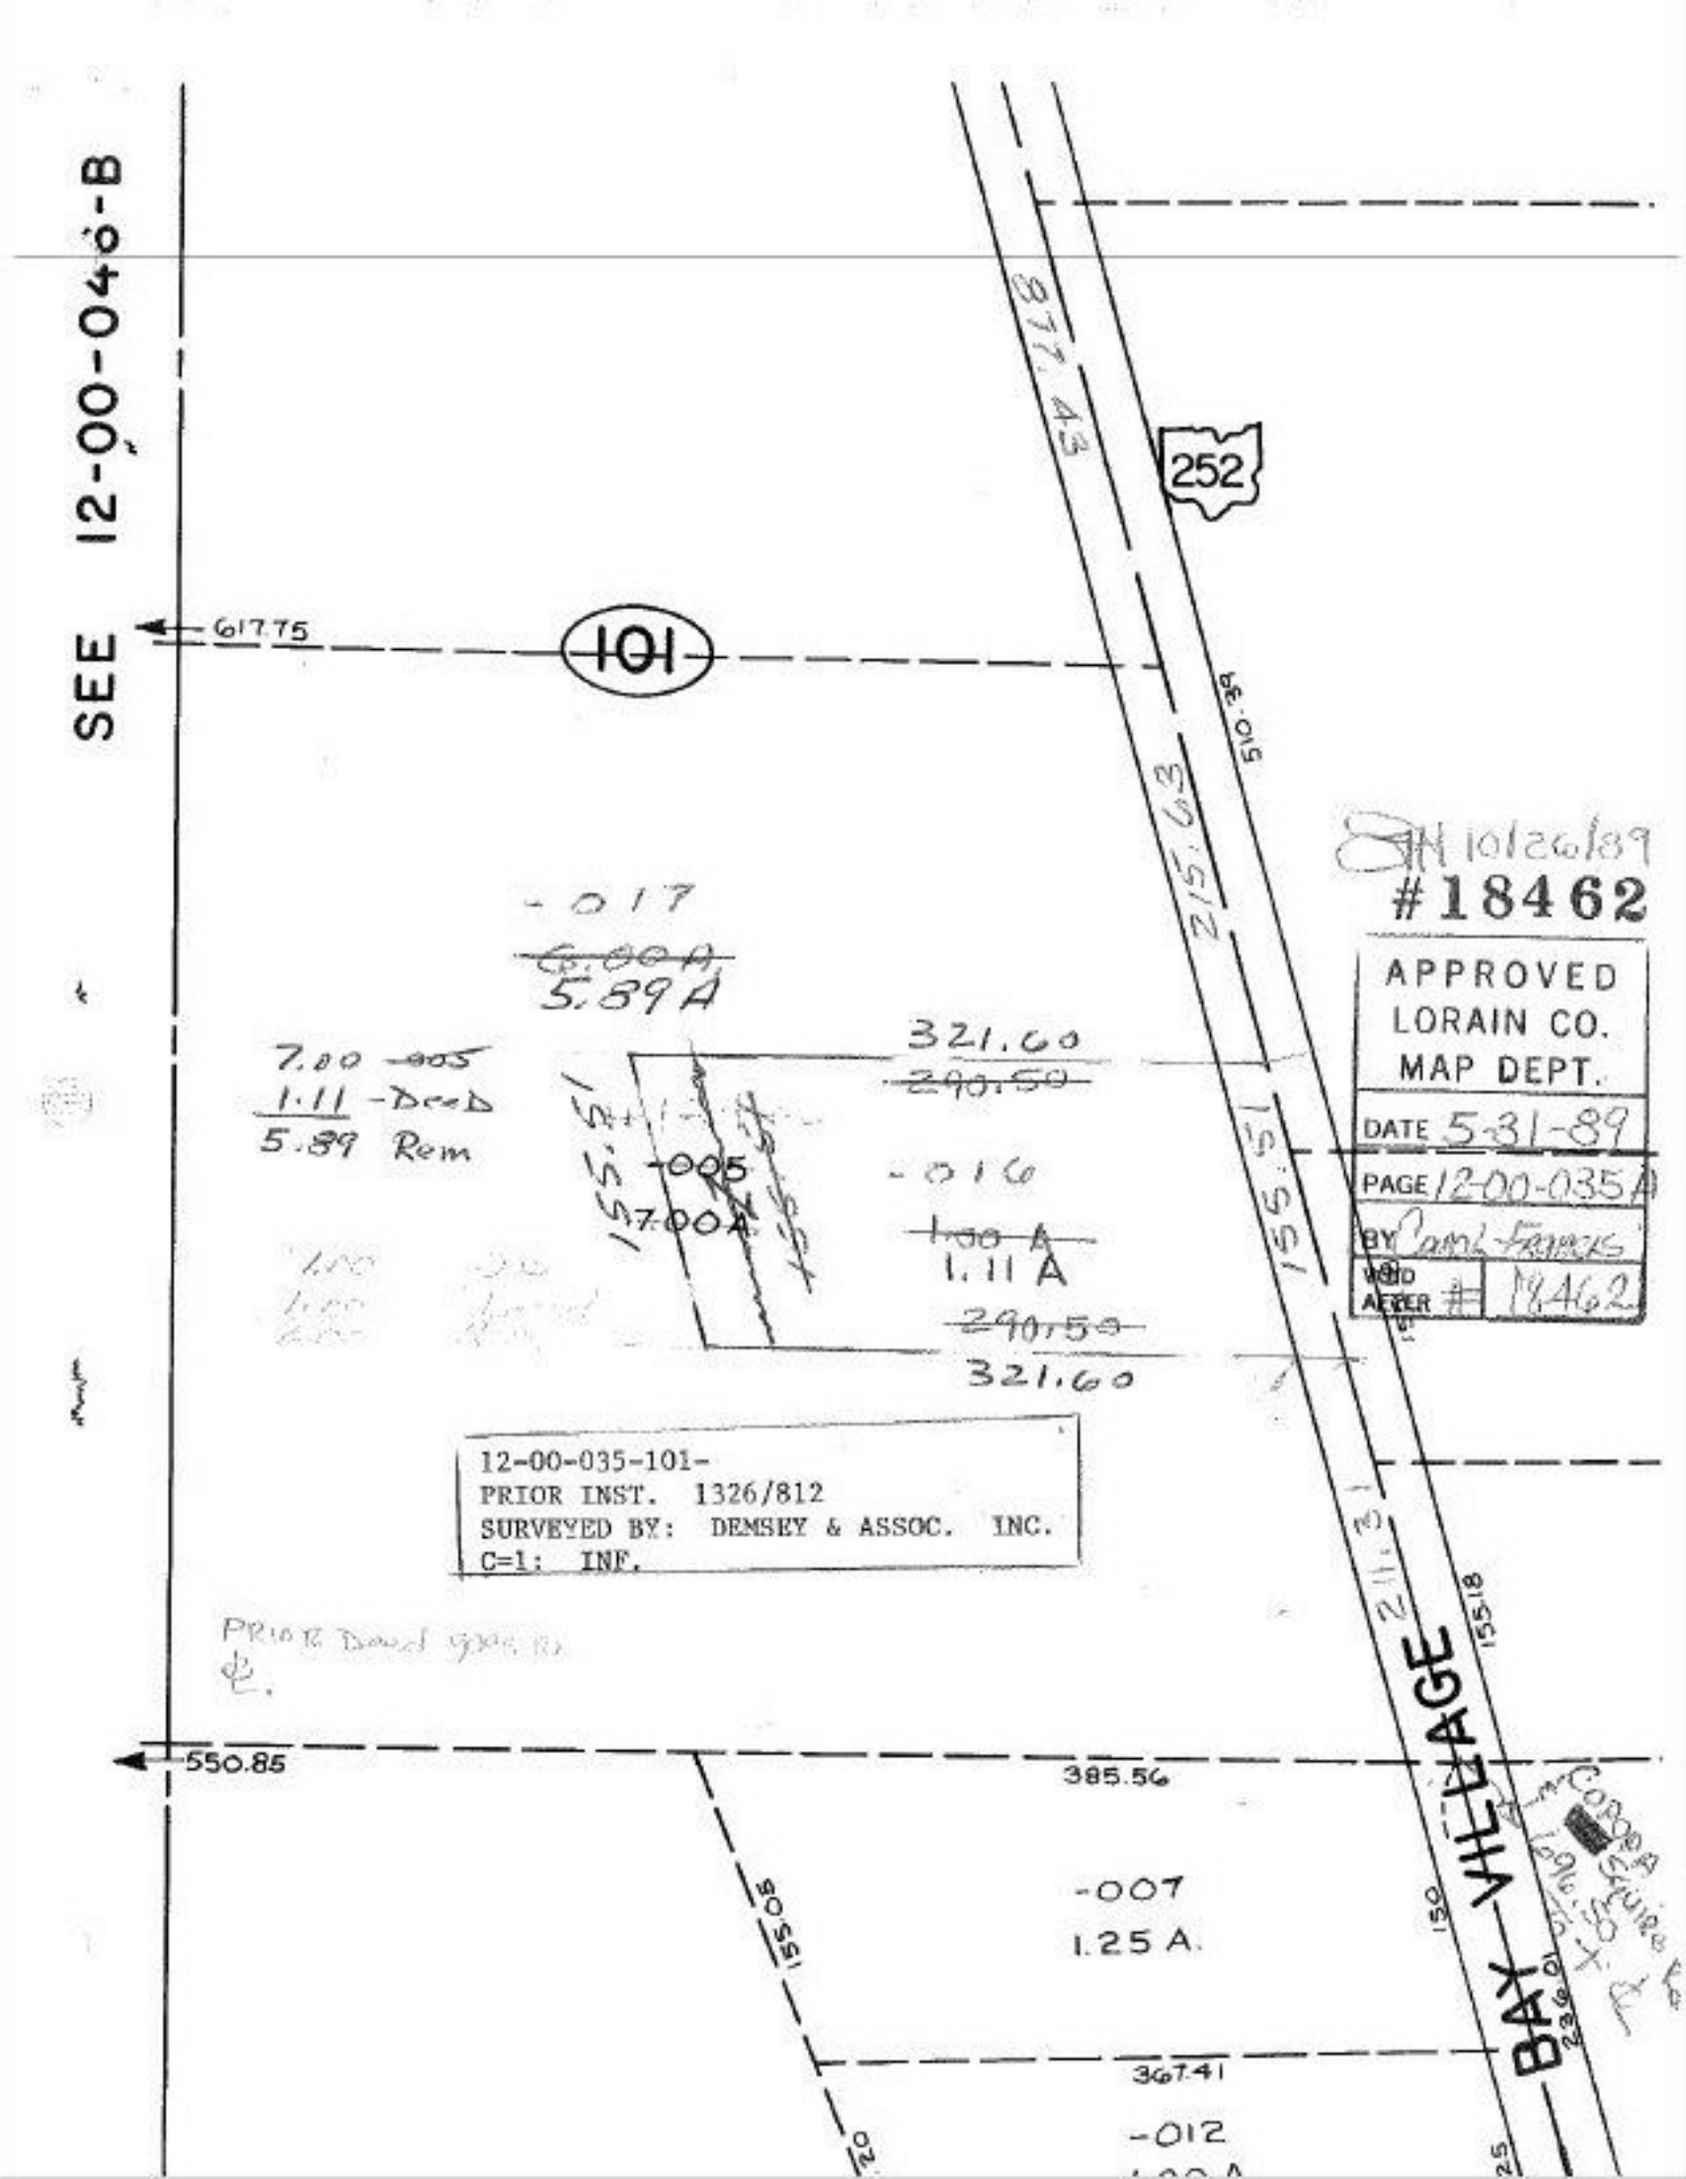
SEE 12-00-040-B
617.75
101
252
877.43
215.63
510.39
155.51
321.60
290.50
-017
5.89A
7.00 -005
1.11 -Dec'd
5.89 Rem
-005
7.00A
-016
1.11A
290.50
321.60
155.51
12-00-035-101-
PRIOR INST. 1326/812
SURVEYED BY: DEMSEY & ASSOC. INC.
C=1: INF.
PRIOR Deed 90% to
550.85
385.56
-007
1.25 A.
155.51
367.41
-012
BAY VILLAGE
211.31
155.18
150
225.01
APPROVED
LORAIN CO.
MAP DEPT.
DATE 5-31-89
PAGE 12-00-035A
BY Carol Farris
VOID AFTER # 18462
DH 10/26/89
#18462