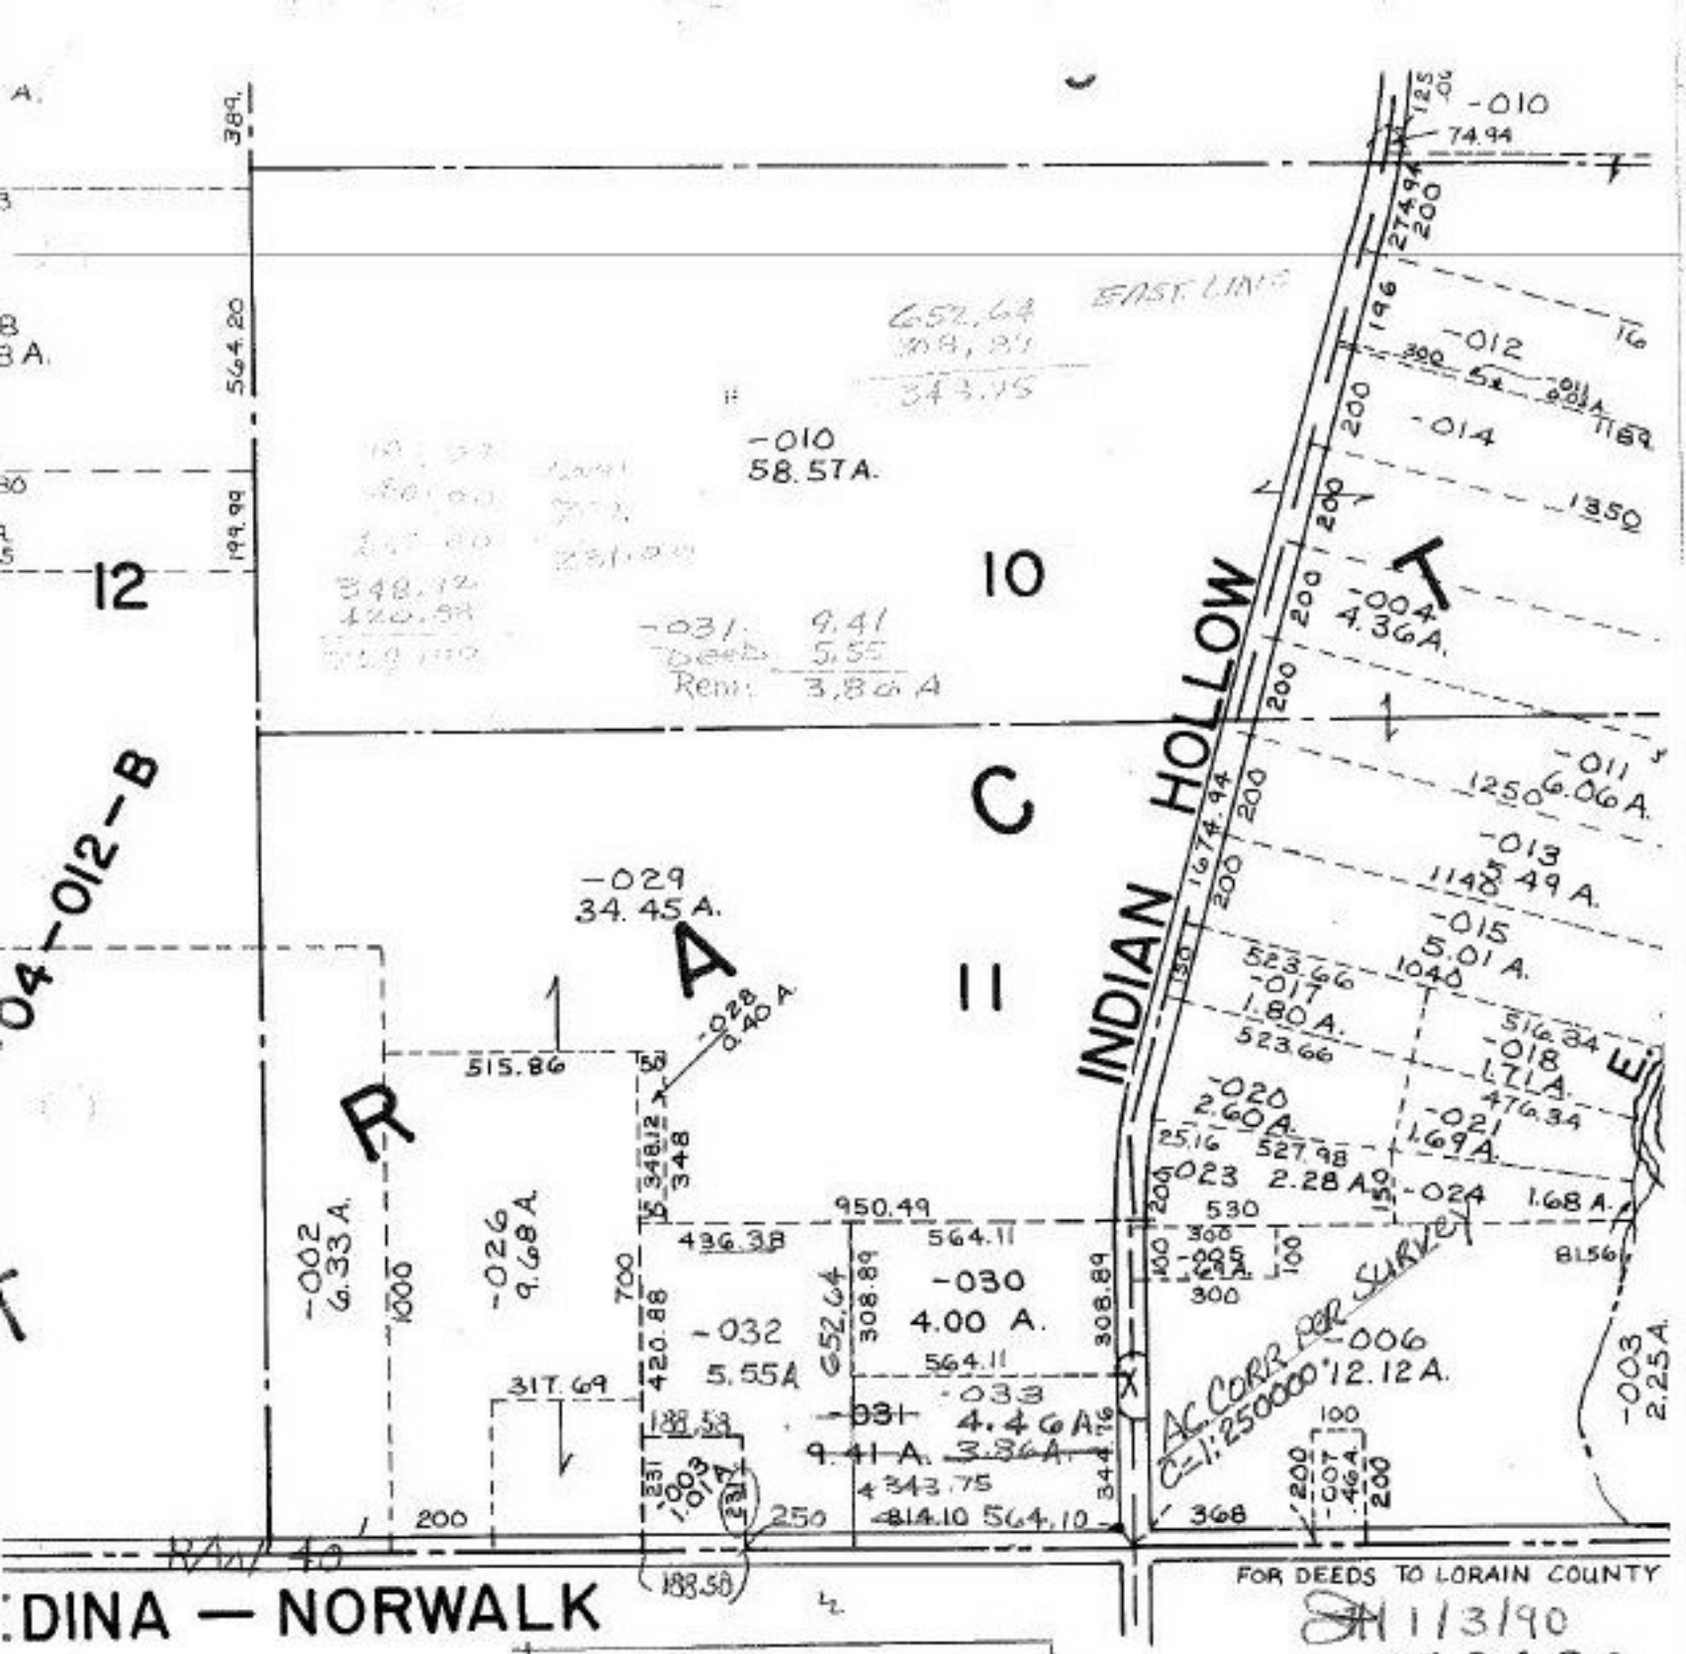

:DINA — NORWALK

19-04-011-000-
PRIOR INST. OR. 159/697
SURVEYED BY: DANE A. HAPONEK
C-1: 50000

TRACT 4 LOTS 9 THRU 12, 34, 35
" 5 " 5 " 8 & WLY PT. LOTS
" 6 " 105 " 108 "

DATE 6-2-89

1/3/90
#18464

APPROVED
LORAIN CO.
MAP DEPT.
DATE
PAGE 19-C "
BY Carol Francis
VOID AFTER # 18464