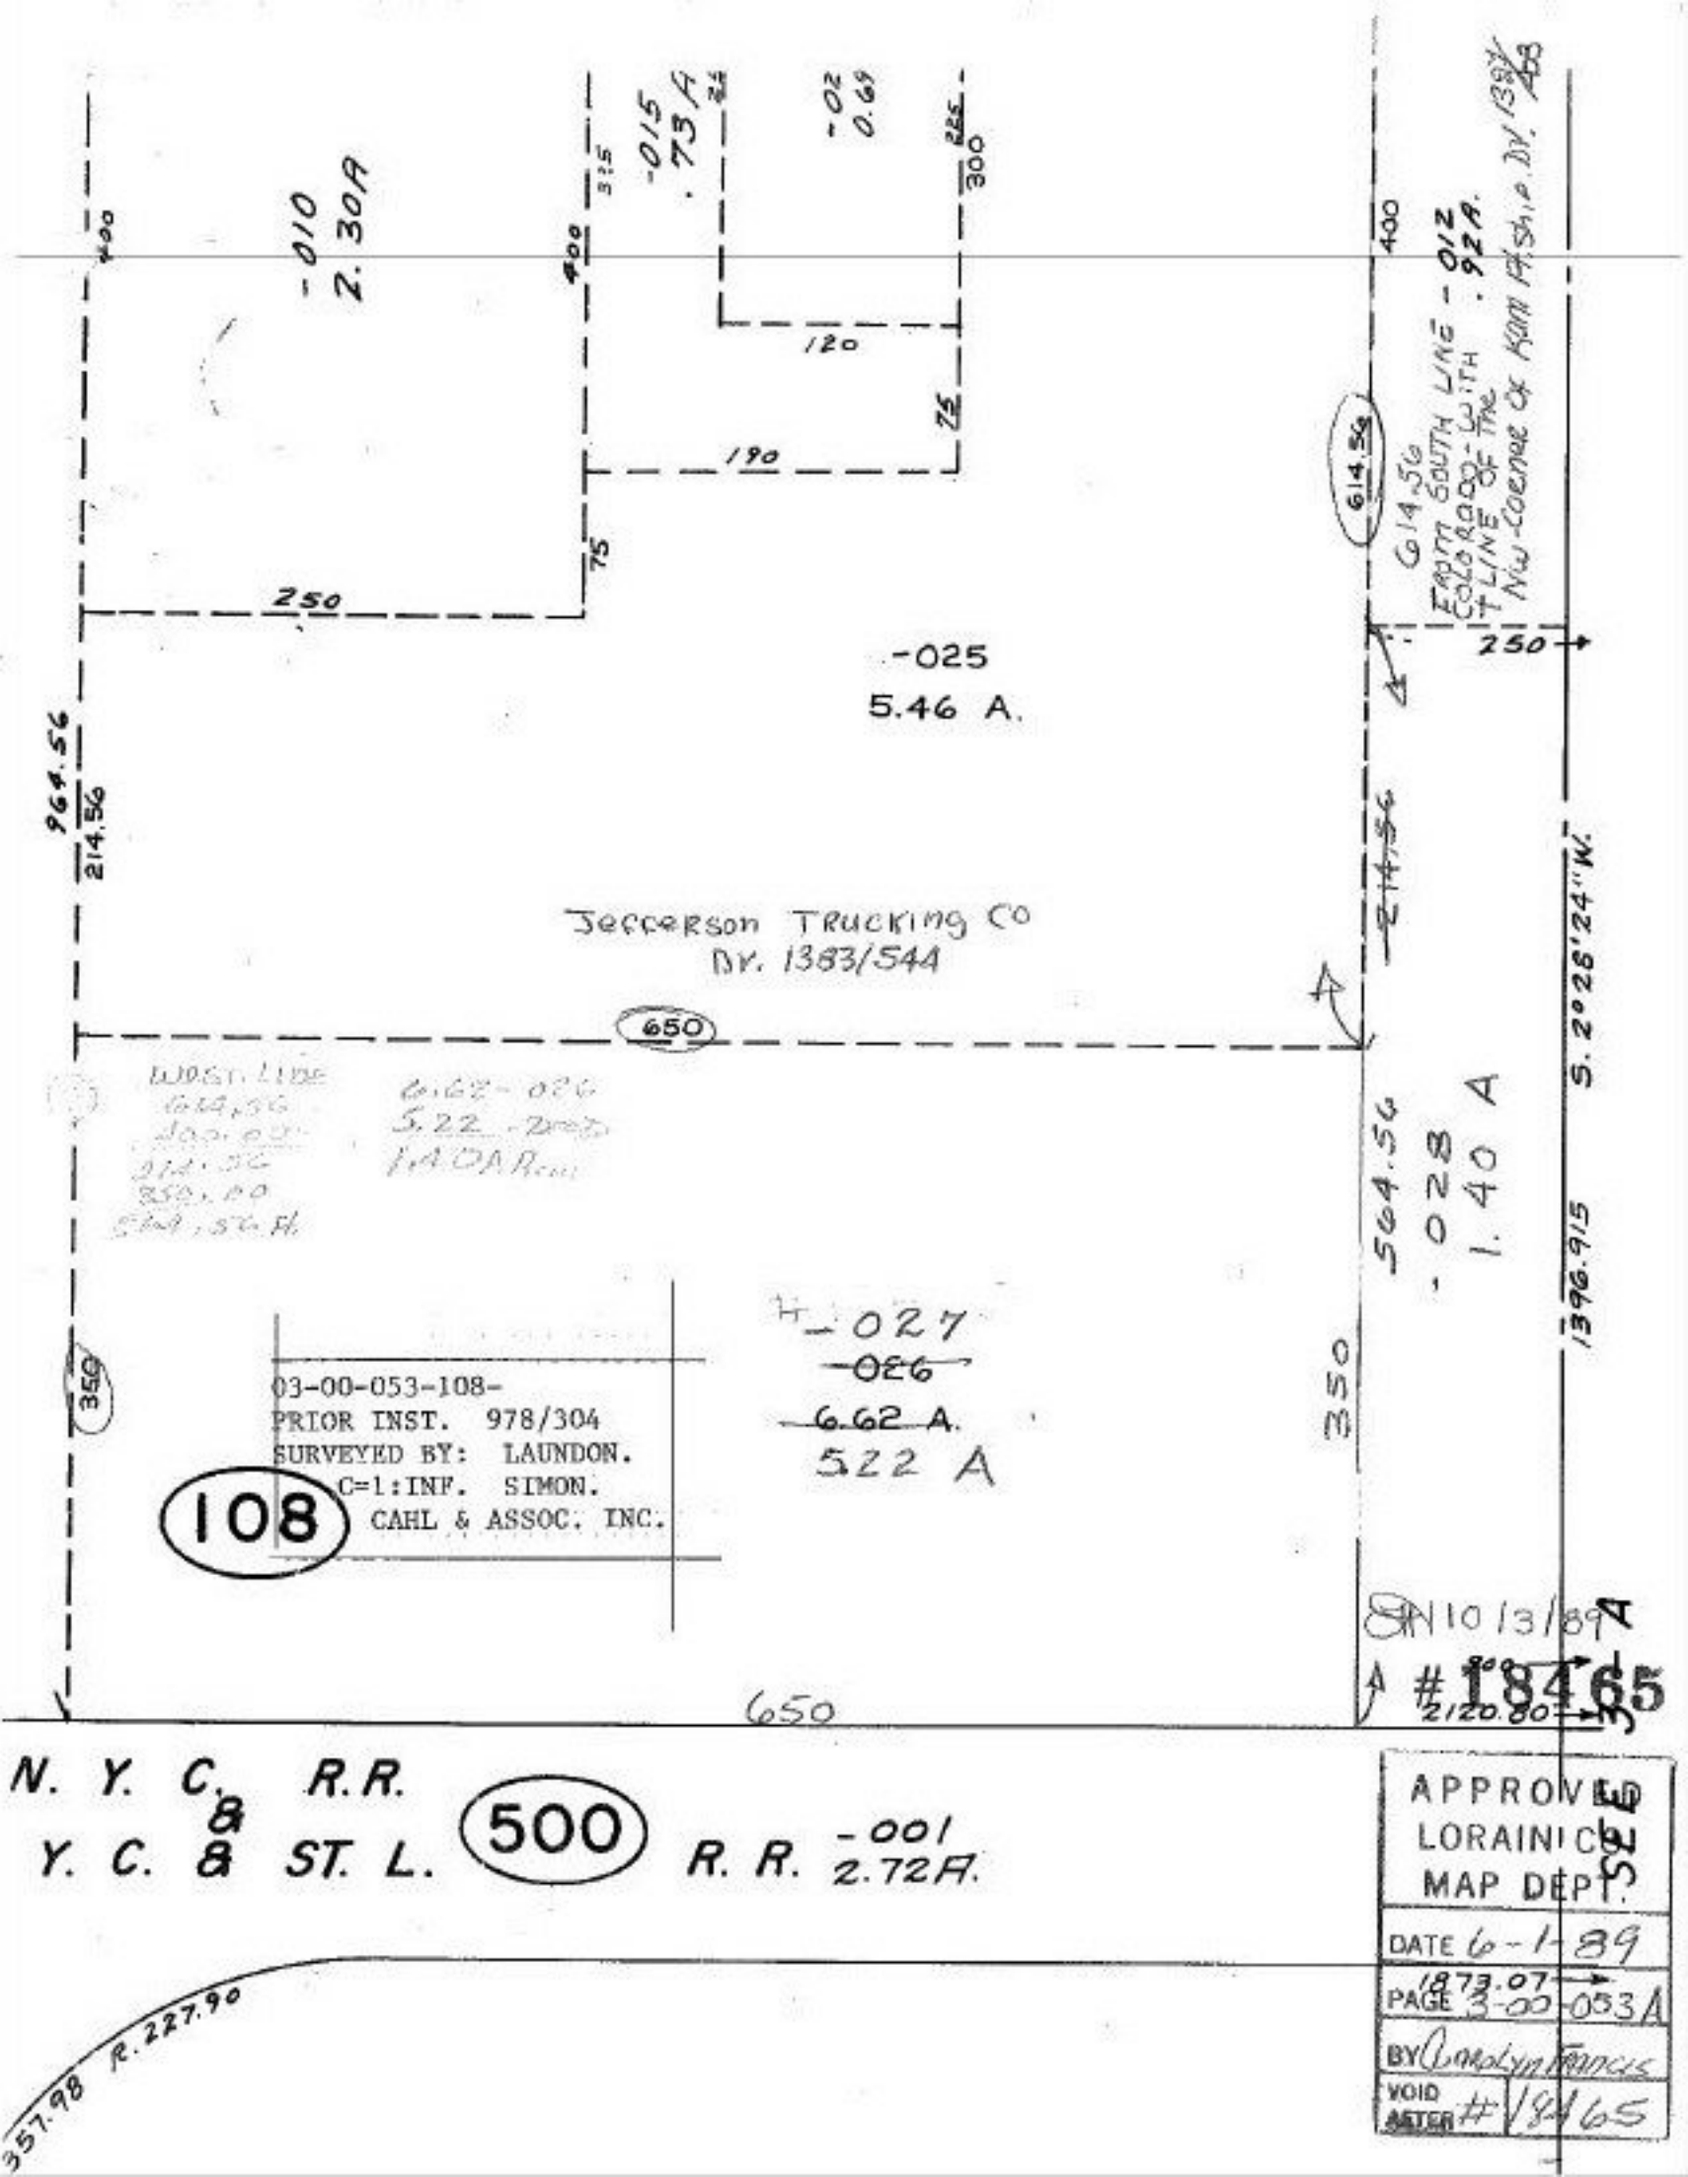
-010
2.30A
400
315
-015
.73A
24
-02
0.69
285
300
120
25
190
75
250
400
614.56
614.56 FROM SOUTH LINE OF COLORADO ST. WITH W'LY LINE OF THE NW-CORNER OF KENT INDUSTRIAL DIV. 138/88
-012
.92A.
250
-025
5.46 A.
964.56
214.56
JEFFERSON TRUCKING CO
DV. 1383/544
650
WEST LINE
644.56
200.00
214.56
350.00
564.56 ft.
6.62 - 026
5.22 - 027
1.40 A
564.56
-028
1.40 A
S. 2°28'24" W.
1396.915
350
-027
-026
6.62 A.
522 A
03-00-053-108-
PRIOR INST. 978/304
SURVEYED BY: LAUNDON.
C=1:INF. SIMON.
CAHL & ASSOC. INC.
108
10/13/89
#18465
2120.80
650
N. Y. C. & R. R.
Y. C. & ST. L. R. R.
500
-001
2.72A.
357.98
R. 227.90
APPROVED
LORAINI CO
MAP DEPT.
DATE 6-1-89
1873.07
PAGE 3-00-053A
BY Carolyn Francis
VOID AFTER # 18465
SEE