 

-001
27.00 A
429.0
394.68
1549.02
17-08-026-000
Survey Deed BY: Charles J. Neff
Reg. Surveyor
C=1:100000.
-002
1.03 A
407.60
1411.08
RD.
577
-002
50.00 A
26
1016.40
1987.24
882
1987.24
-010
5.00 A
-011
6.27 A
1105.34
1105.55
247
1987.55
-008
11.27 A
1987.86
COMM. RES. 76-1061
12-29-76
314.01
-006
22.81 A
528.21
-004
1.08 A
497.2
-016
3.10 A
269.67
499.27
-015
2.40 A
499.27
209.67
-011
5.49 A
480
C
T
17-08-026-000-
PRIOR INST. 1293/546
SURVEYED BY: LAUNDON, SIMON, CAHL & ASSOC
C=1: INF.
497.58
-014
2.10 A
497.15
29
-08-029
28
12/22/89
#18466
APPROVED
LORAIN CO.
MAP DEPT.
DATE 6-6-89
PAGE 17-D
BY Carolyn Francis
VOID AFTER #18466