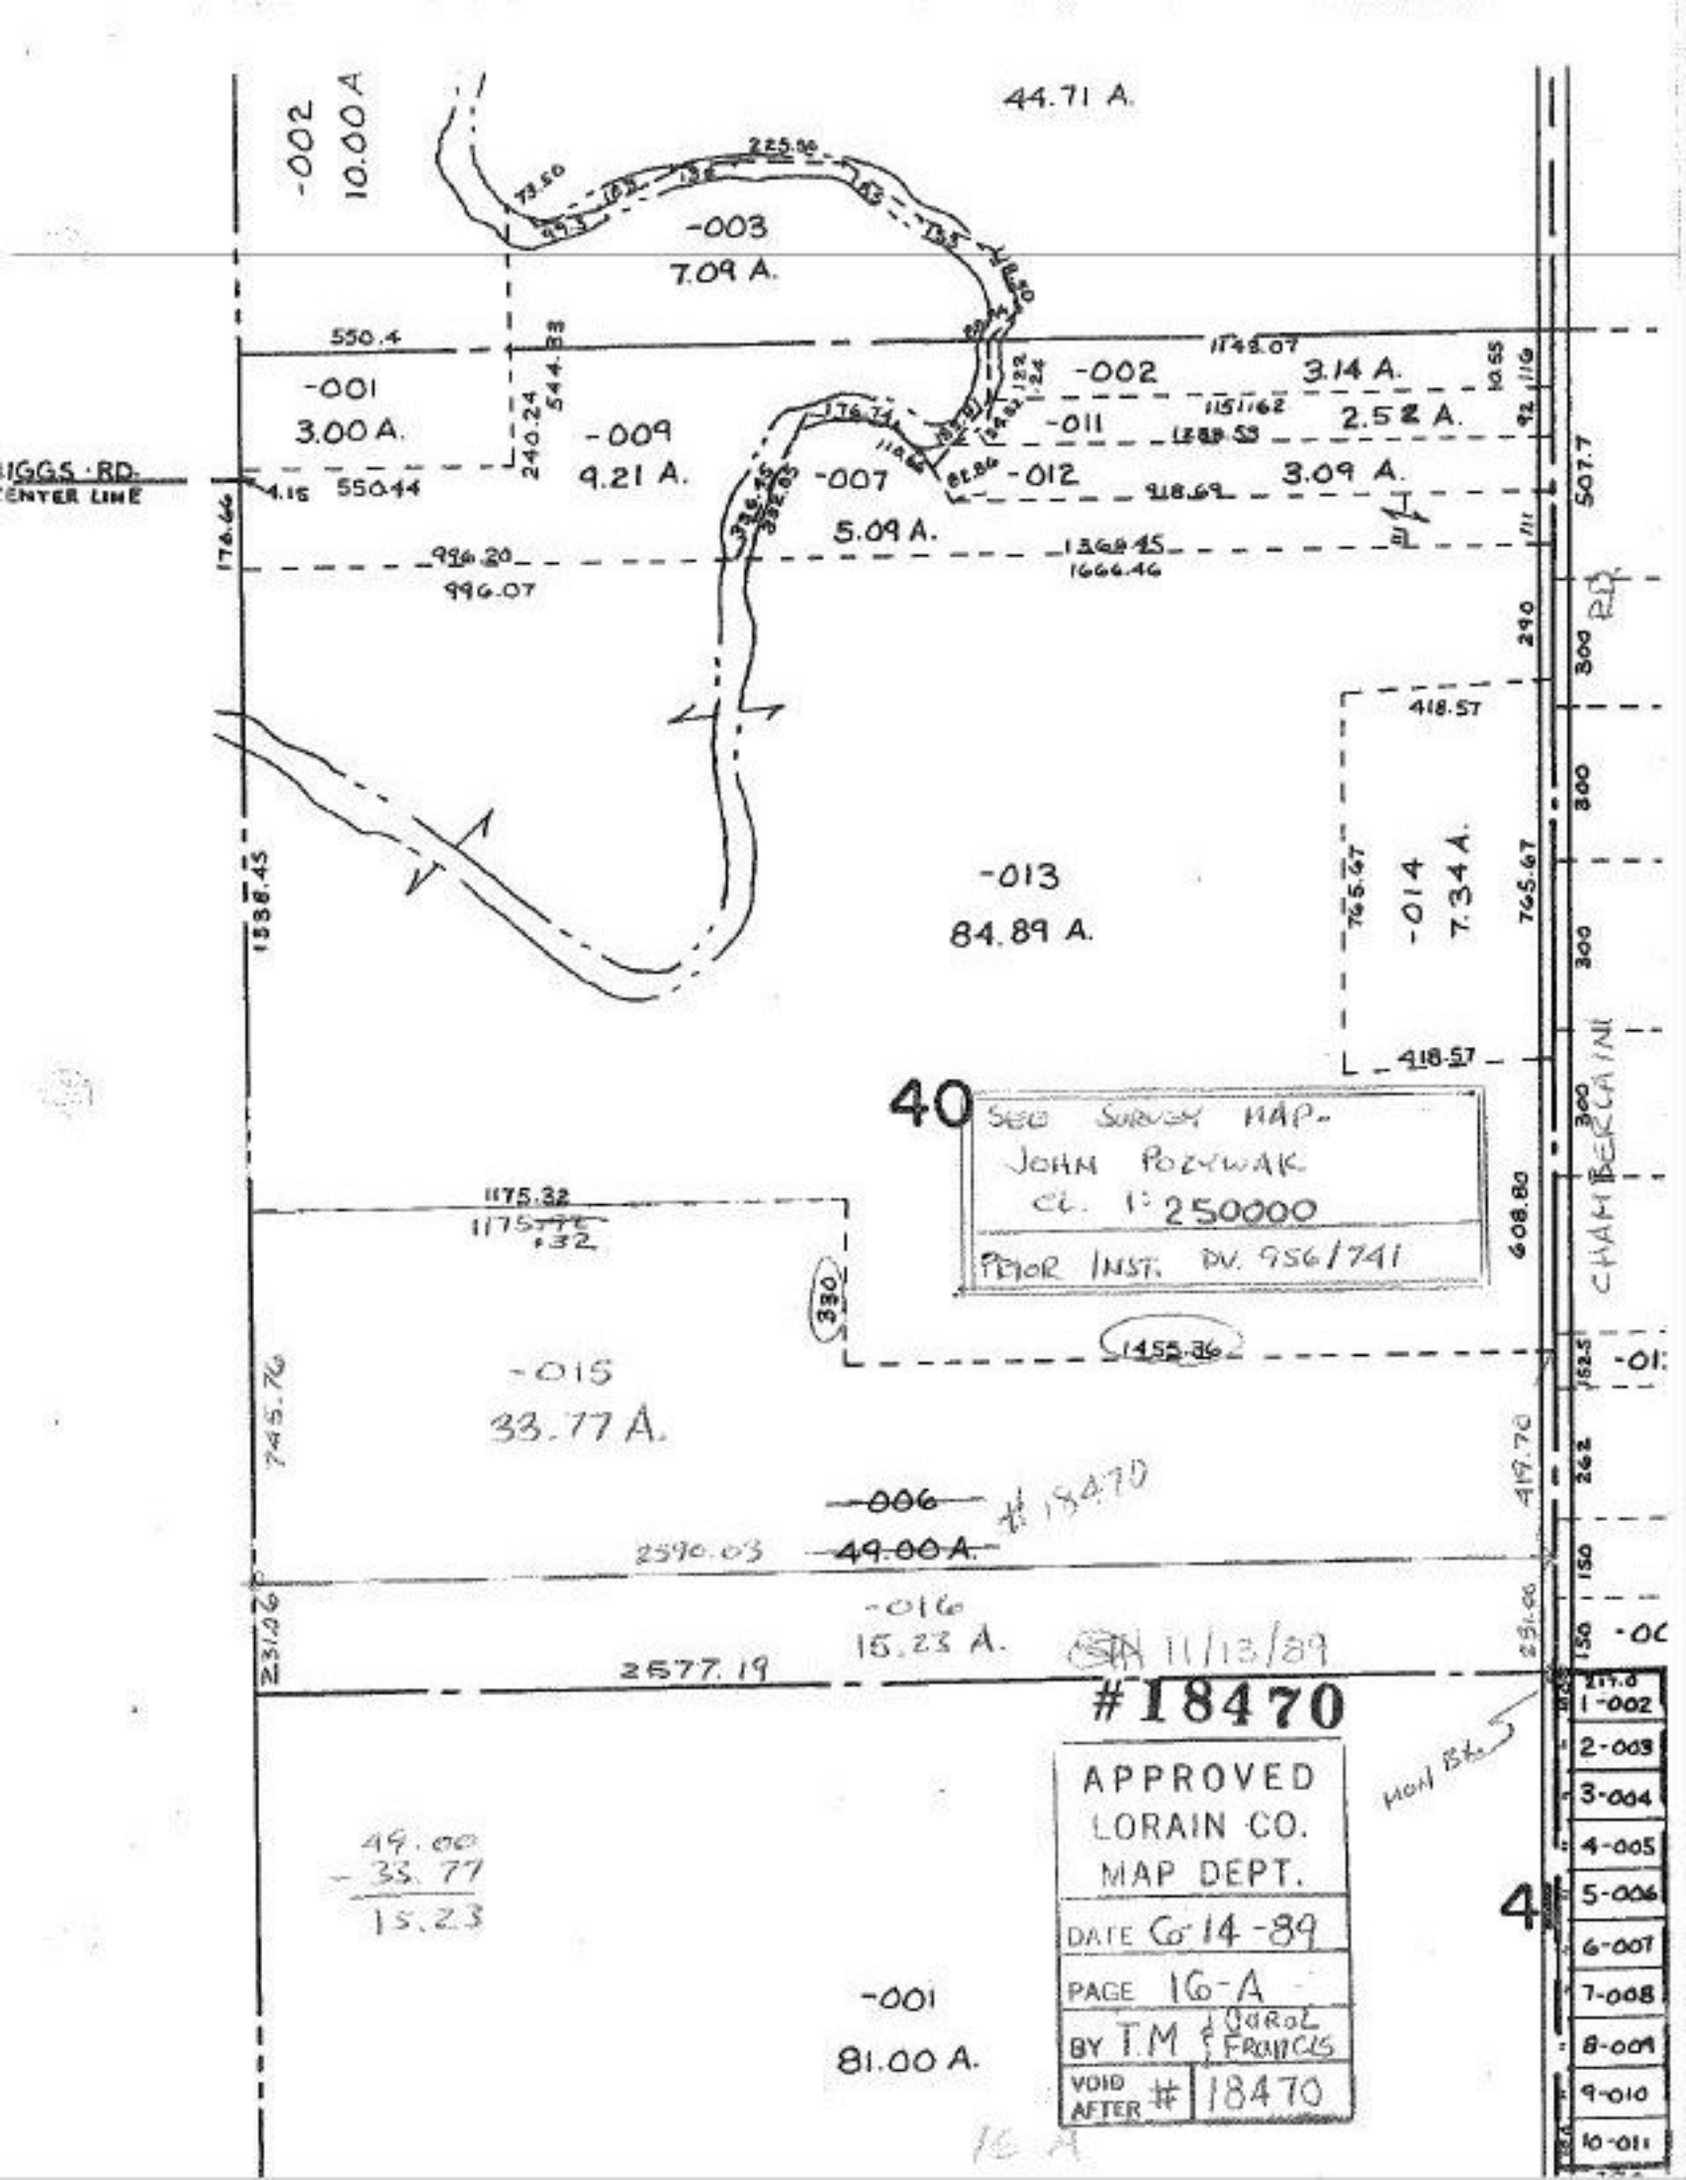

44.71 A.
-002
10.00 A
-003
7.09 A.
550.4
-001
3.00 A.
-009
9.21 A.
-002
3.14 A.
-011
2.52 A.
-012
3.09 A.
-007
5.09 A.
BIGGS RD.
CENTER LINE
550.44
996.20
996.07
1366.45
1666.46
418.57
-013
84.89 A.
-014
7.34 A.
765.67
1538.45
40
SEE SURVEY MAP-
JOHN POZYWAK
CL. 1:250000
PRIOR INST. DV. 956/741
1175.32
1455.36
-015
33.77 A.
745.76
-006
#18470
2590.03
49.00 A.
-016
15.23 A.
2577.19
11/13/89
#18470
APPROVED
LORAIN CO.
MAP DEPT.
DATE 6-14-89
PAGE 16-A
BY T.M & CAROL FRANCIS
VOID AFTER # 18470
49.00
- 33.77
15.23
-001
81.00 A.
CHAMBERLAIN
1-002
2-003
3-004
4-005
5-006
6-007
7-008
8-009
9-010
10-011