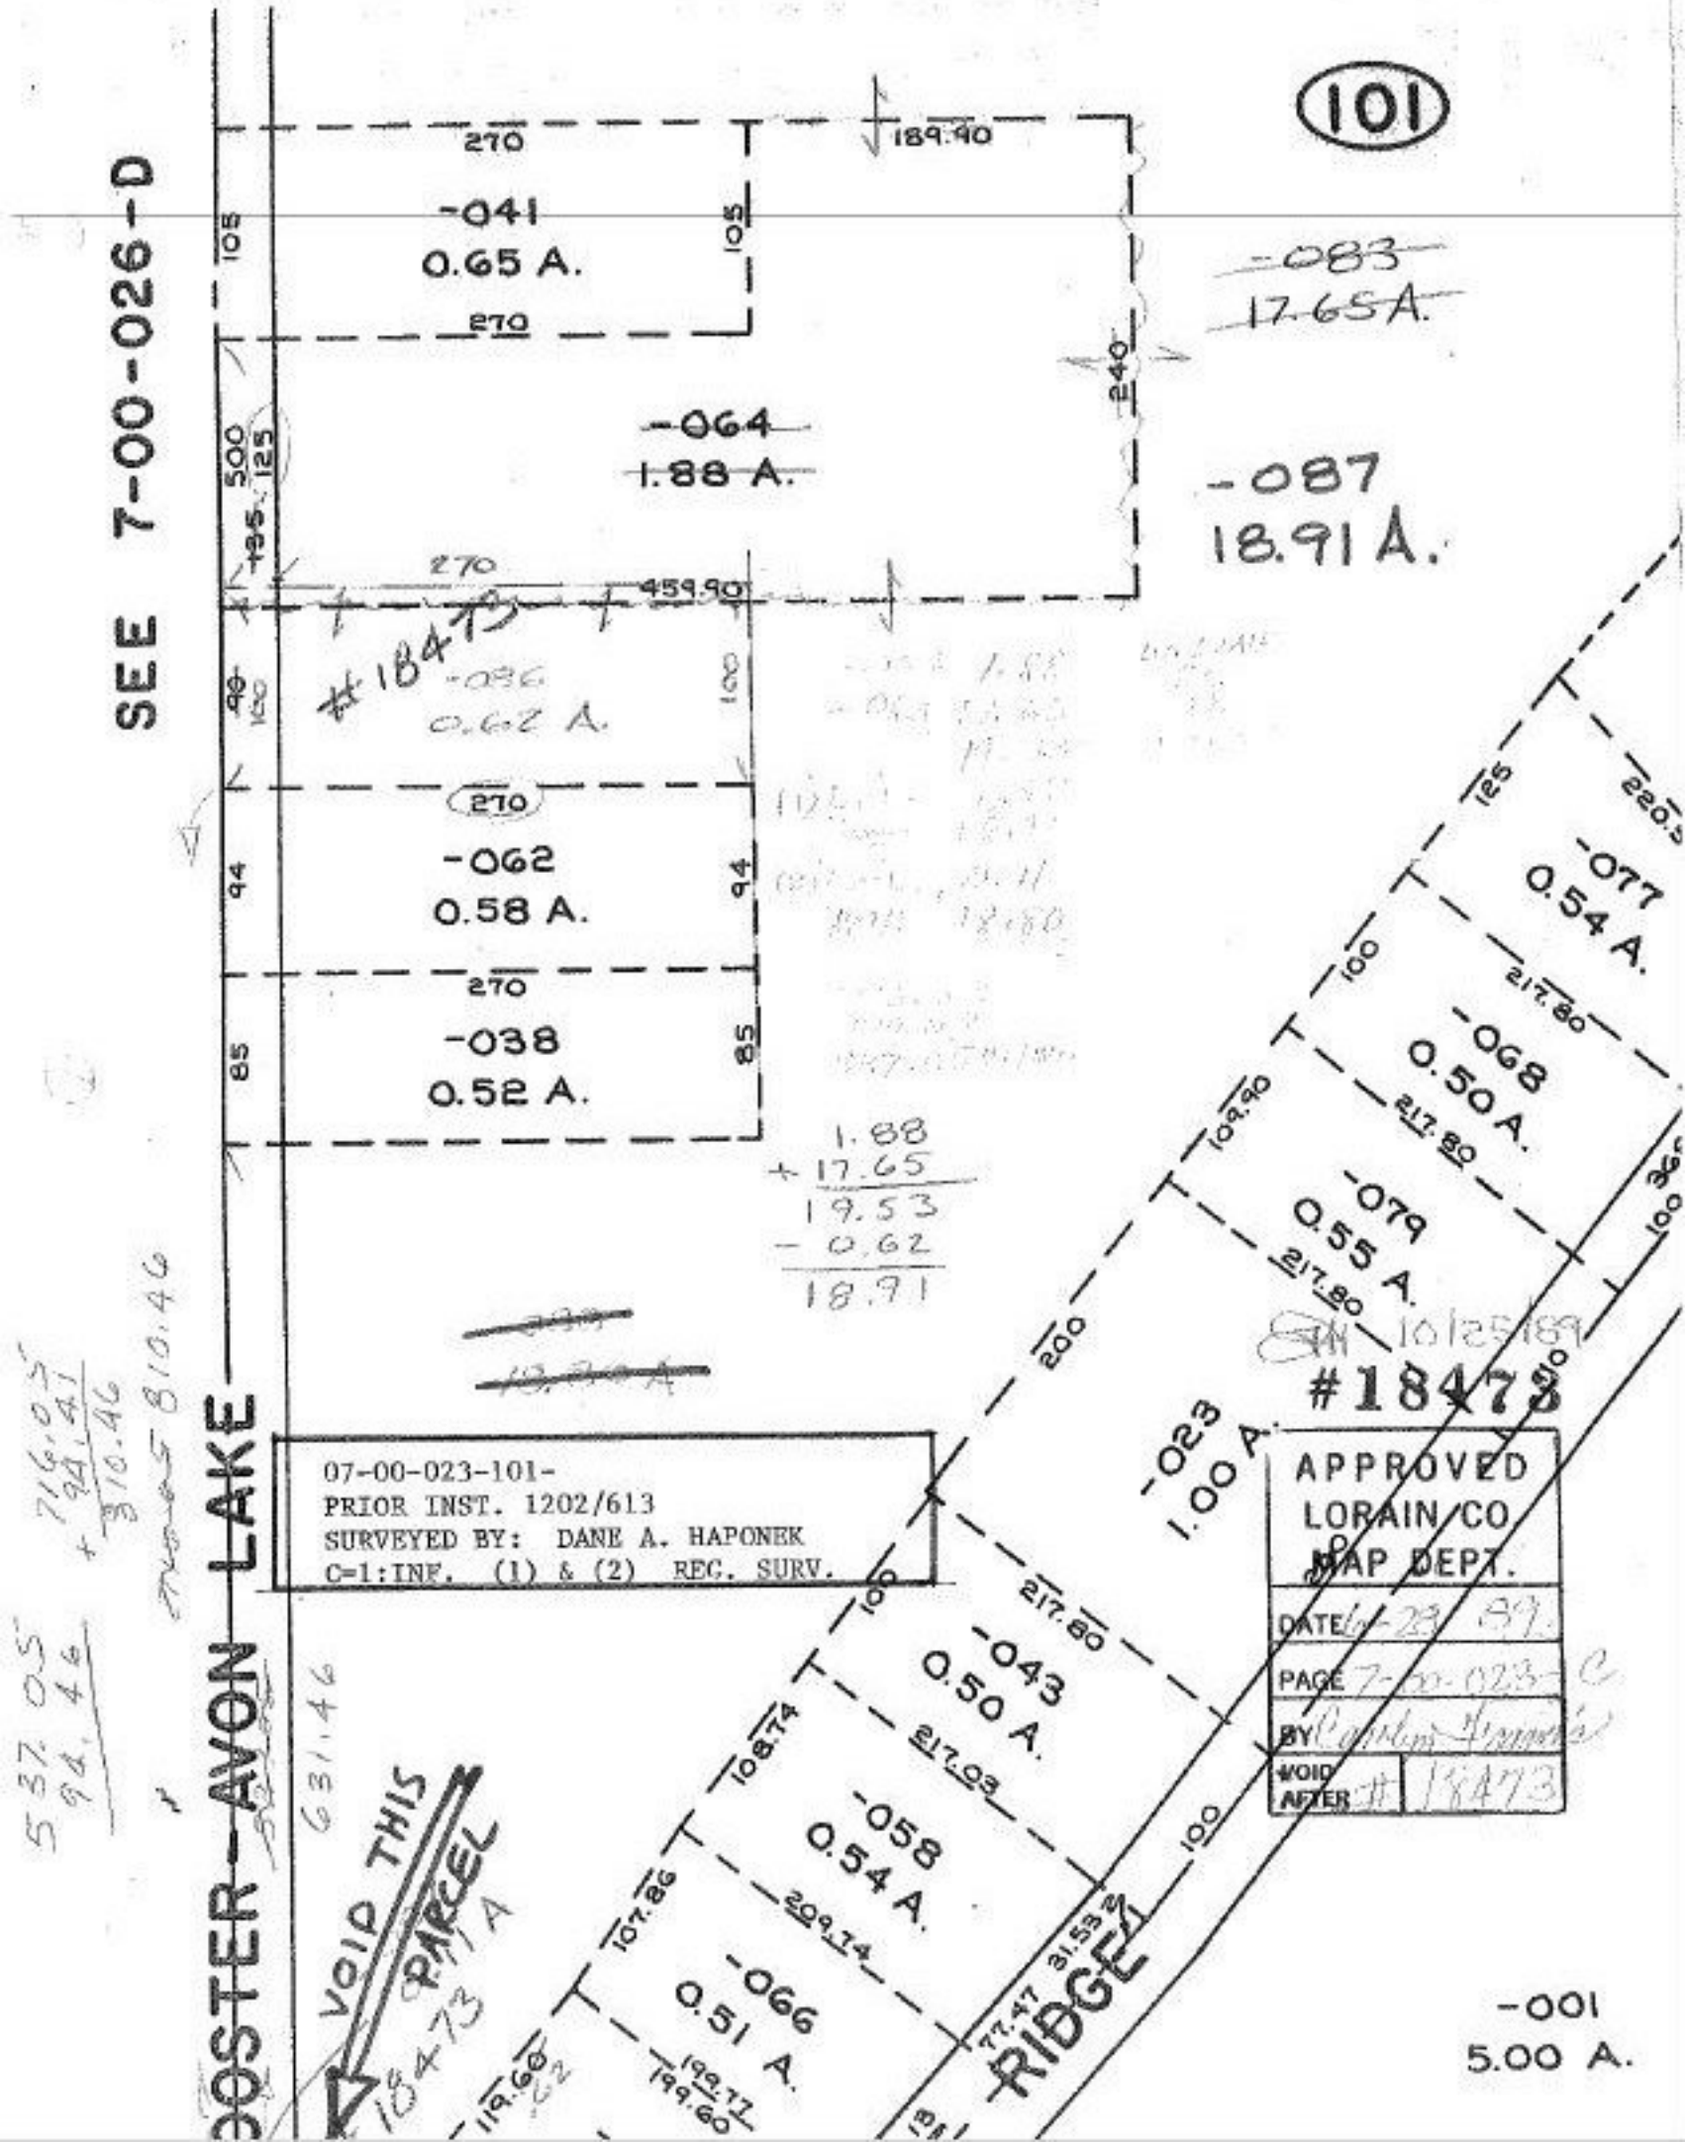
101
SEE 7-00-026-D
-041
0.65 A.
-064
1.88 A.
-083
17.65 A.
-087
18.91 A.
-086
0.62 A.
#18473
-062
0.58 A.
-038
0.52 A.
-077
0.54 A.
-068
0.50 A.
-079
0.55 A.
-023
1.00 A.
-043
0.50 A.
-058
0.54 A.
-066
0.51 A.
-001
5.00 A.
07-00-023-101-
PRIOR INST. 1202/613
SURVEYED BY: DANE A. HAPONEK
C=1:INF. (1) & (2) REC. SURV.
APPROVED
LORAIN CO
MAP DEPT.
DATE
PAGE
BY
VOID AFTER
VOID THIS PARCEL
BOSTER-AVON LAKE
RIDGE