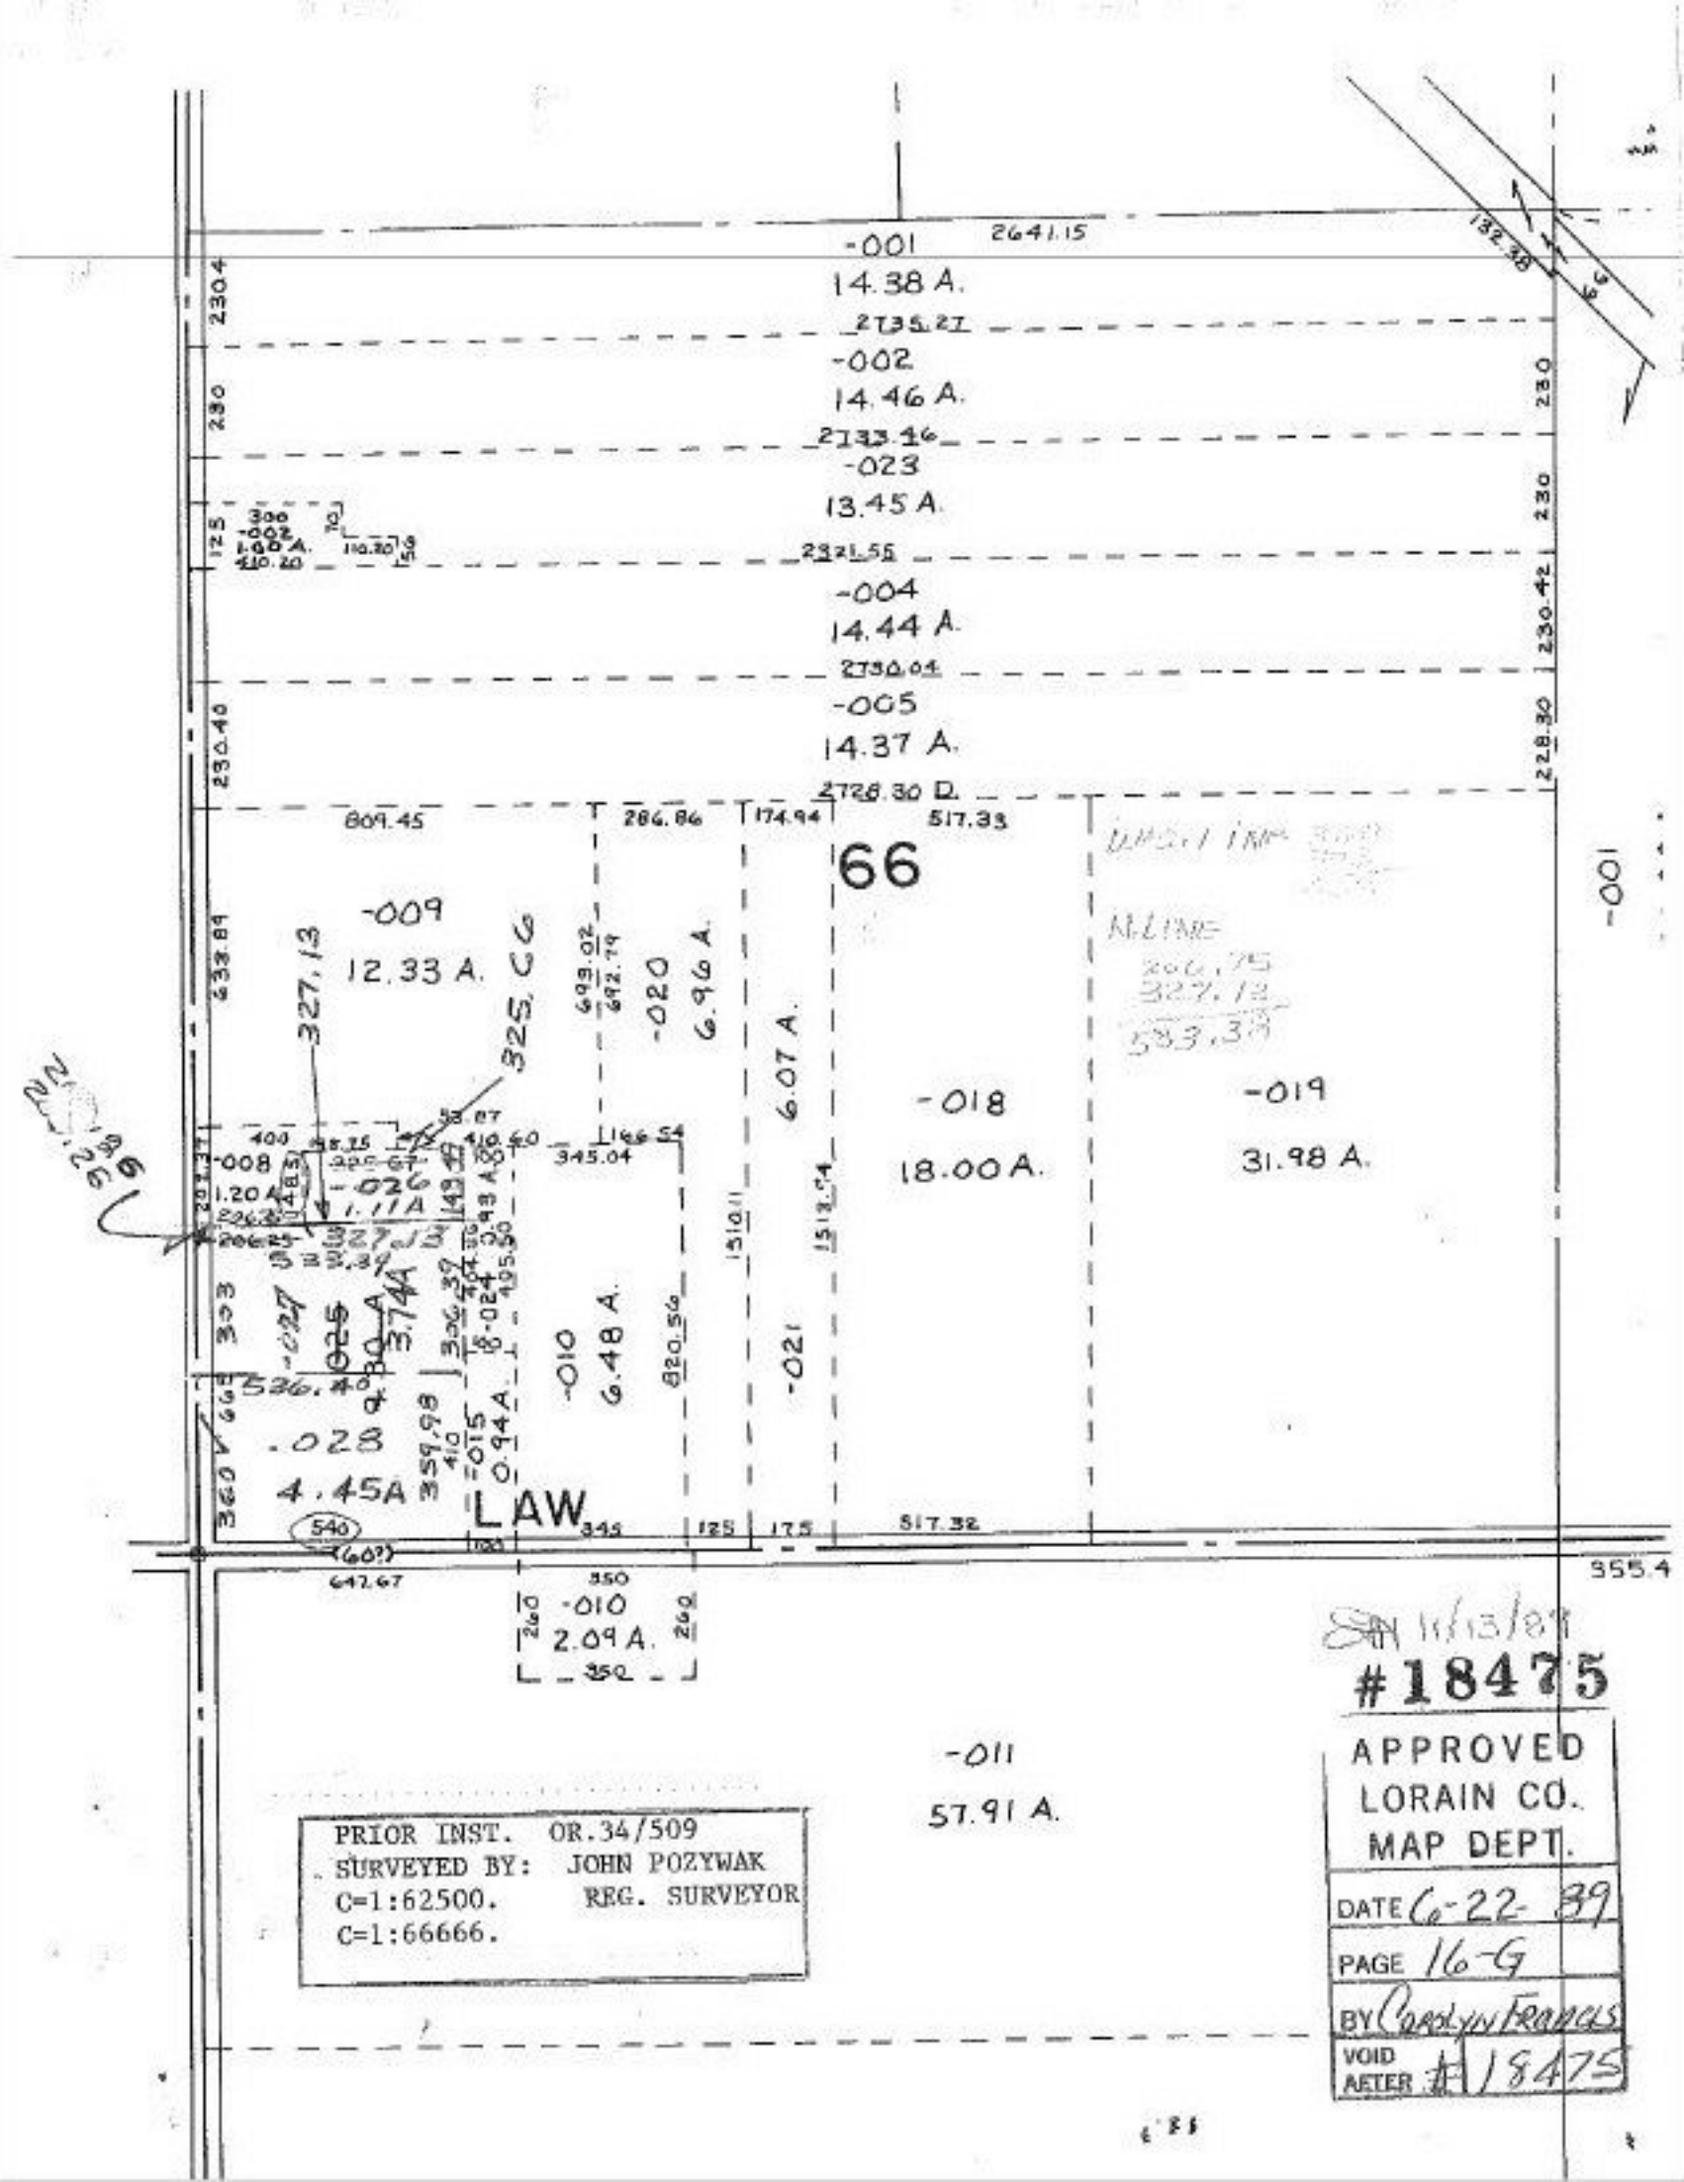
-001
2641.15
14.38 A.
2735.21
-002
14.46 A.
2733.16
-023
13.45 A.
2321.55
-004
14.44 A.
2730.04
-005
14.37 A.
2728.30 D.
809.45
284.86
174.94
517.33
66
-009
12.33 A.
327.13
325.66
-020
6.96 A.
6.07 A.
-018
18.00 A.
-019
31.98 A.
M.LINE
206.75
327.12
533.38
-001
-008
1.20 A.
-026
1.11 A.
3.74A
-027
-025
-028
4.45A
-010
6.48 A.
-021
LAW
540
(60?)
642.67
345
125
175
517.32
955.4
-010
2.09 A.
-011
57.91 A.
PRIOR INST. OR.34/509
SURVEYED BY: JOHN POZYWAK
C=1:62500. REG. SURVEYOR
C=1:66666.
#18475
APPROVED
LORAIN CO.
MAP DEPT.
DATE 6-22-89
PAGE 16-G
BY Carolyn Frances
VOID
AFTER #18475