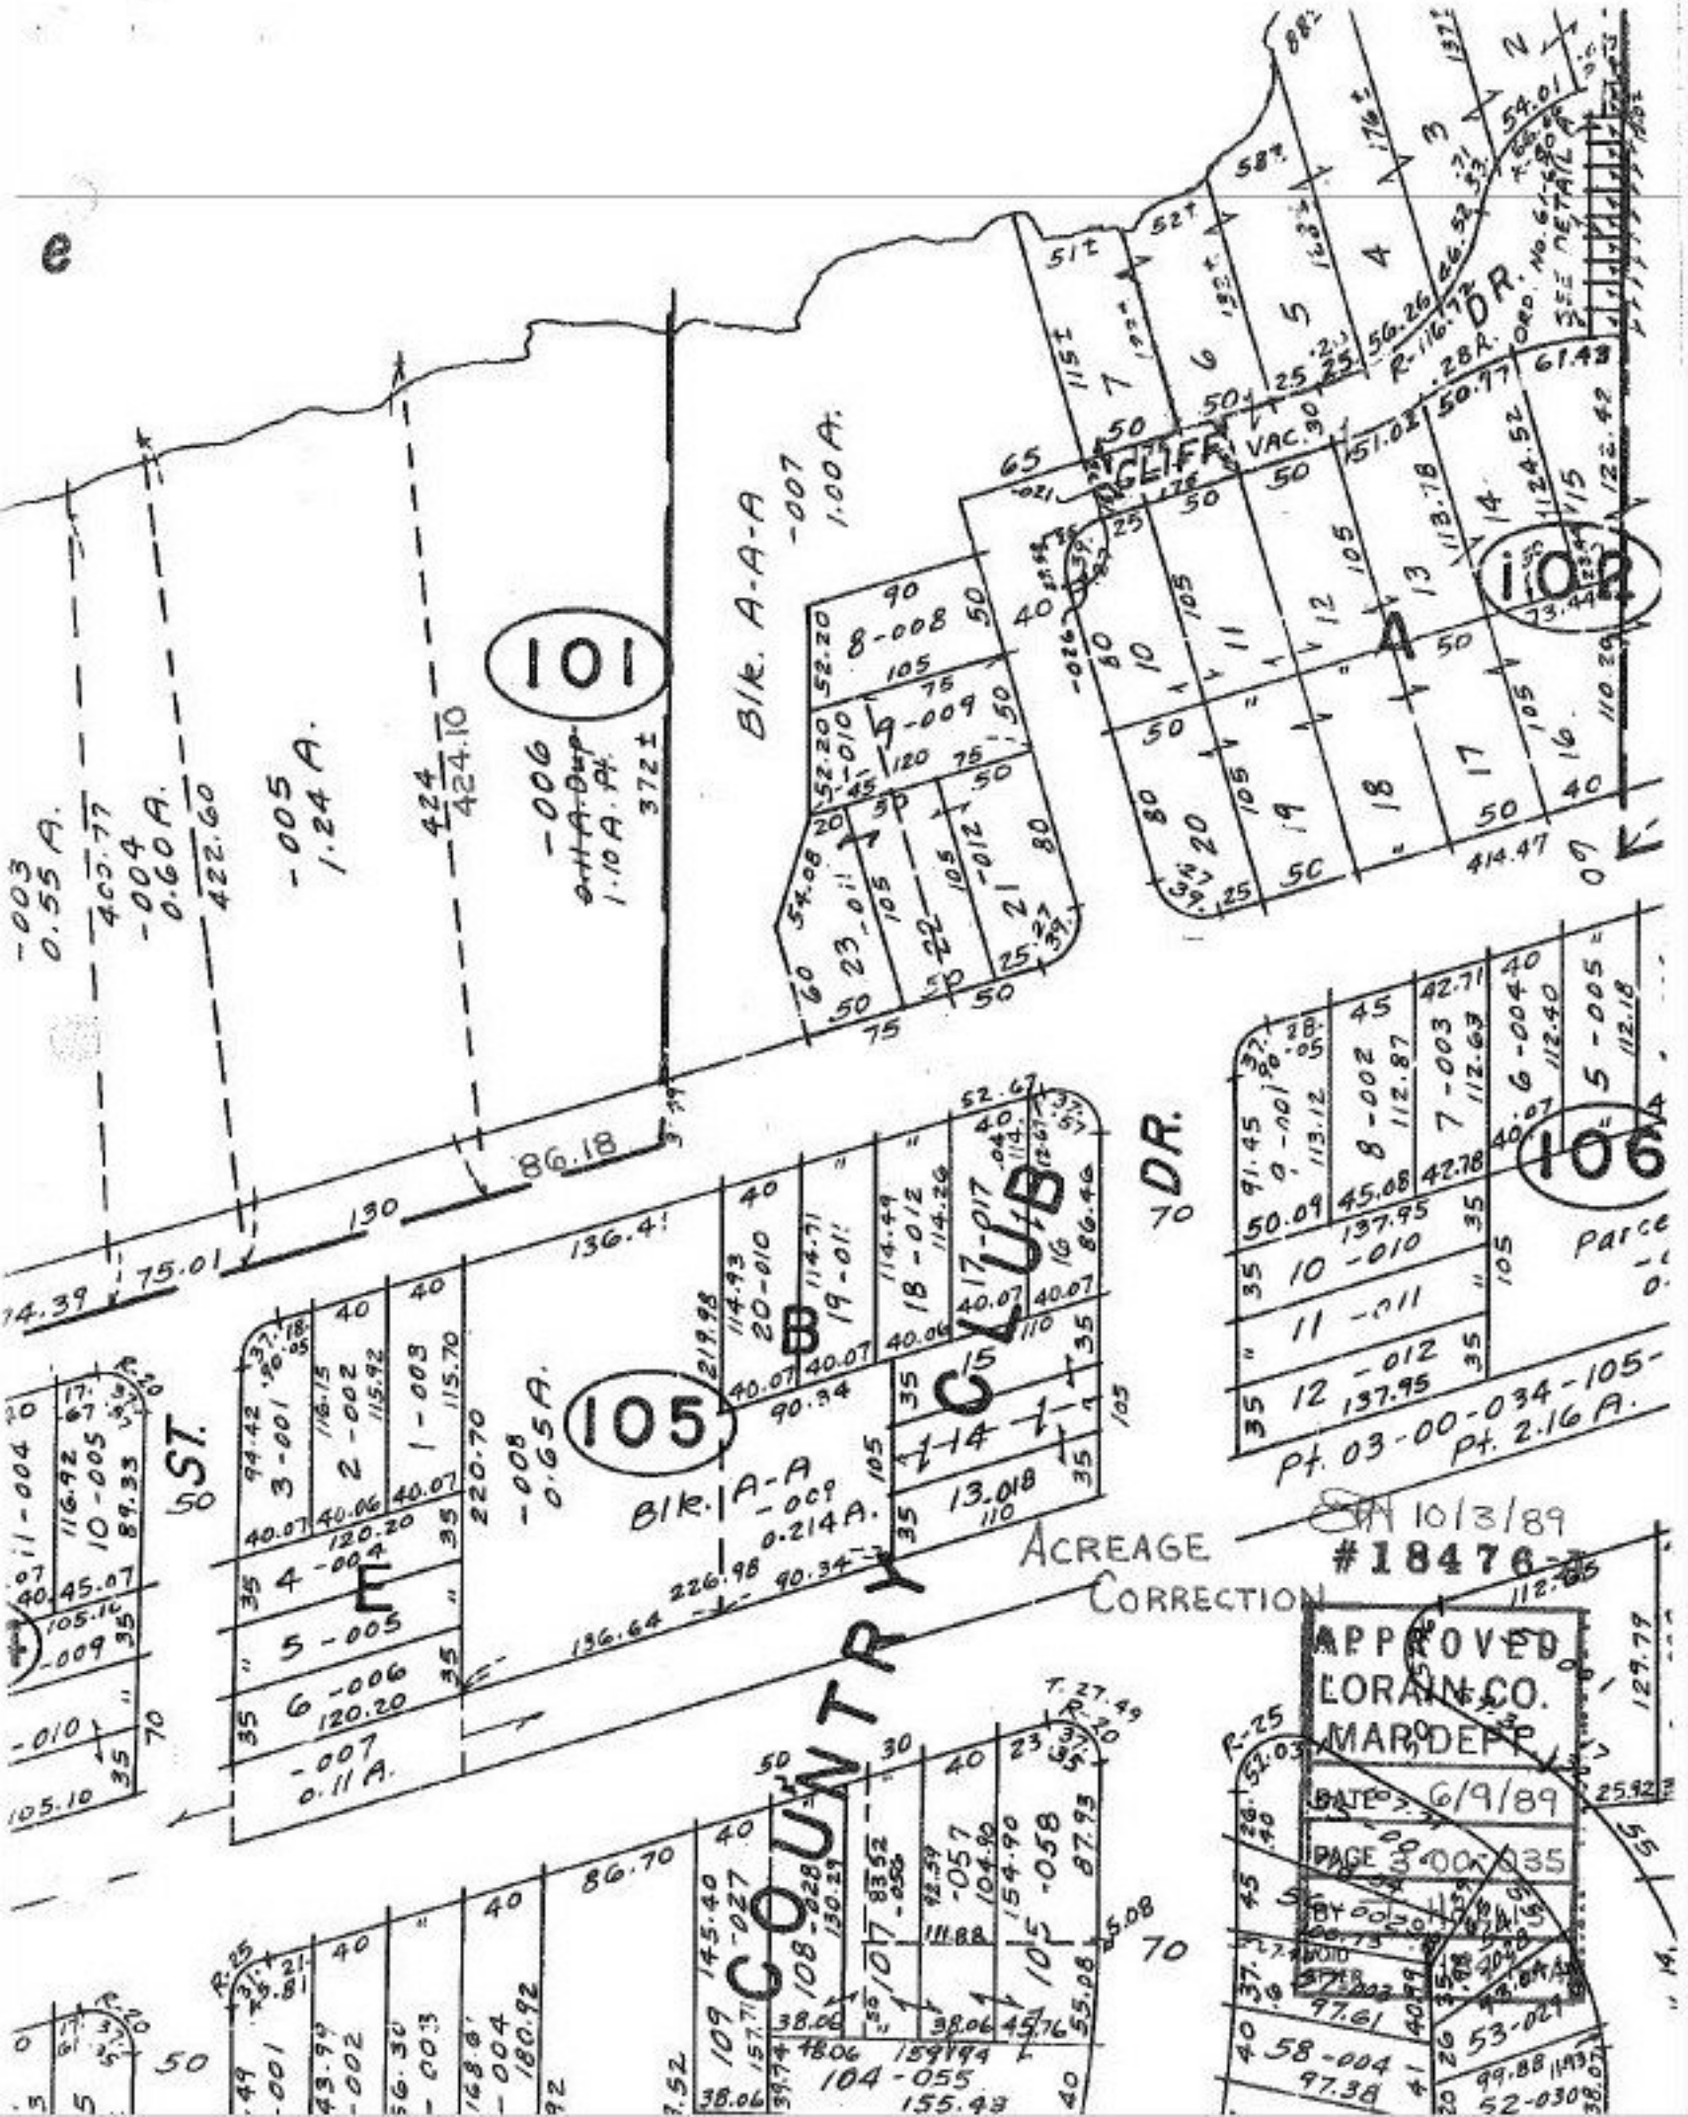

101
102
105
106
Blk. A-A-A
Blk. A-A
CLIFF
VAC.
DR.
ST.
COUNTRY CLUB
ACREAGE CORRECTION
10/3/89
#18476-
APPROVED
LORAIN CO.
MAR. DEPT.
DATE 6/9/89
PAGE 3-00-035