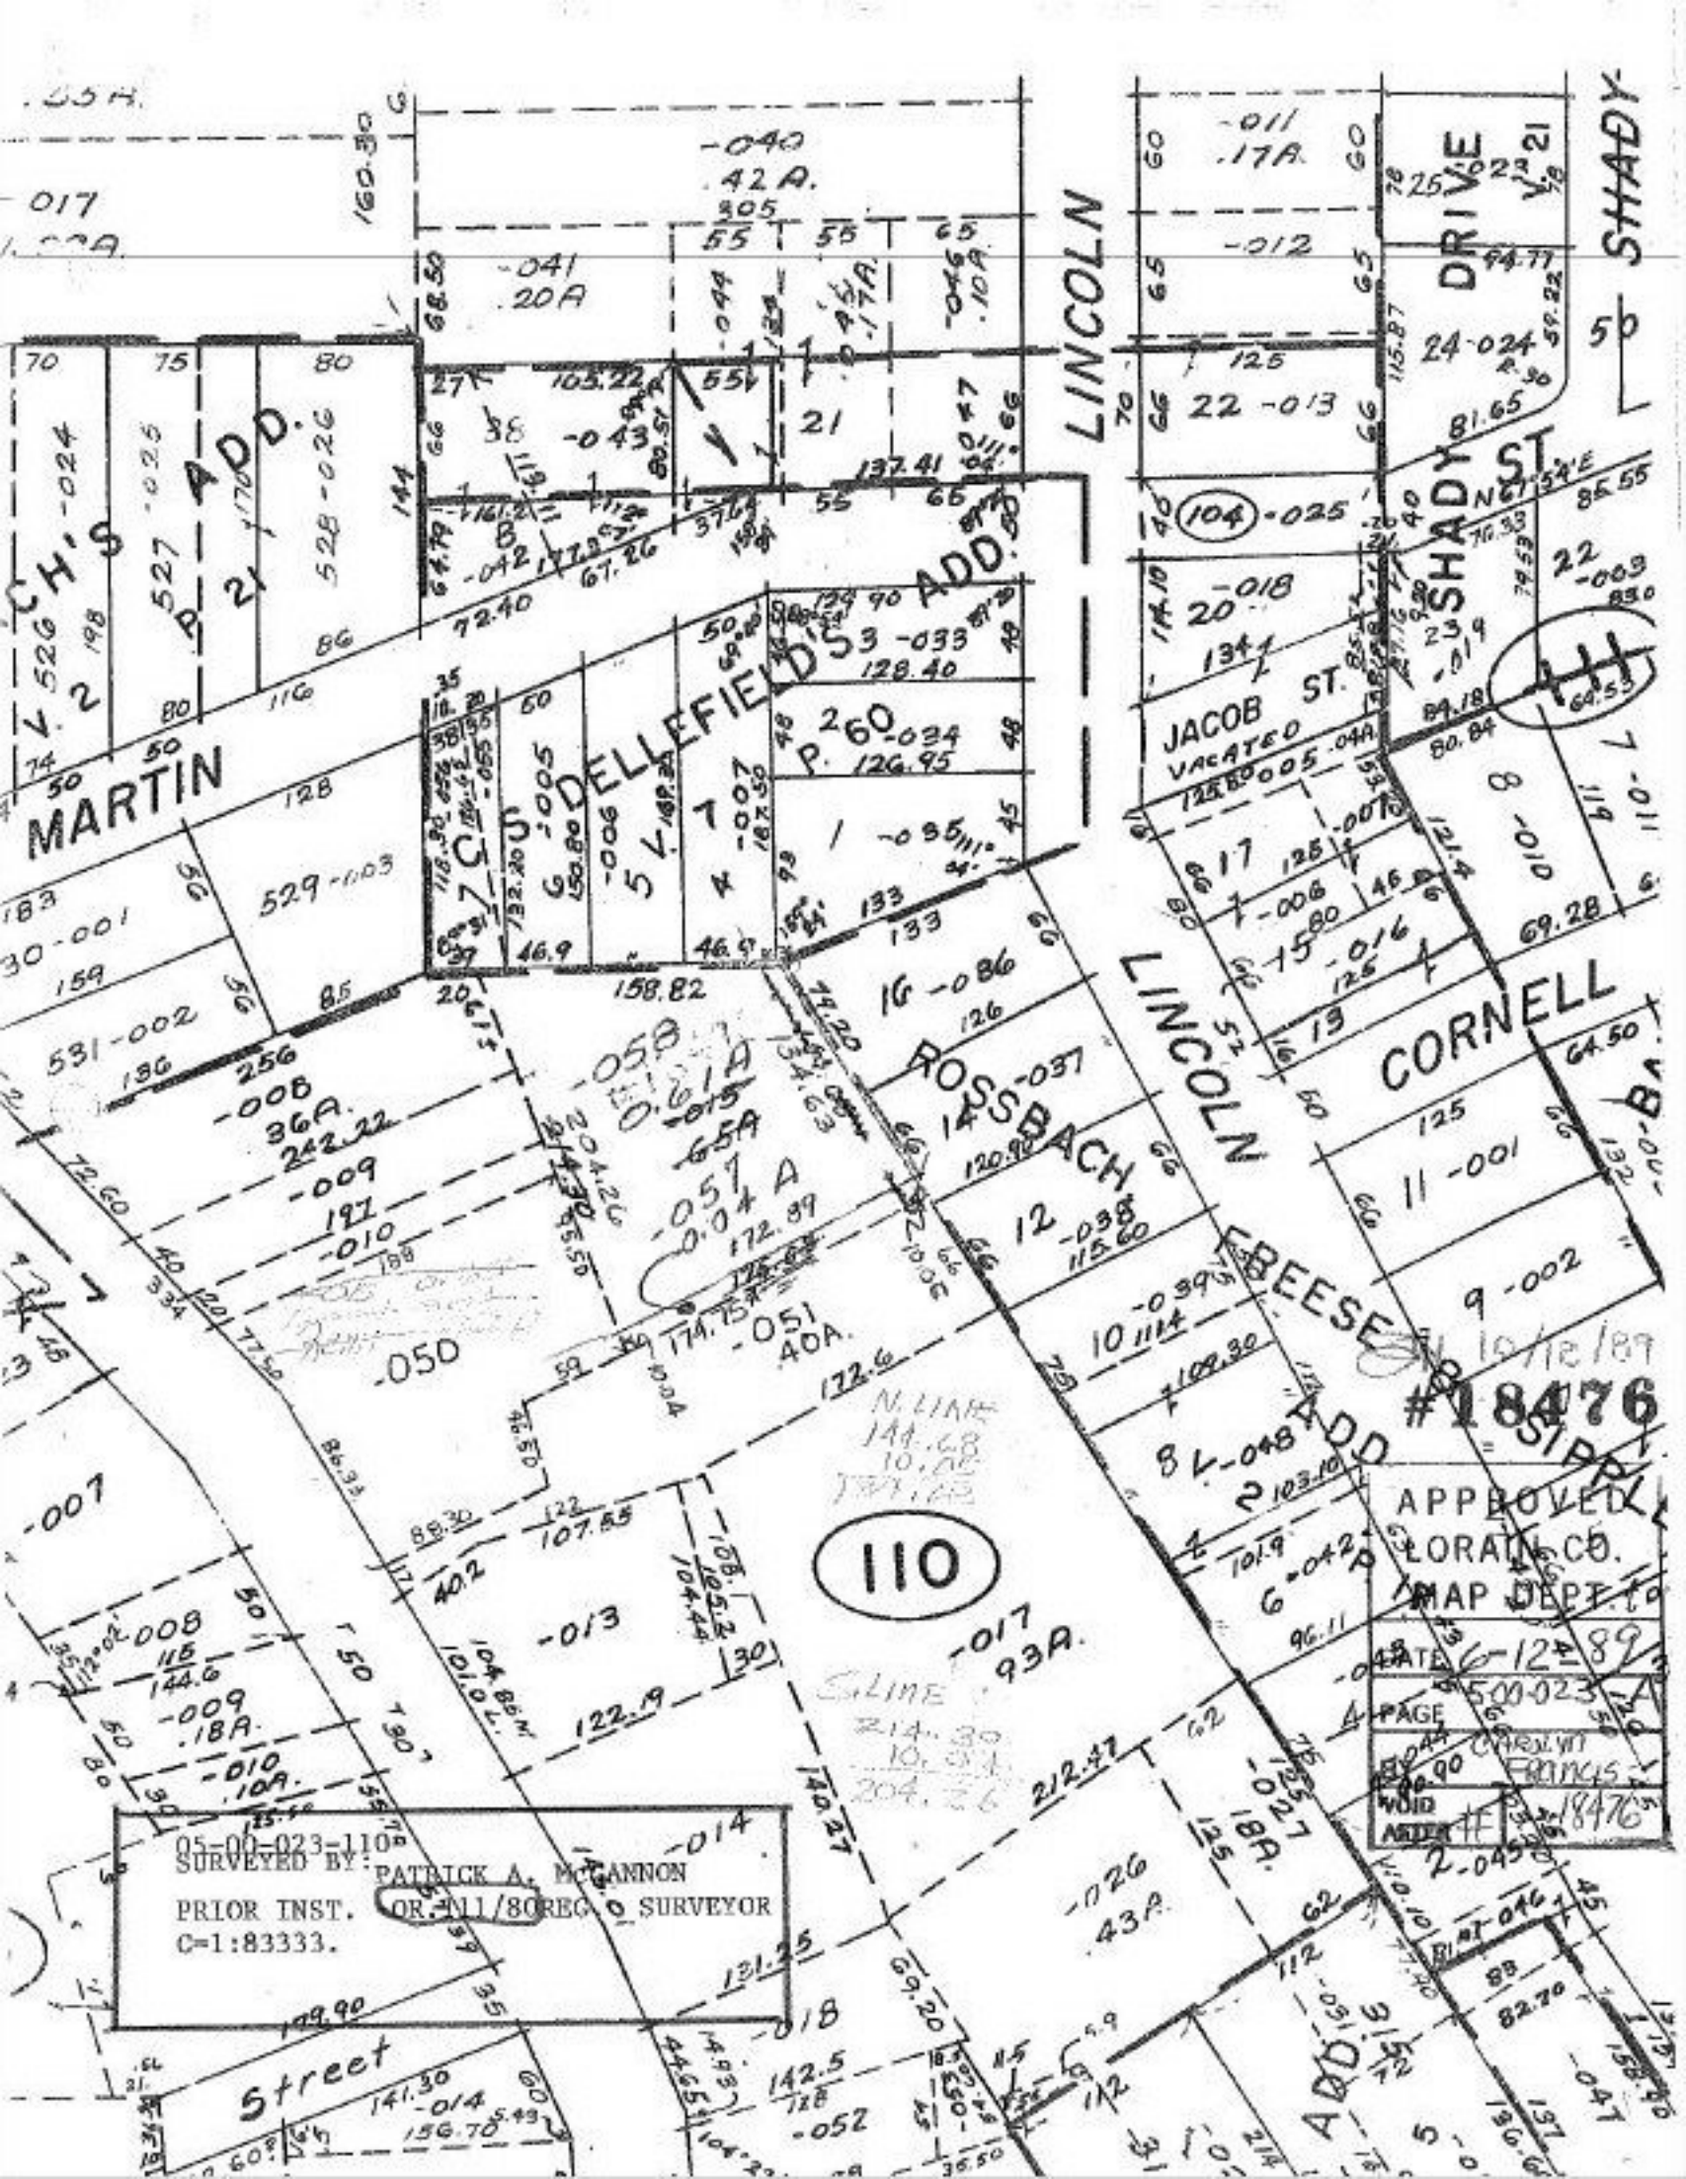

LINCOLN
SHADY DRIVE
SHADY ST.
JACOB ST.
VACATED
MARTIN
C.S. DELLEFIELD'S ADD.
ROSSBACH
CORNELL
FREESE ADD.
Street
110
#18476
APPROVED
LORAIN CO.
MAP DEPT.
DATE 6-12-89
PAGE 5-00-023
VOID
AFTER #18476
05-00-023-110
SURVEYED BY: PATRICK A. McCANNON
PRIOR INST. OR. 111/80 REG. SURVEYOR
C=1:83333.