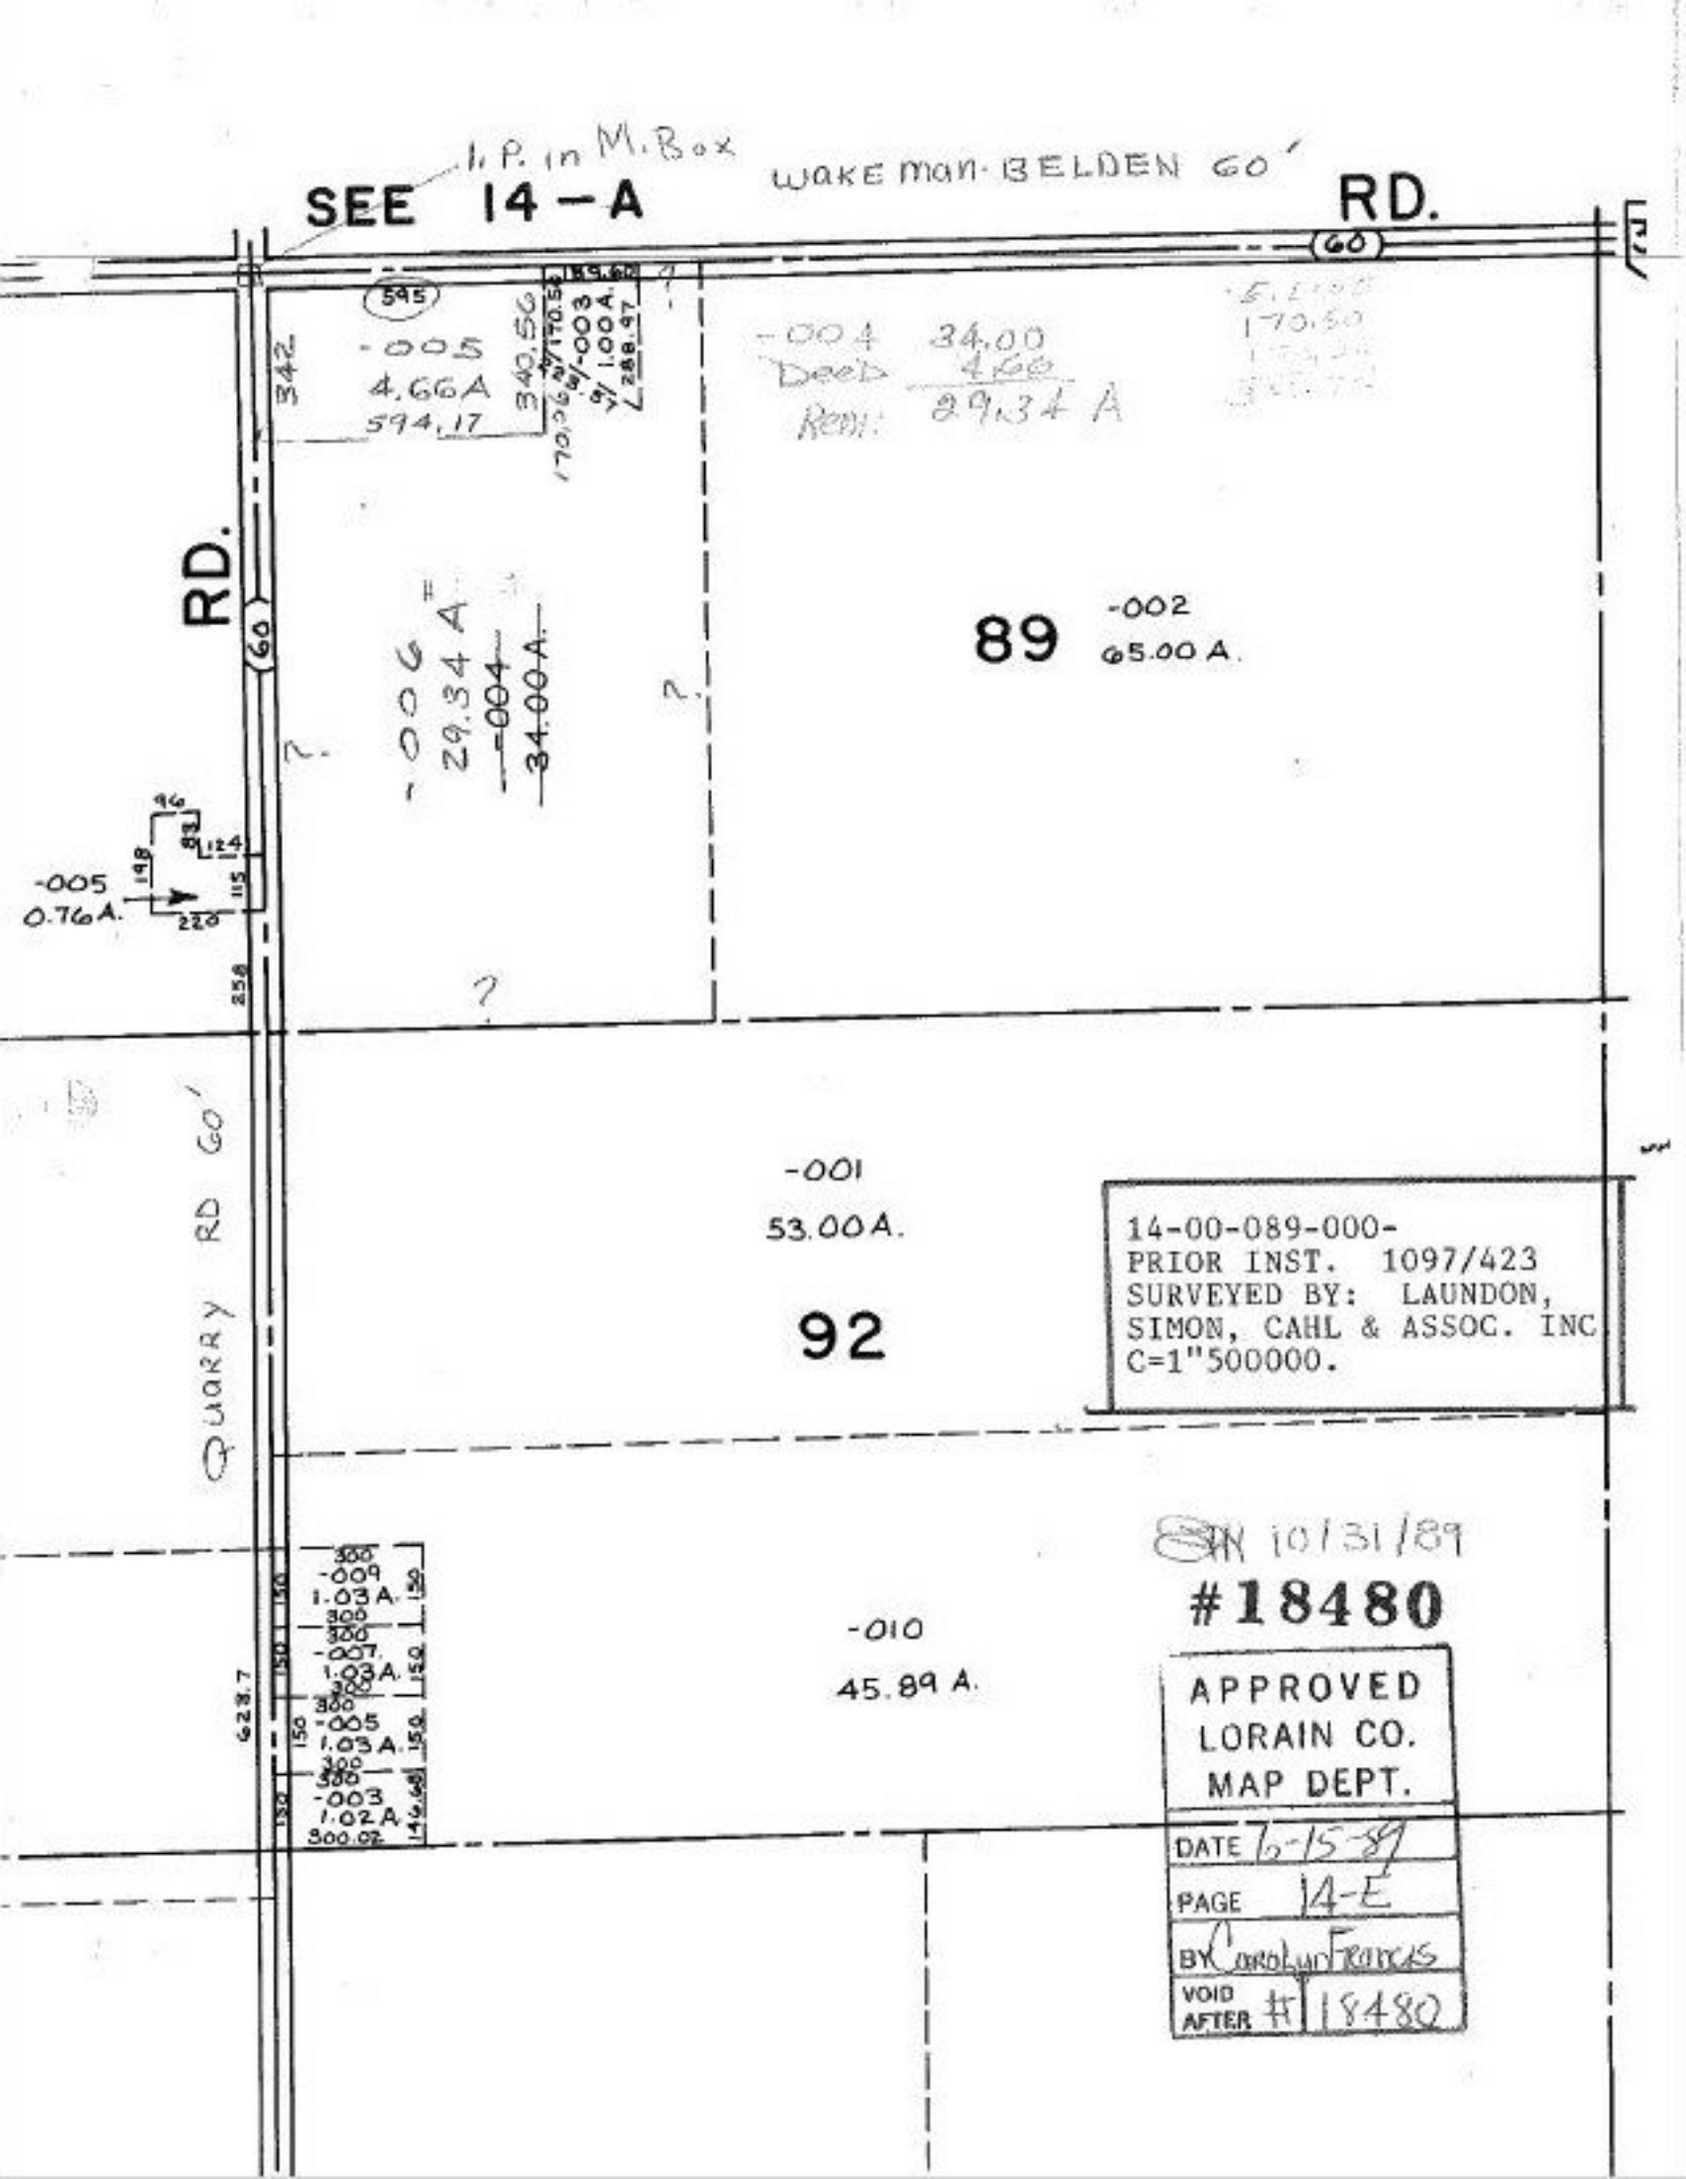

I.P. in M.Box
SEE 14-A
WAKEMAN-BELDEN 60'
RD.
60
595
-005
4.66A
594.17
342
340.56
170.56
-003
1.00A.
288.97
-004 34.00
Deed 4.66
Rem: 29.34 A
RD.
60
-006
29.34 A
-004
34.00 A.
89
-002
65.00 A.
-005
0.76A.
96
83
124
198
115
220
258
QUARRY RD 60'
-001
53.00A.
92
14-00-089-000-
PRIOR INST. 1097/423
SURVEYED BY: LAUNDON,
SIMON, CAHL & ASSOC. INC
C=1"500000.
10/31/89
#18480
-009
1.03A.
300
-007
1.03A.
300
-005
1.03A.
300
-003
1.02A.
300.02
150
628.7
-010
45.89 A.
APPROVED
LORAIN CO.
MAP DEPT.
DATE 6-15-89
PAGE 14-E
BY Carolyn Francis
VOID AFTER # 18480