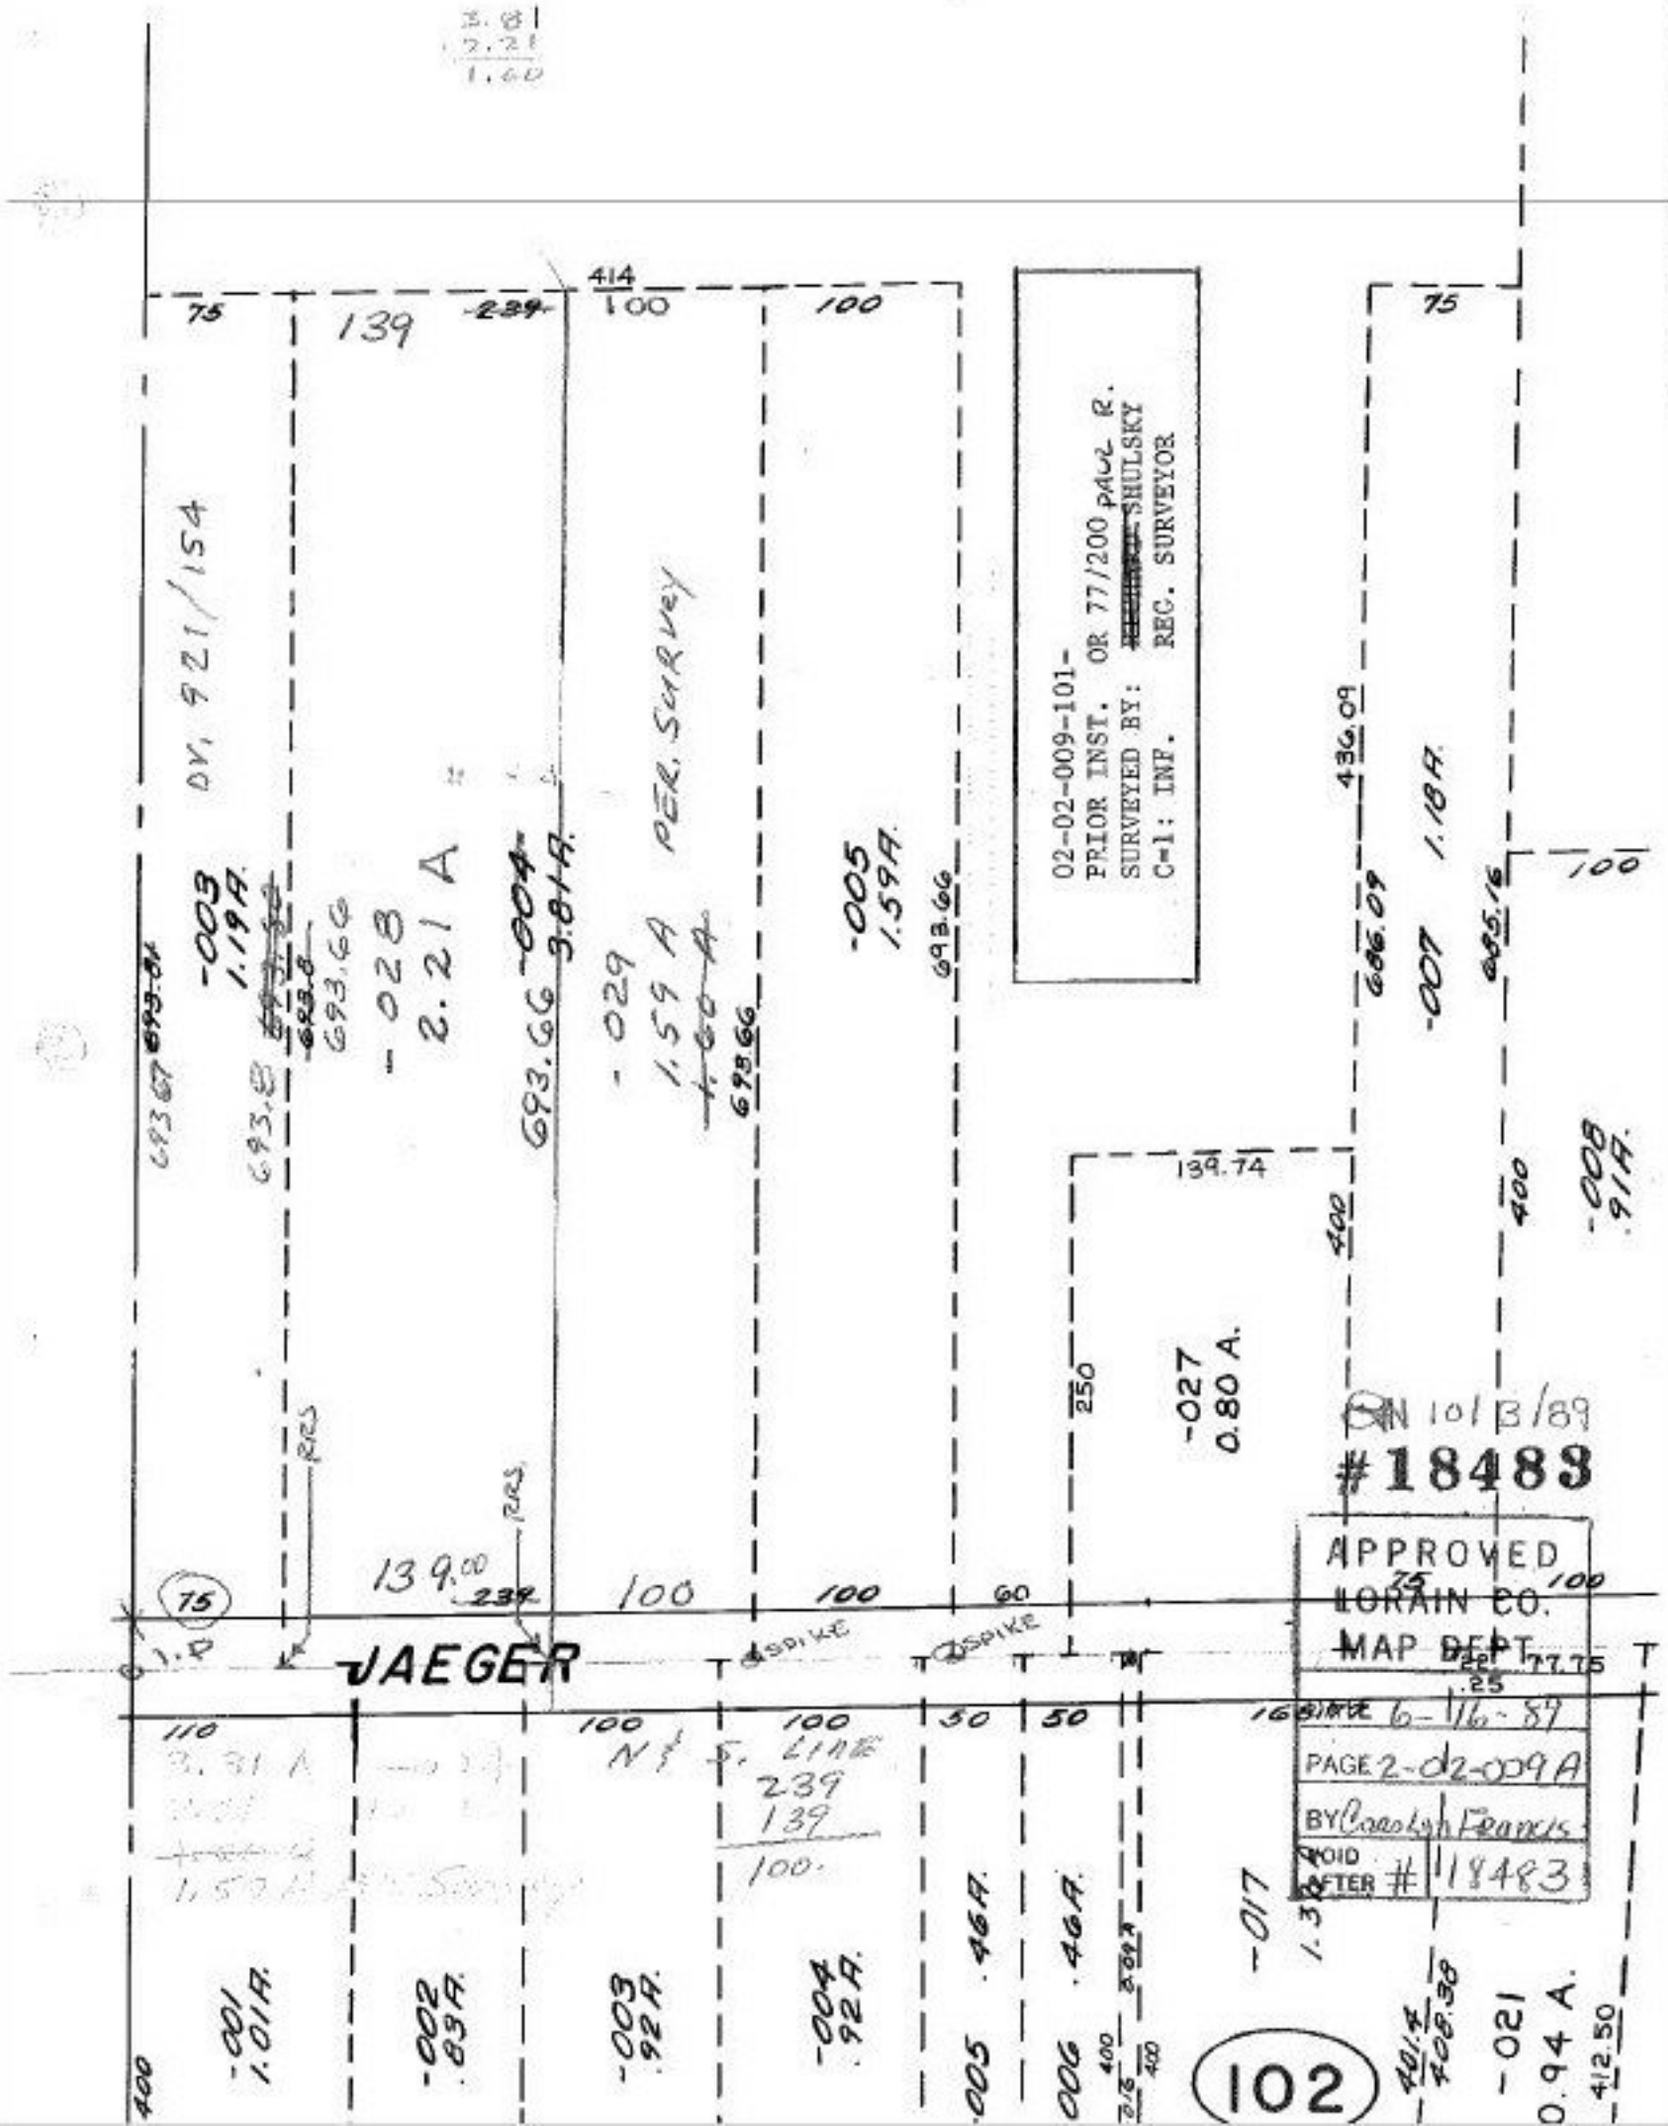

N 10/3/89
#18483
APPROVED
LORAIN CO.
MAP DEPT.
DATE 6-16-89
PAGE 2-02-009A
BY Carolyn Francis
VOID AFTER # 18483