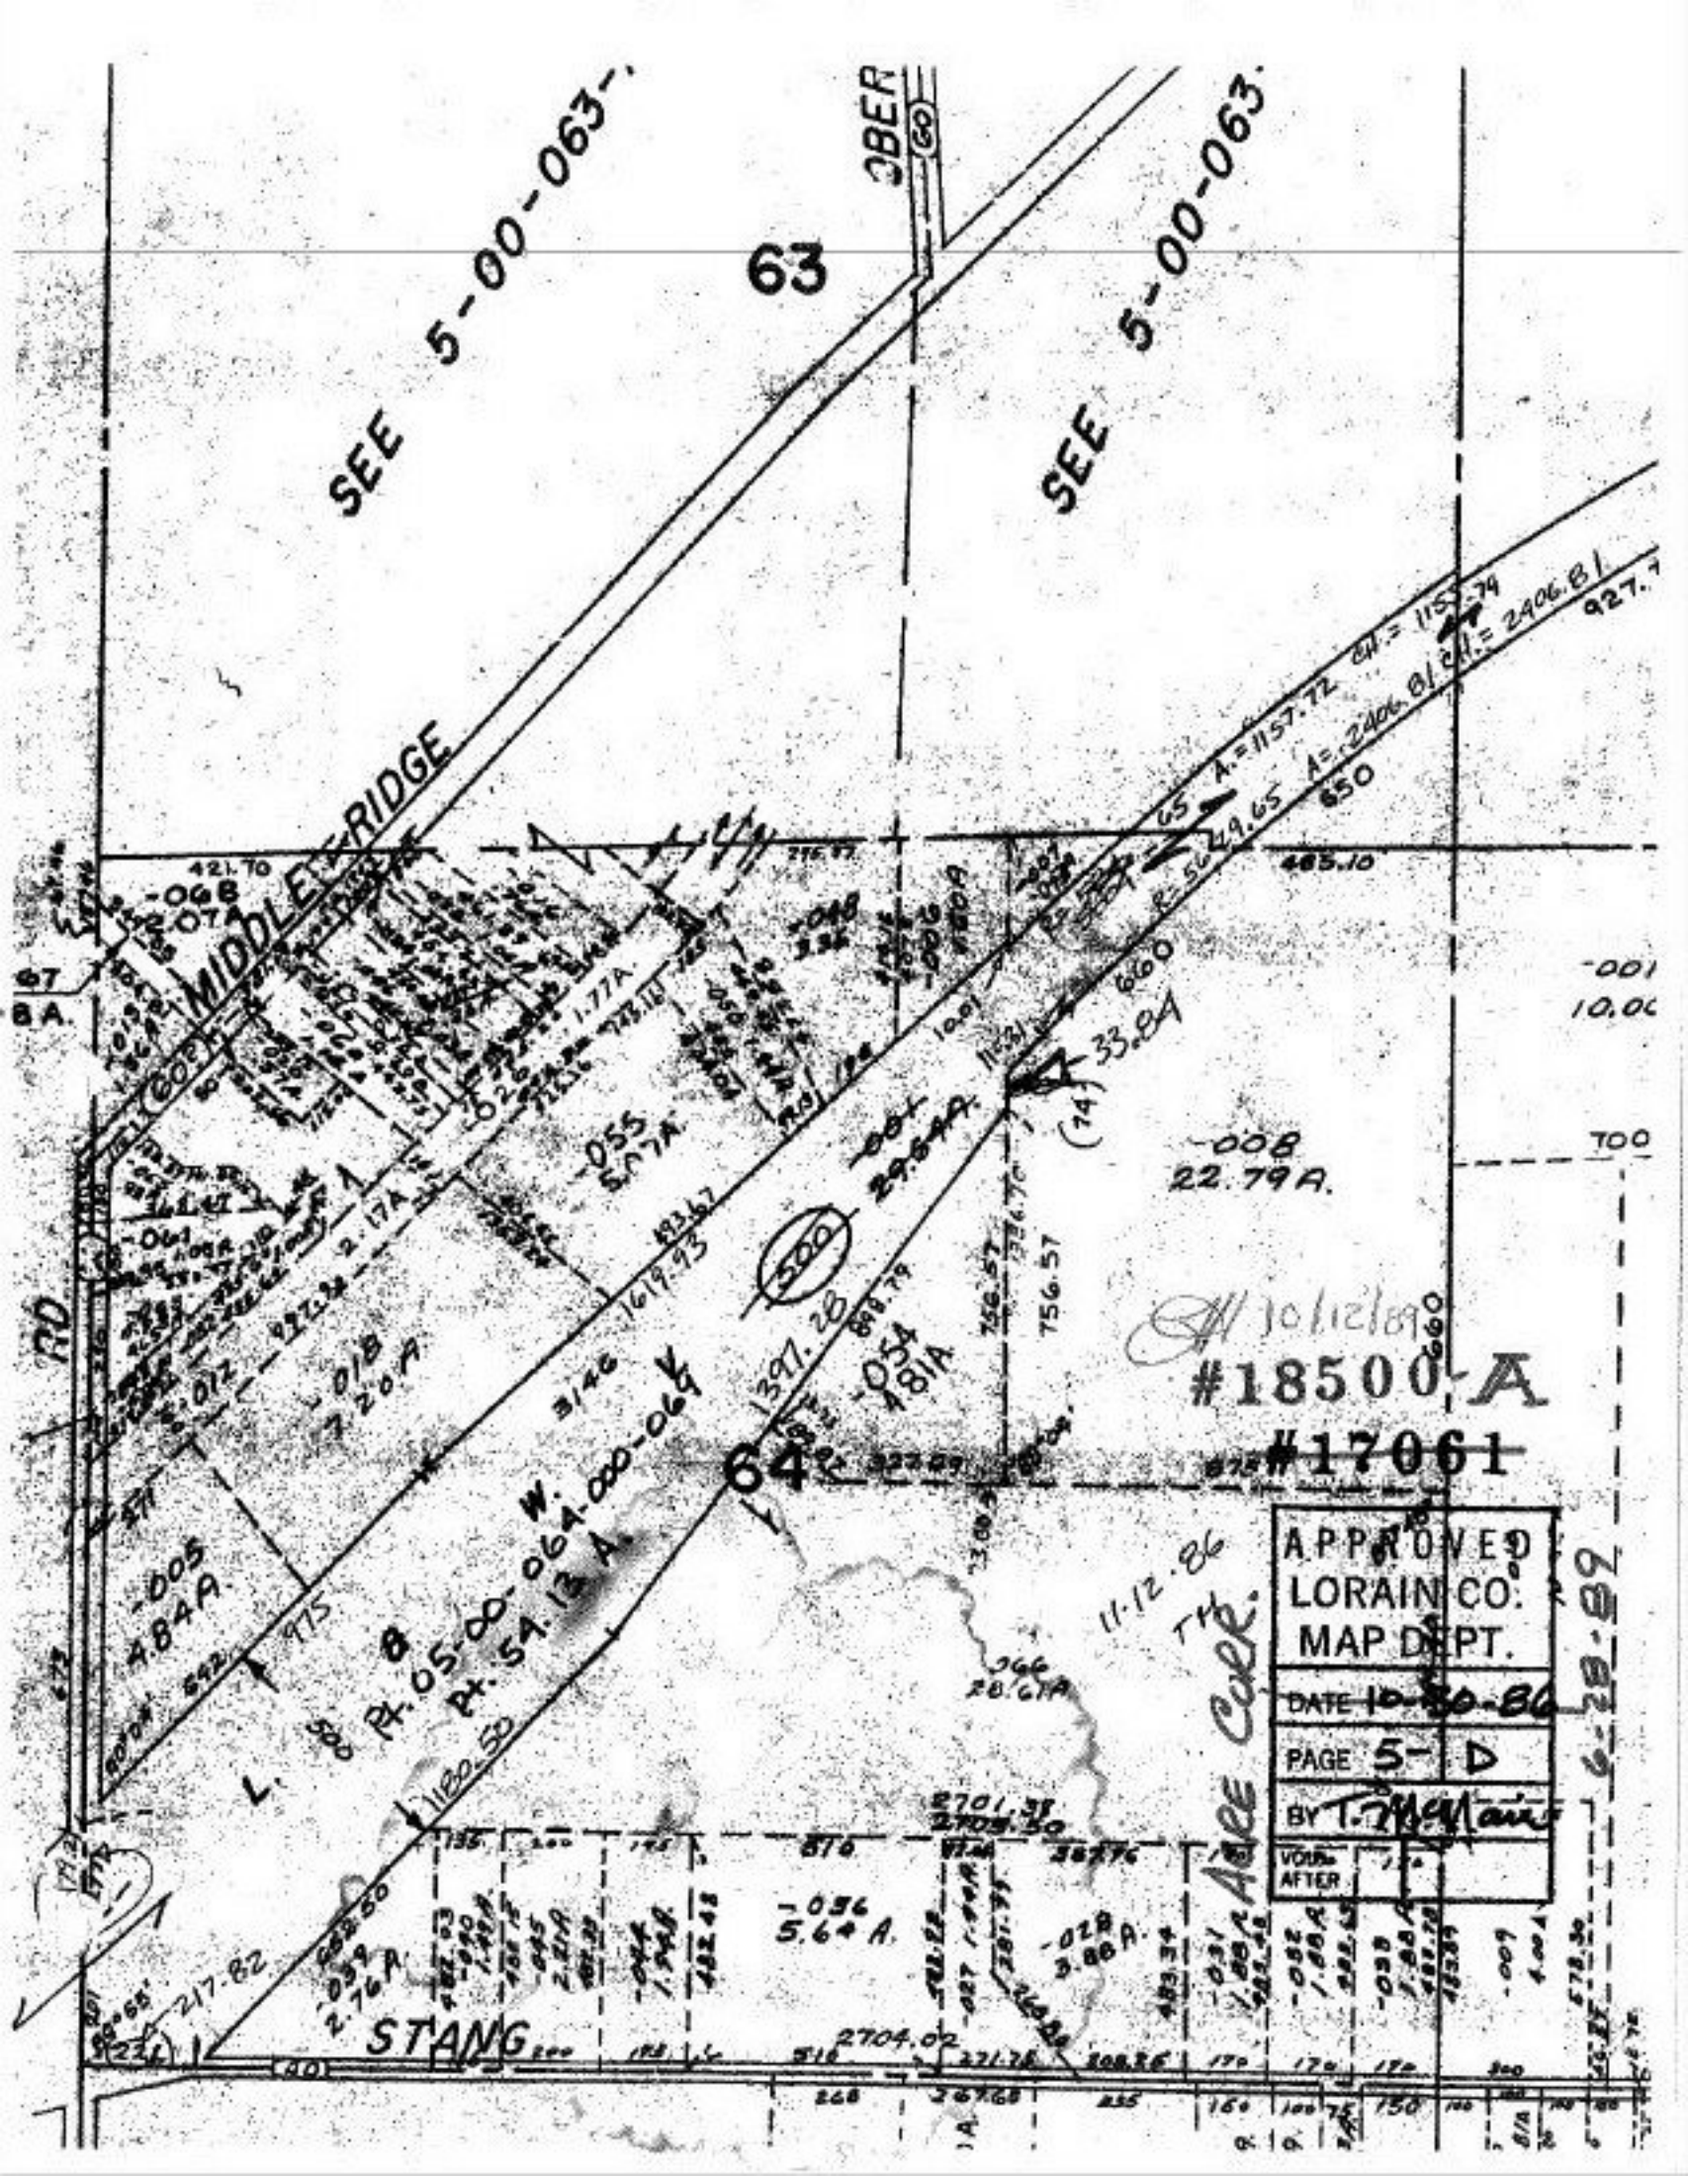
SEE 5-00-063-
SEE 5-00-063.
63
64
MIDDLE RIDGE
STANG
Alee Cuer.
#18500-A
#17061
APPROVED
LORAIN CO.
MAP DEPT.
DATE 10-30-86
PAGE 5- D
BY T. McMann
VOIDS AFTER
11-12-86
6-28-89