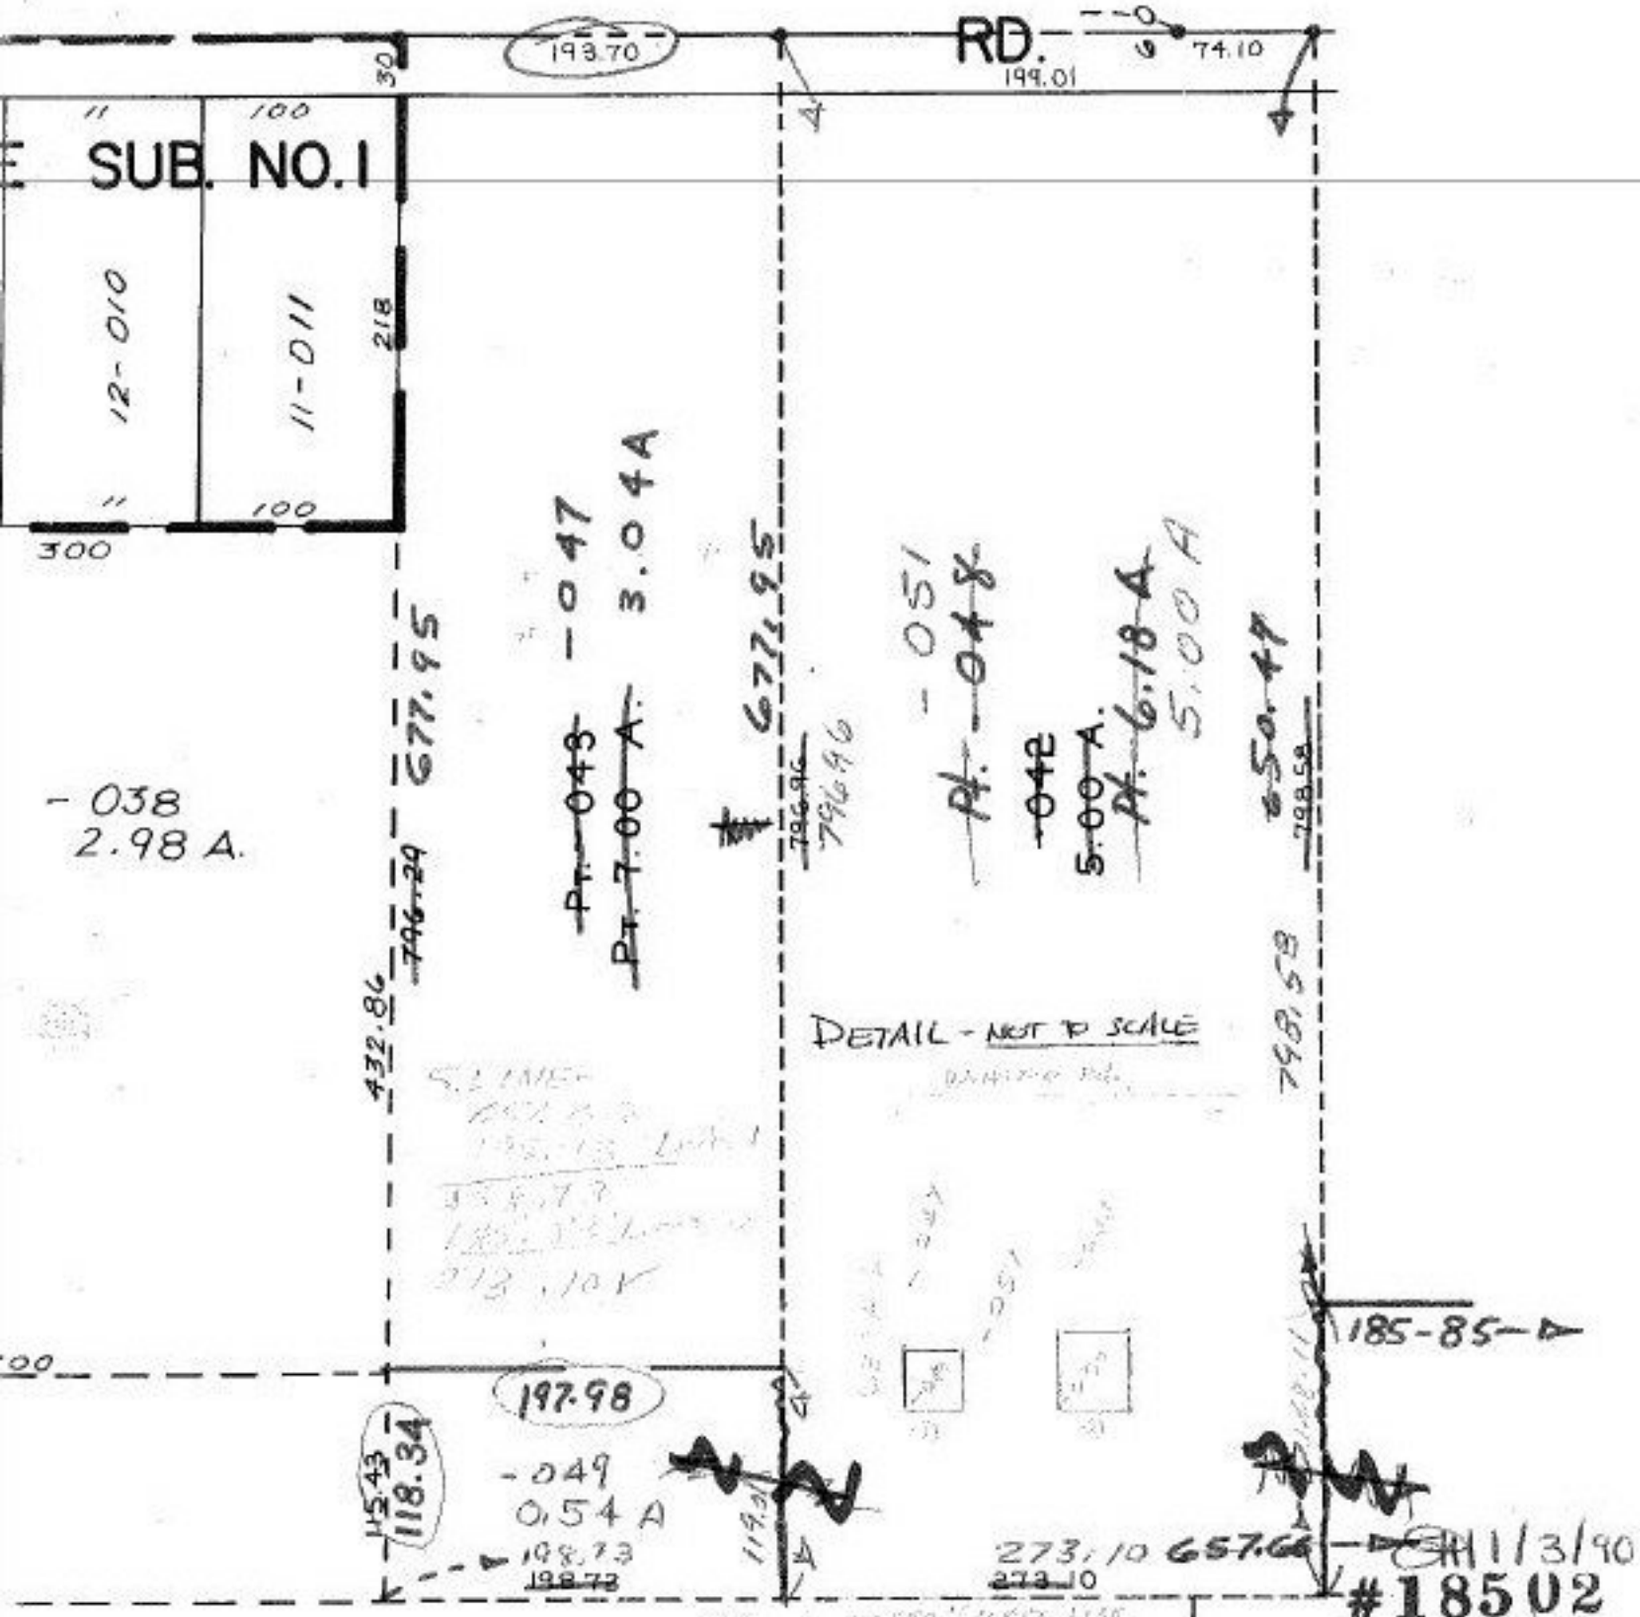

#18502

19-06-118-B

APPROVED
LORAIN CO.
MAP DEPT.

DATE 6-27-89
PAGE 19-06-118-A
BY Carolyn Francis
VOID AFTER # 18502

(1) -048 6.18
0.54
Rem: 5.64

19-06-118-000-
PRIOR INST. O R.186/574
SURVEYED BY:KS ASSOC. INC.
C=1:50000. DAVID L. ELWELL
C=1:142857. REG. SURVEYOR