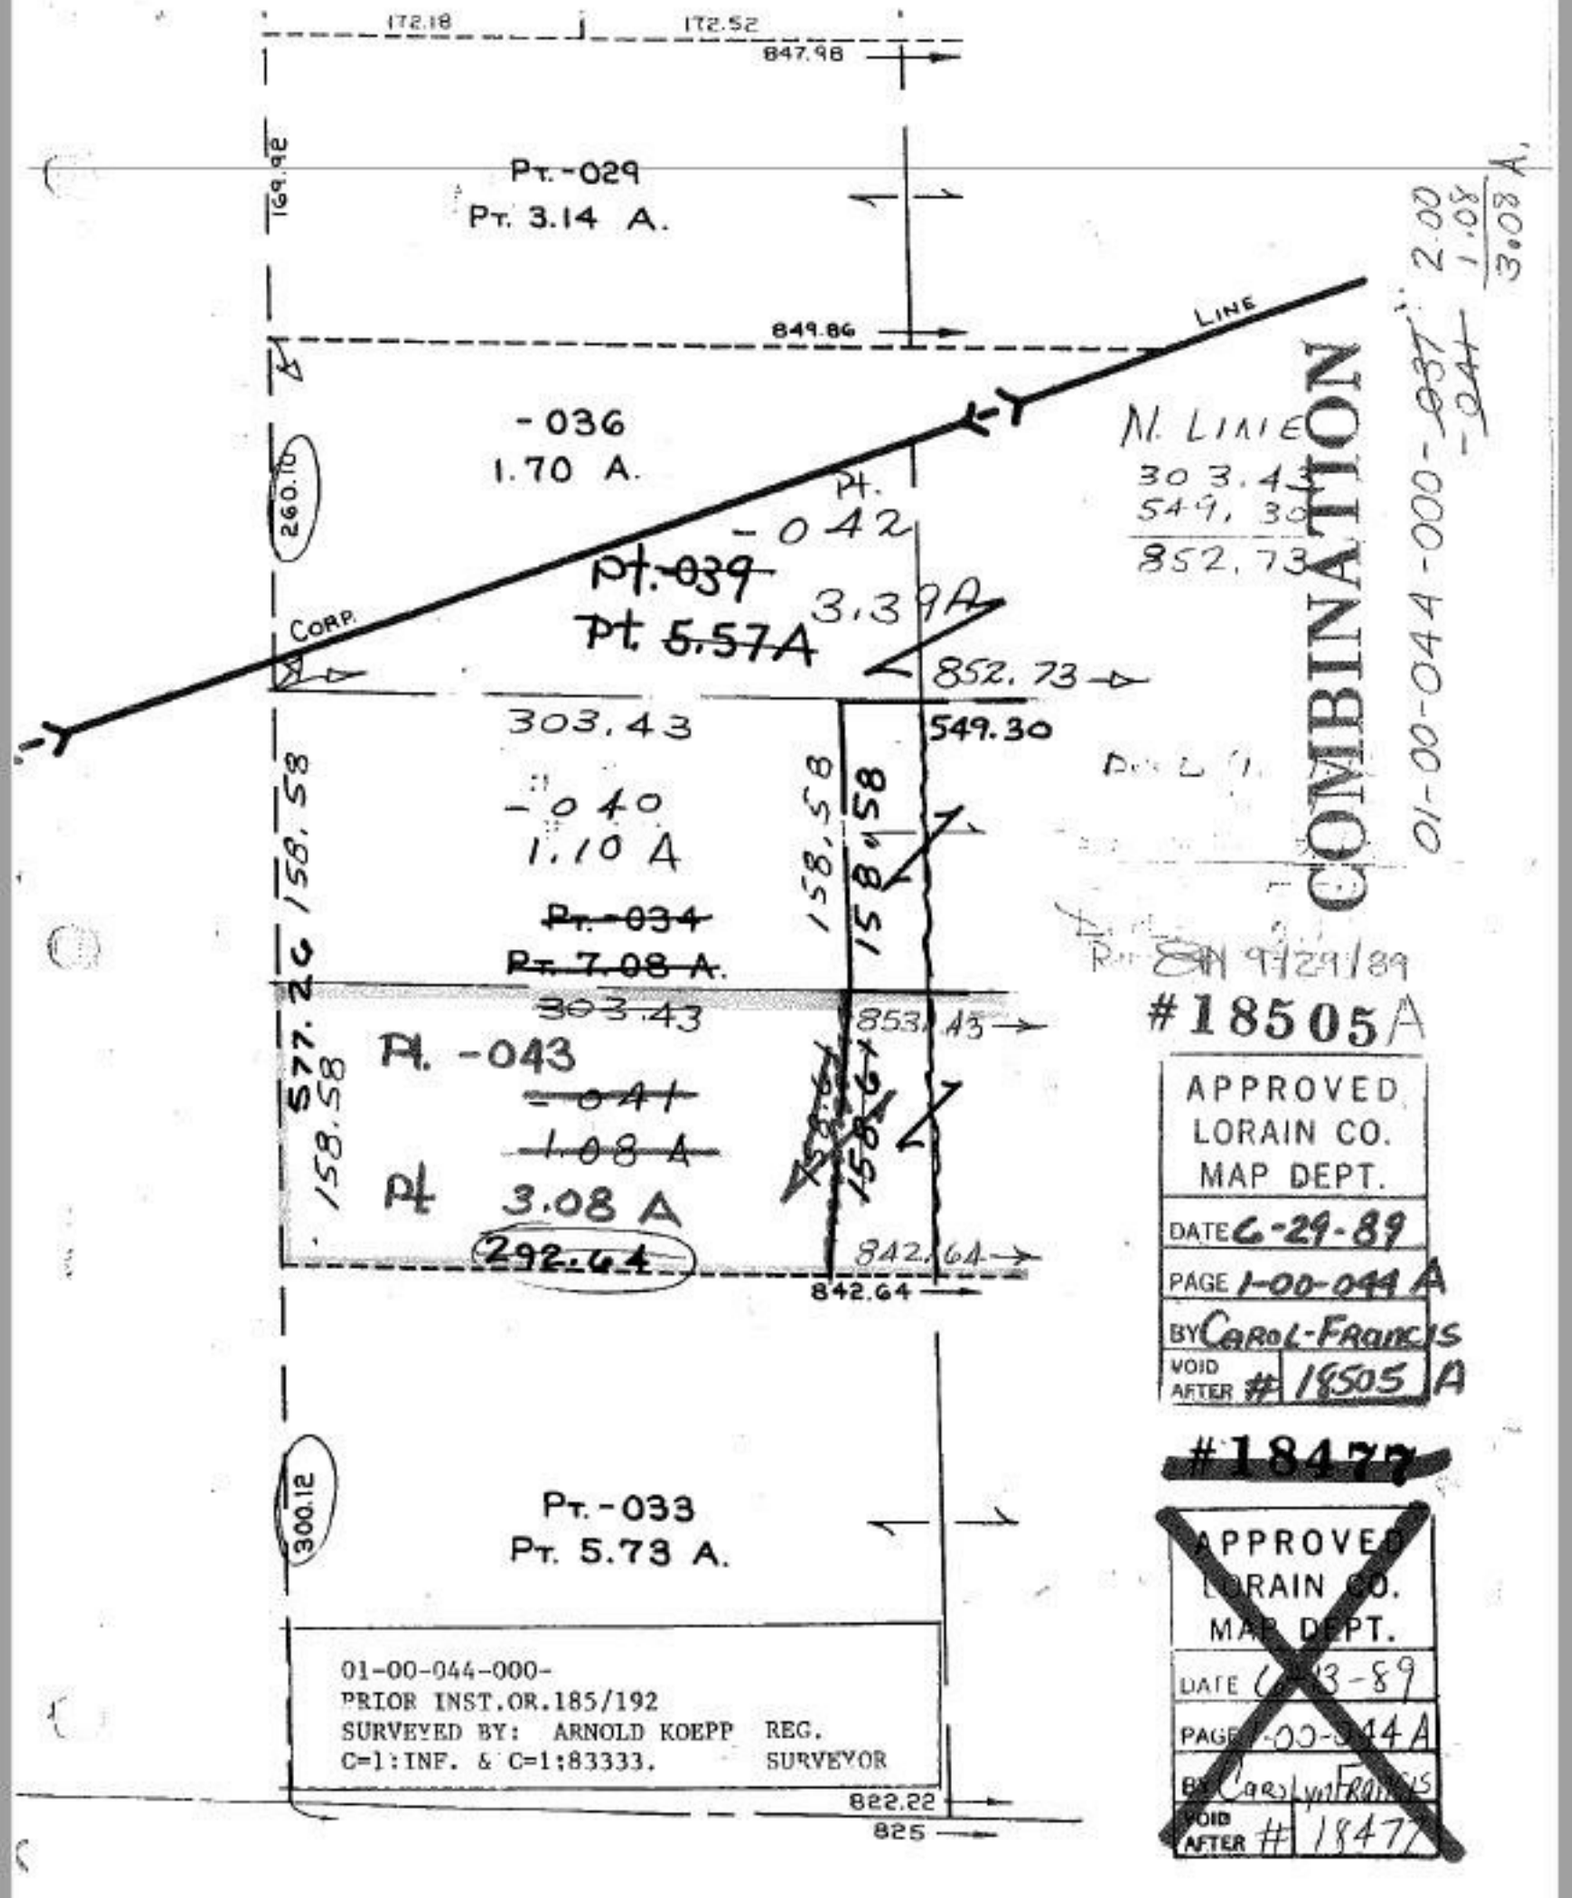
172.18
172.52
847.98
169.92
Pt.-029
Pt. 3.14 A.
849.86
LINE
-036
1.70 A.
260.10
Pt.
-042
Pt.-039
Pt. 5.57A
3.39A
CORP.
852.73
303.43
549.30
158.58
-040
1.10 A
Pt.-034
Pt. 7.08 A.
303.43
853.43
577.26
158.58
Pt. -043
-041
1.08 A
Pt 3.08 A
292.64
842.64
842.64
300.12
Pt.-033
Pt. 5.73 A.
01-00-044-000-
PRIOR INST.OR.185/192
SURVEYED BY: ARNOLD KOEPP REG.
C=1:INF. & C=1:83333. SURVEYOR
822.22
825
N. LINE
303.43
549.30
852.73
COMBINATION
01-00-044-000-037 2.00
-041 1.08
-042 3.08 A.
#18505A
APPROVED
LORAIN CO.
MAP DEPT.
DATE 6-29-89
PAGE 1-00-044 A
BY CAROL-FRANCIS
VOID AFTER # 18505 A
#18477
APPROVED
LORAIN CO.
MAP DEPT.
DATE 6-23-89
PAGE 1-00-044 A
BY Carol-Francis
VOID AFTER # 18477