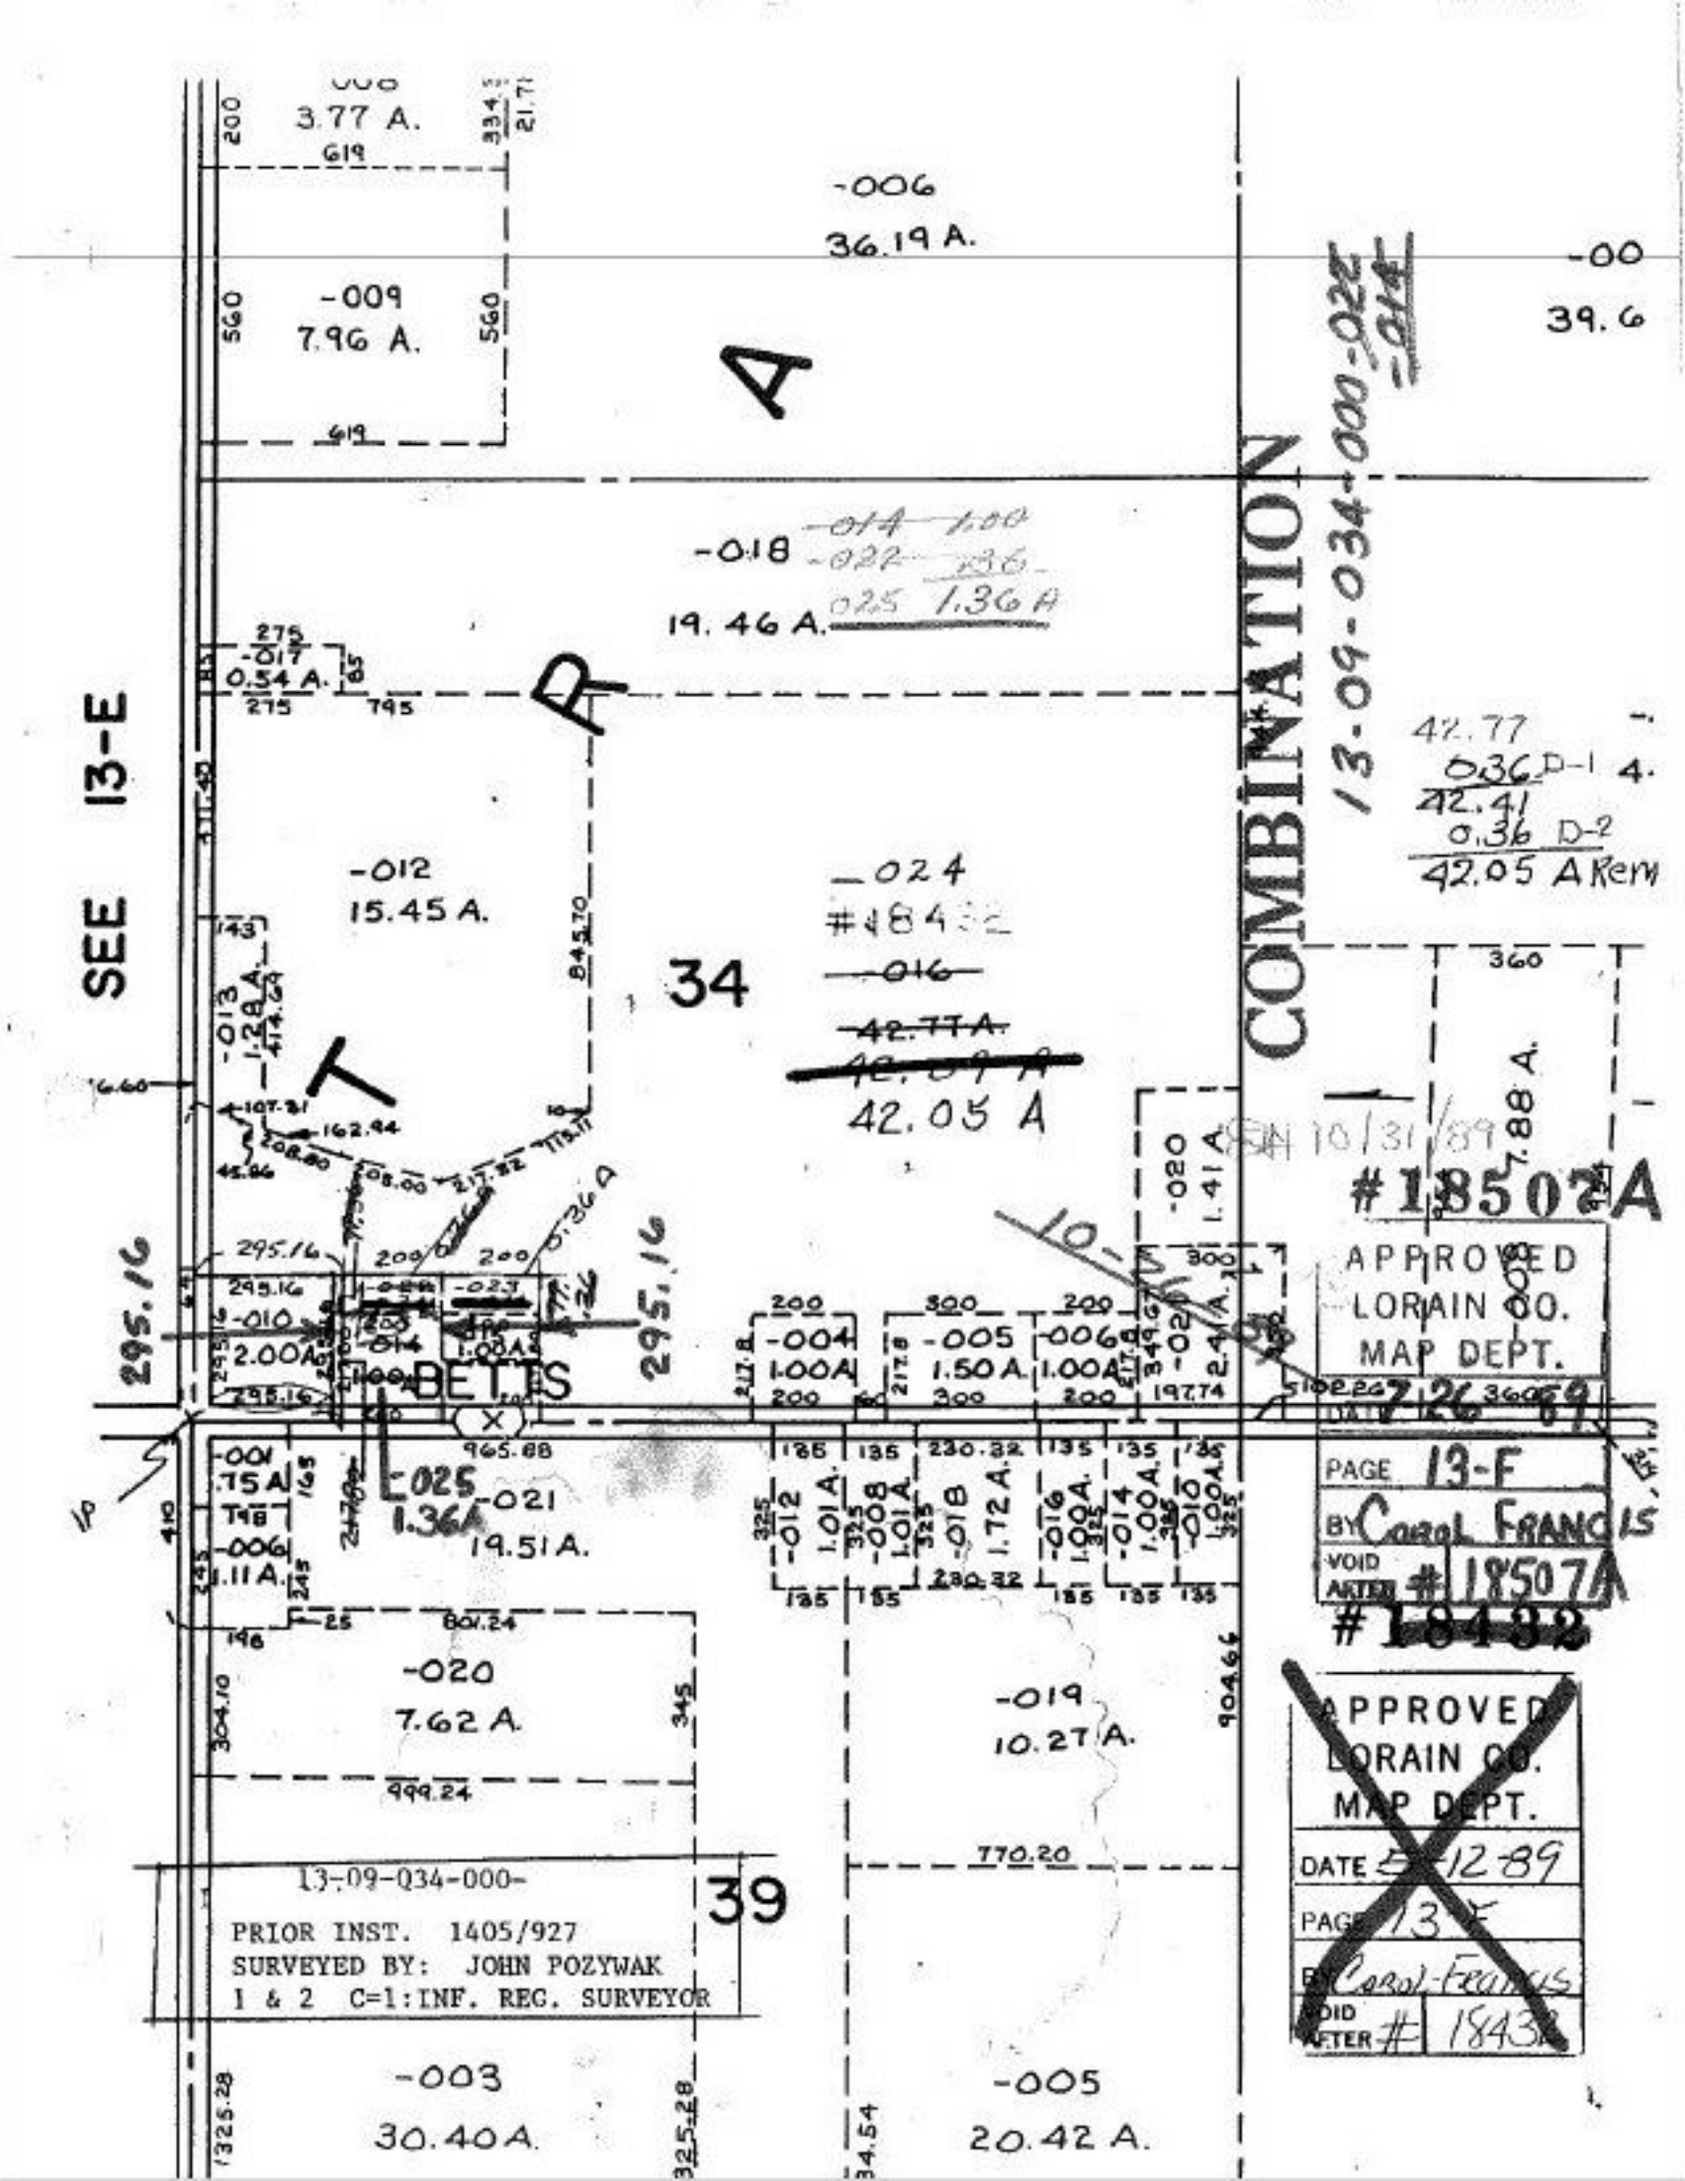
SEE 13-E
COMBINATION
13-09-034-000-022
-006
36.19 A.
-009
7.96 A.
-018
19.46 A.
-017
0.54 A.
-012
15.45 A.
-013
1.28 A.
-024
42.05 A
-020
1.41 A.
-004
1.00A
-005
1.50 A.
-006
1.00A
-001
.75 A
-006
1.11 A.
-025
1.36A
-021
19.51 A.
-020
7.62 A.
-019
10.27 A.
-003
30.40 A.
-005
20.42 A.
BETTS
34
39
13-09-034-000-
PRIOR INST. 1405/927
SURVEYED BY: JOHN POZYWAK
1 & 2 C=1: INF. REG. SURVEYOR
APPROVED
LORAIN CO.
MAP DEPT.
DATE 7-26-89
PAGE 13-F
BY Carol Francis
VOID AFTER # 18507A
#18502A
#18432
APPROVED
LORAIN CO.
MAP DEPT.
DATE 5-12-89
PAGE 13-F
BY Carol Francis
VOID AFTER # 18432