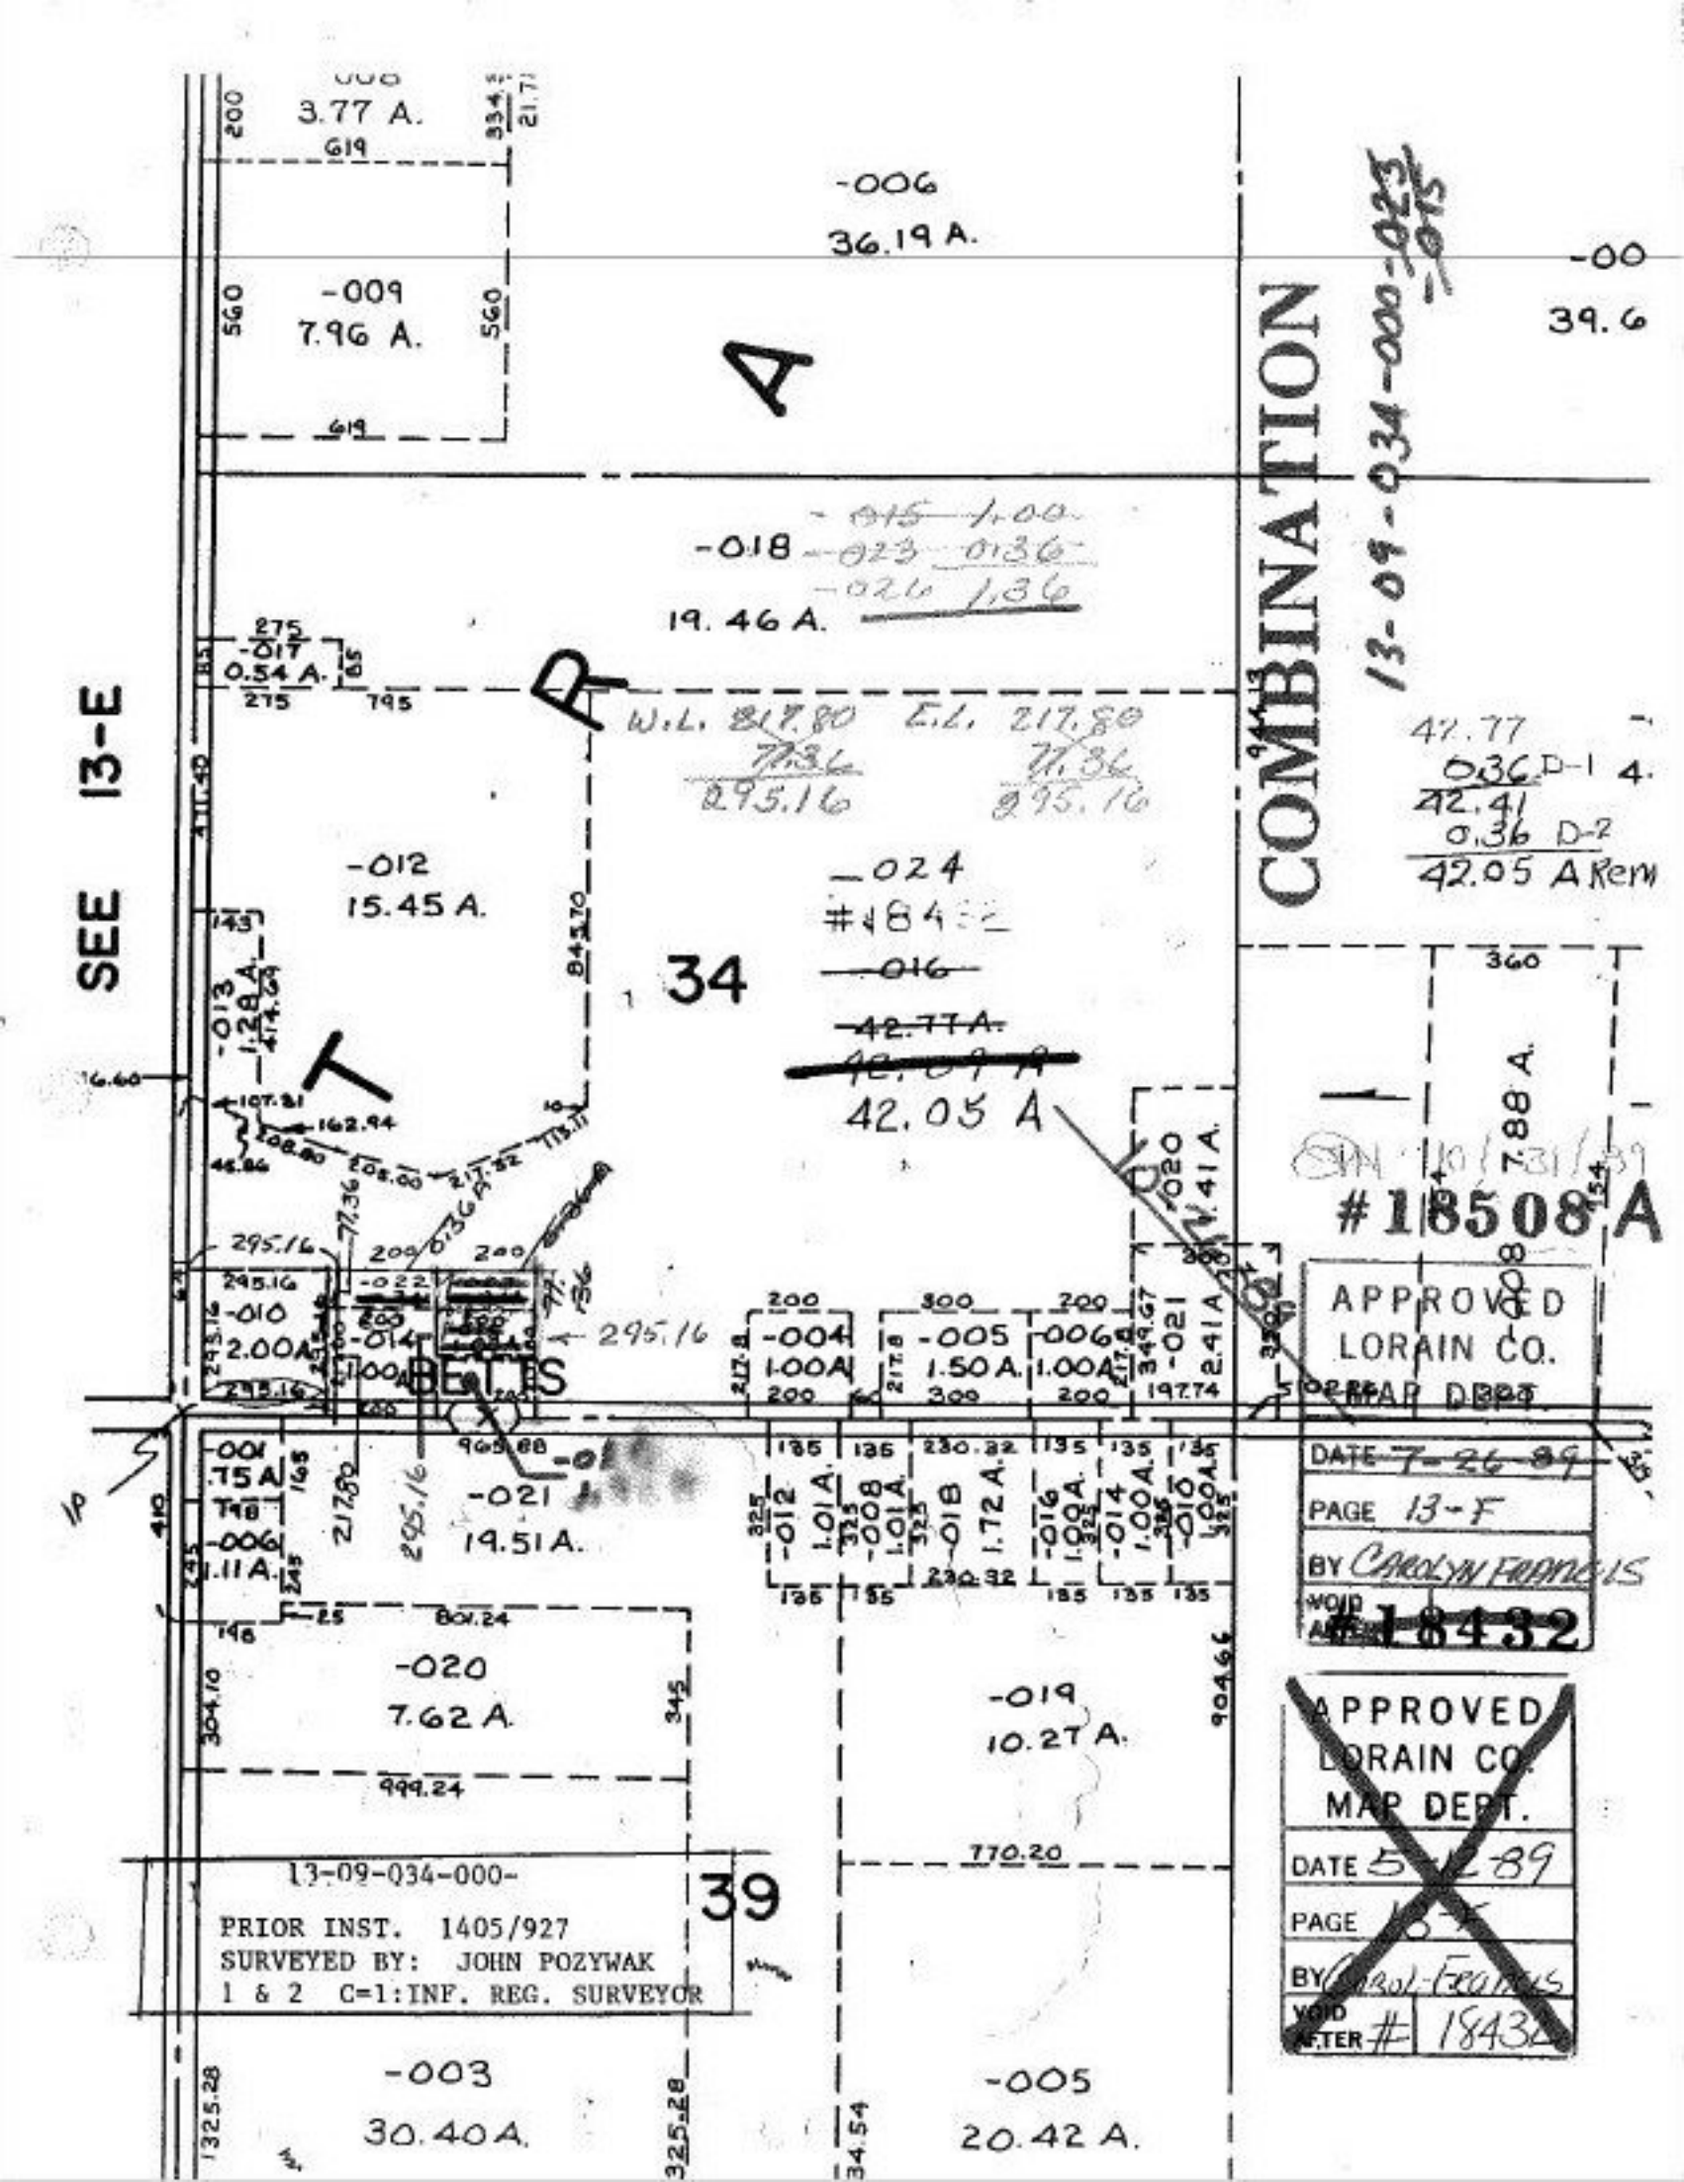
SEE 13-E
COMBINATION
13-09-034-000-023-015
-006
36.19 A.
-009
7.96 A.
3.77 A.
-018 -023 0136
-026 1.36
19.46 A.
-017
0.54 A.
-012
15.45 A.
-024
#18432
-016
42.77 A.
42.05 A
-020
2.41 A.
-013
1.29 A.
-010
2.00 A.
-022
-014
1.00 A.
-004
1.00 A.
-005
1.50 A.
-006
1.00 A.
-021
2.41 A.
-001
.75 A.
T48
-006
1.11 A.
-021
19.51 A.
-012
1.01 A.
-008
1.01 A.
-018
1.72 A.
-016
1.00 A.
-014
1.00 A.
-010
1.00 A.
-020
7.62 A.
-019
10.27 A.
-003
30.40 A.
-005
20.42 A.
7.88 A.
#18508 A
APPROVED
LORAIN CO.
MAP DEPT
DATE 7-26-89
PAGE 13-F
BY CAROLYN FRANCIS
VOID AFTER #18432
APPROVED
LORAIN CO.
MAP DEPT.
DATE 5-12-89
PAGE
BY Carol Francis
VOID AFTER # 18432
13-09-034-000-
PRIOR INST. 1405/927
SURVEYED BY: JOHN POZYWAK
1 & 2 C=1:INF. REG. SURVEYOR
39
BEATTS
34
T
R
A
W.L. 217.80
E.L. 217.80
295.16
42.77
0.36 D-1
42.41
0.36 D-2
42.05 A Rem