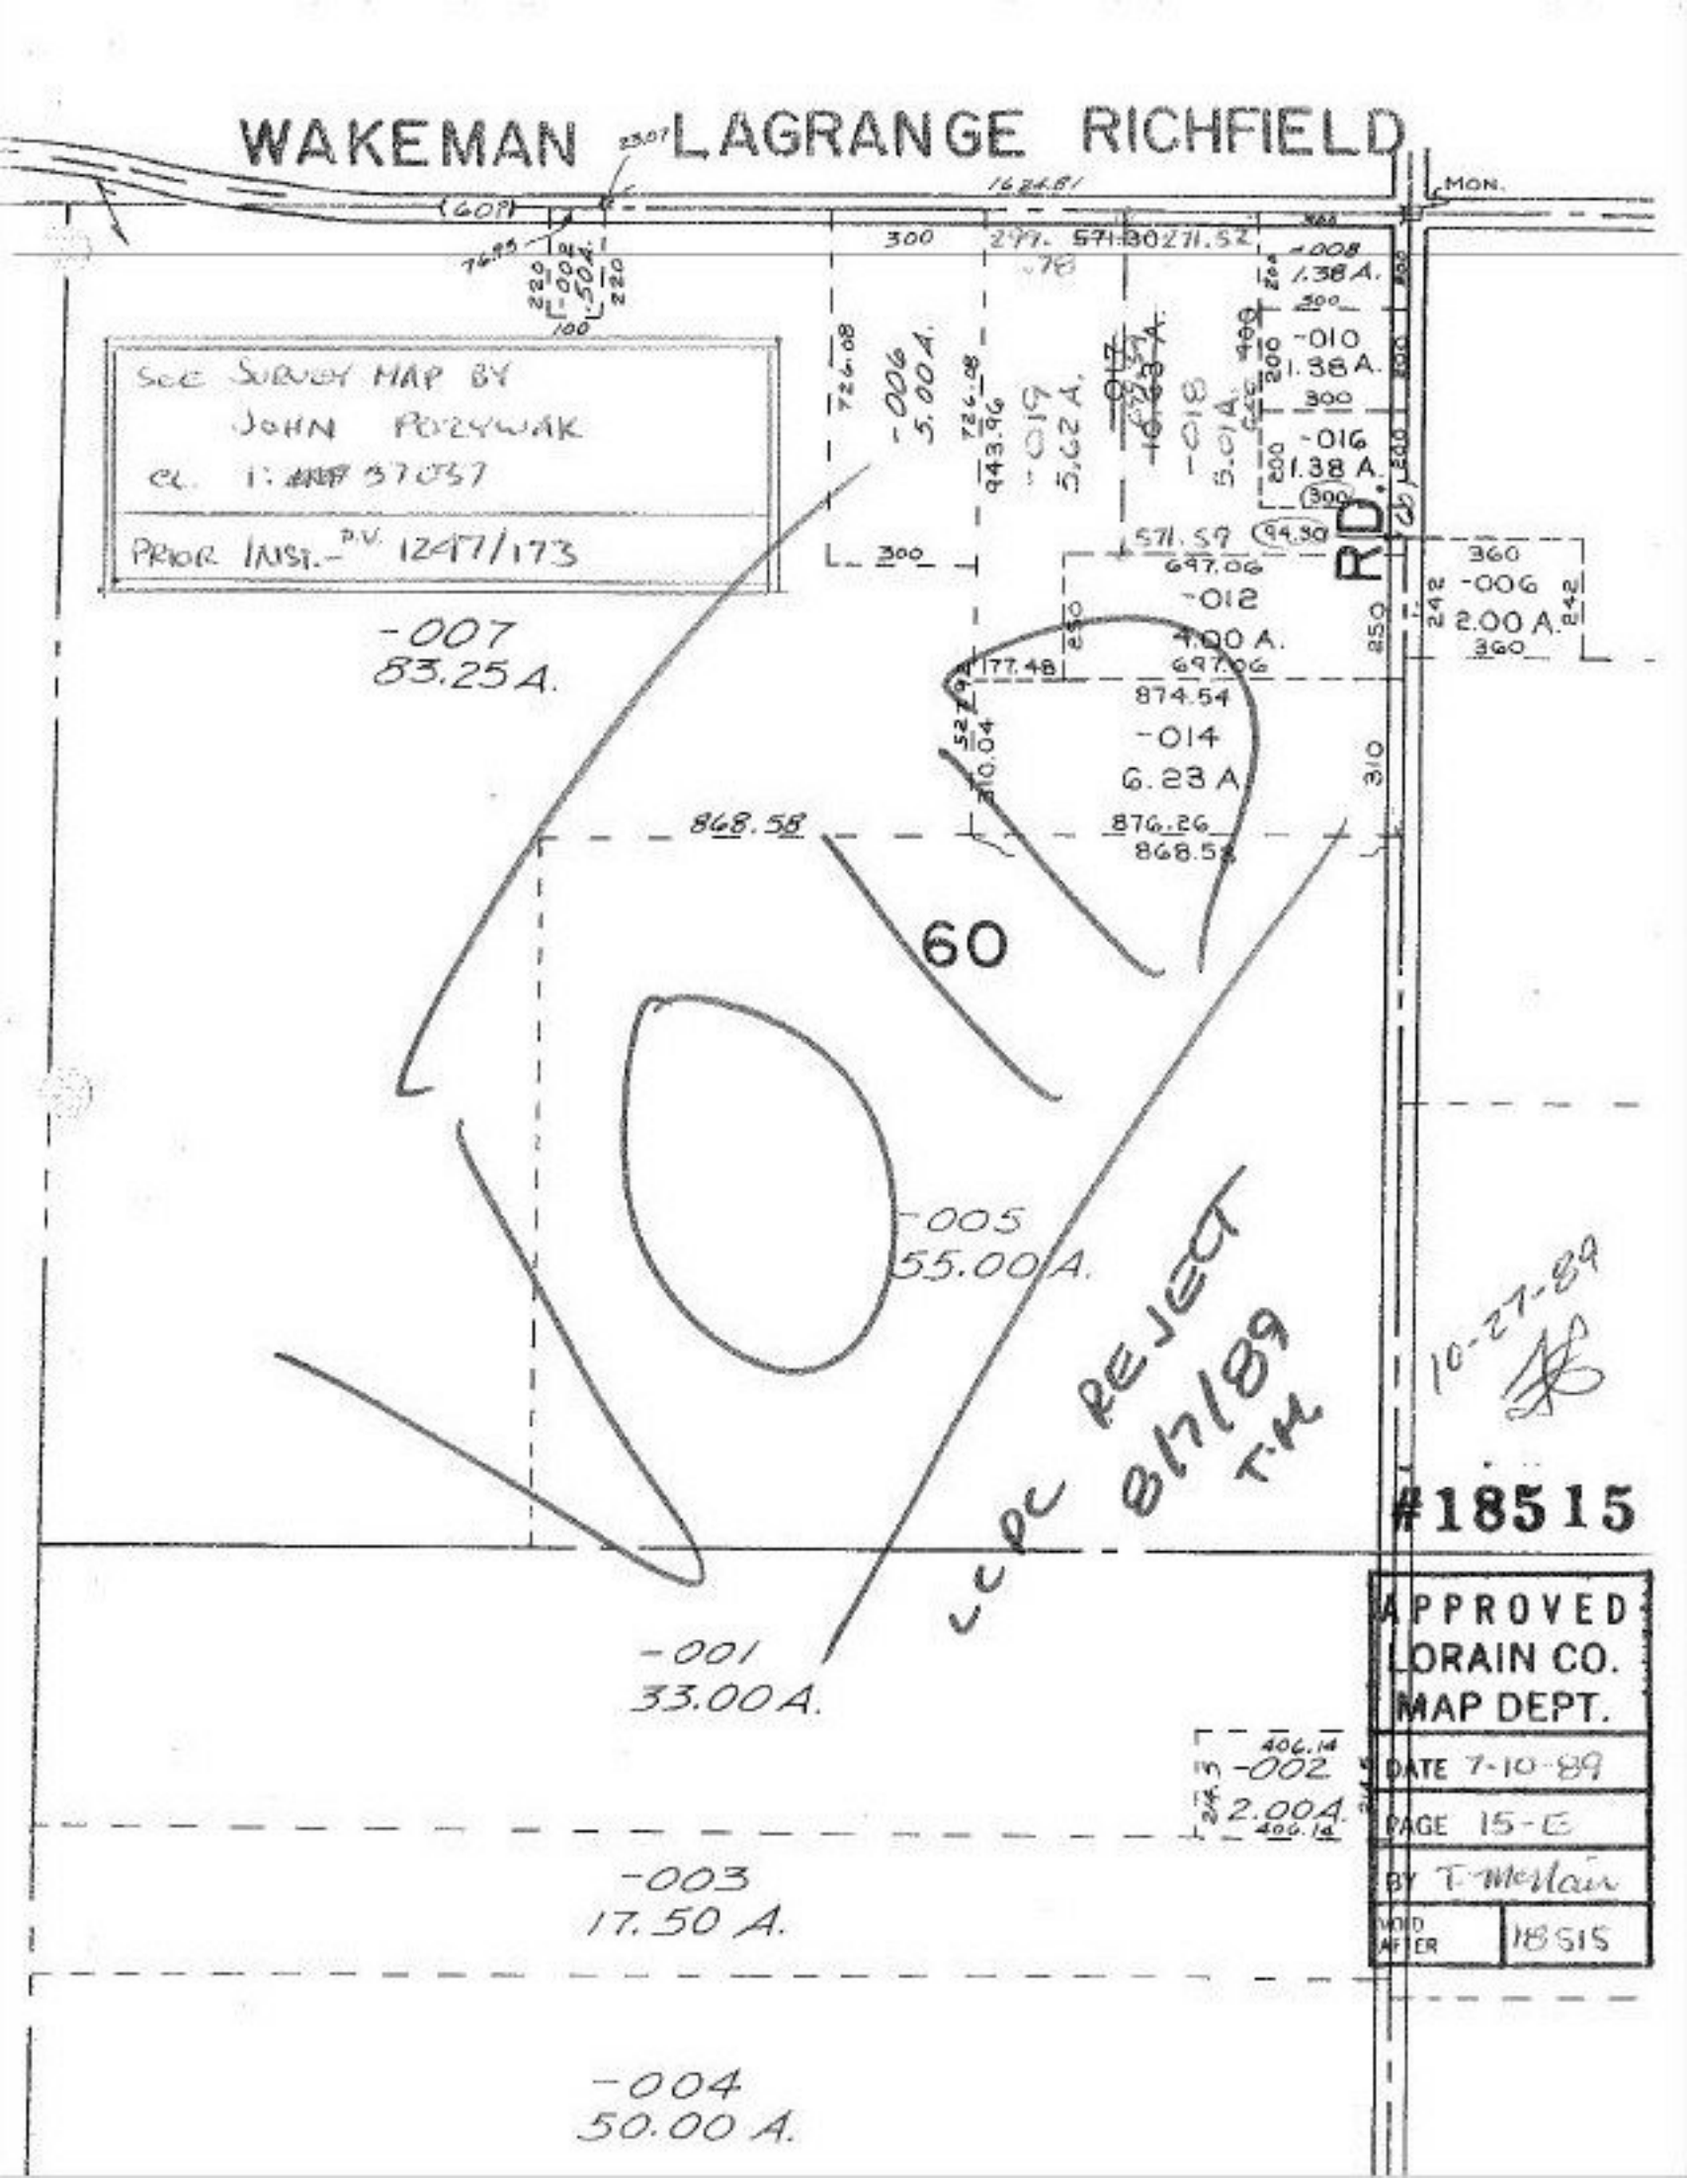
WAKEMAN
LAGRANGE
RICHFIELD
MON.
16.24.81
60th
300
299.78
571.30
271.52
726.08
726.08
943.96
-006
5.00 A.
-017
-019
5.62 A.
-018
5.01 A.
-008
1.38 A.
-010
1.38 A.
-016
1.38 A.
571.59
94.30
697.06
-012
4.00 A.
697.06
177.48
874.54
-014
6.28 A
876.26
868.58
868.58
-007
83.25 A.
60
-005
55.00 A.
-001
33.00 A.
-002
2.00 A.
406.14
406.14
-003
17.50 A.
-004
50.00 A.
R.D.
360
-006
2.00 A.
360
242
242
850
310
SEE SURVEY MAP BY
JOHN PERZYWAK
CL. 1: AMF 37057
PRIOR INST.- D.V. 1247/173
LCPC REJECT
8/7/89
T.M.
10-21-89
#18515
APPROVED
LORAIN CO.
MAP DEPT.
DATE 7-10-89
PAGE 15-E
BY T. McClain
VOID AFTER
18515