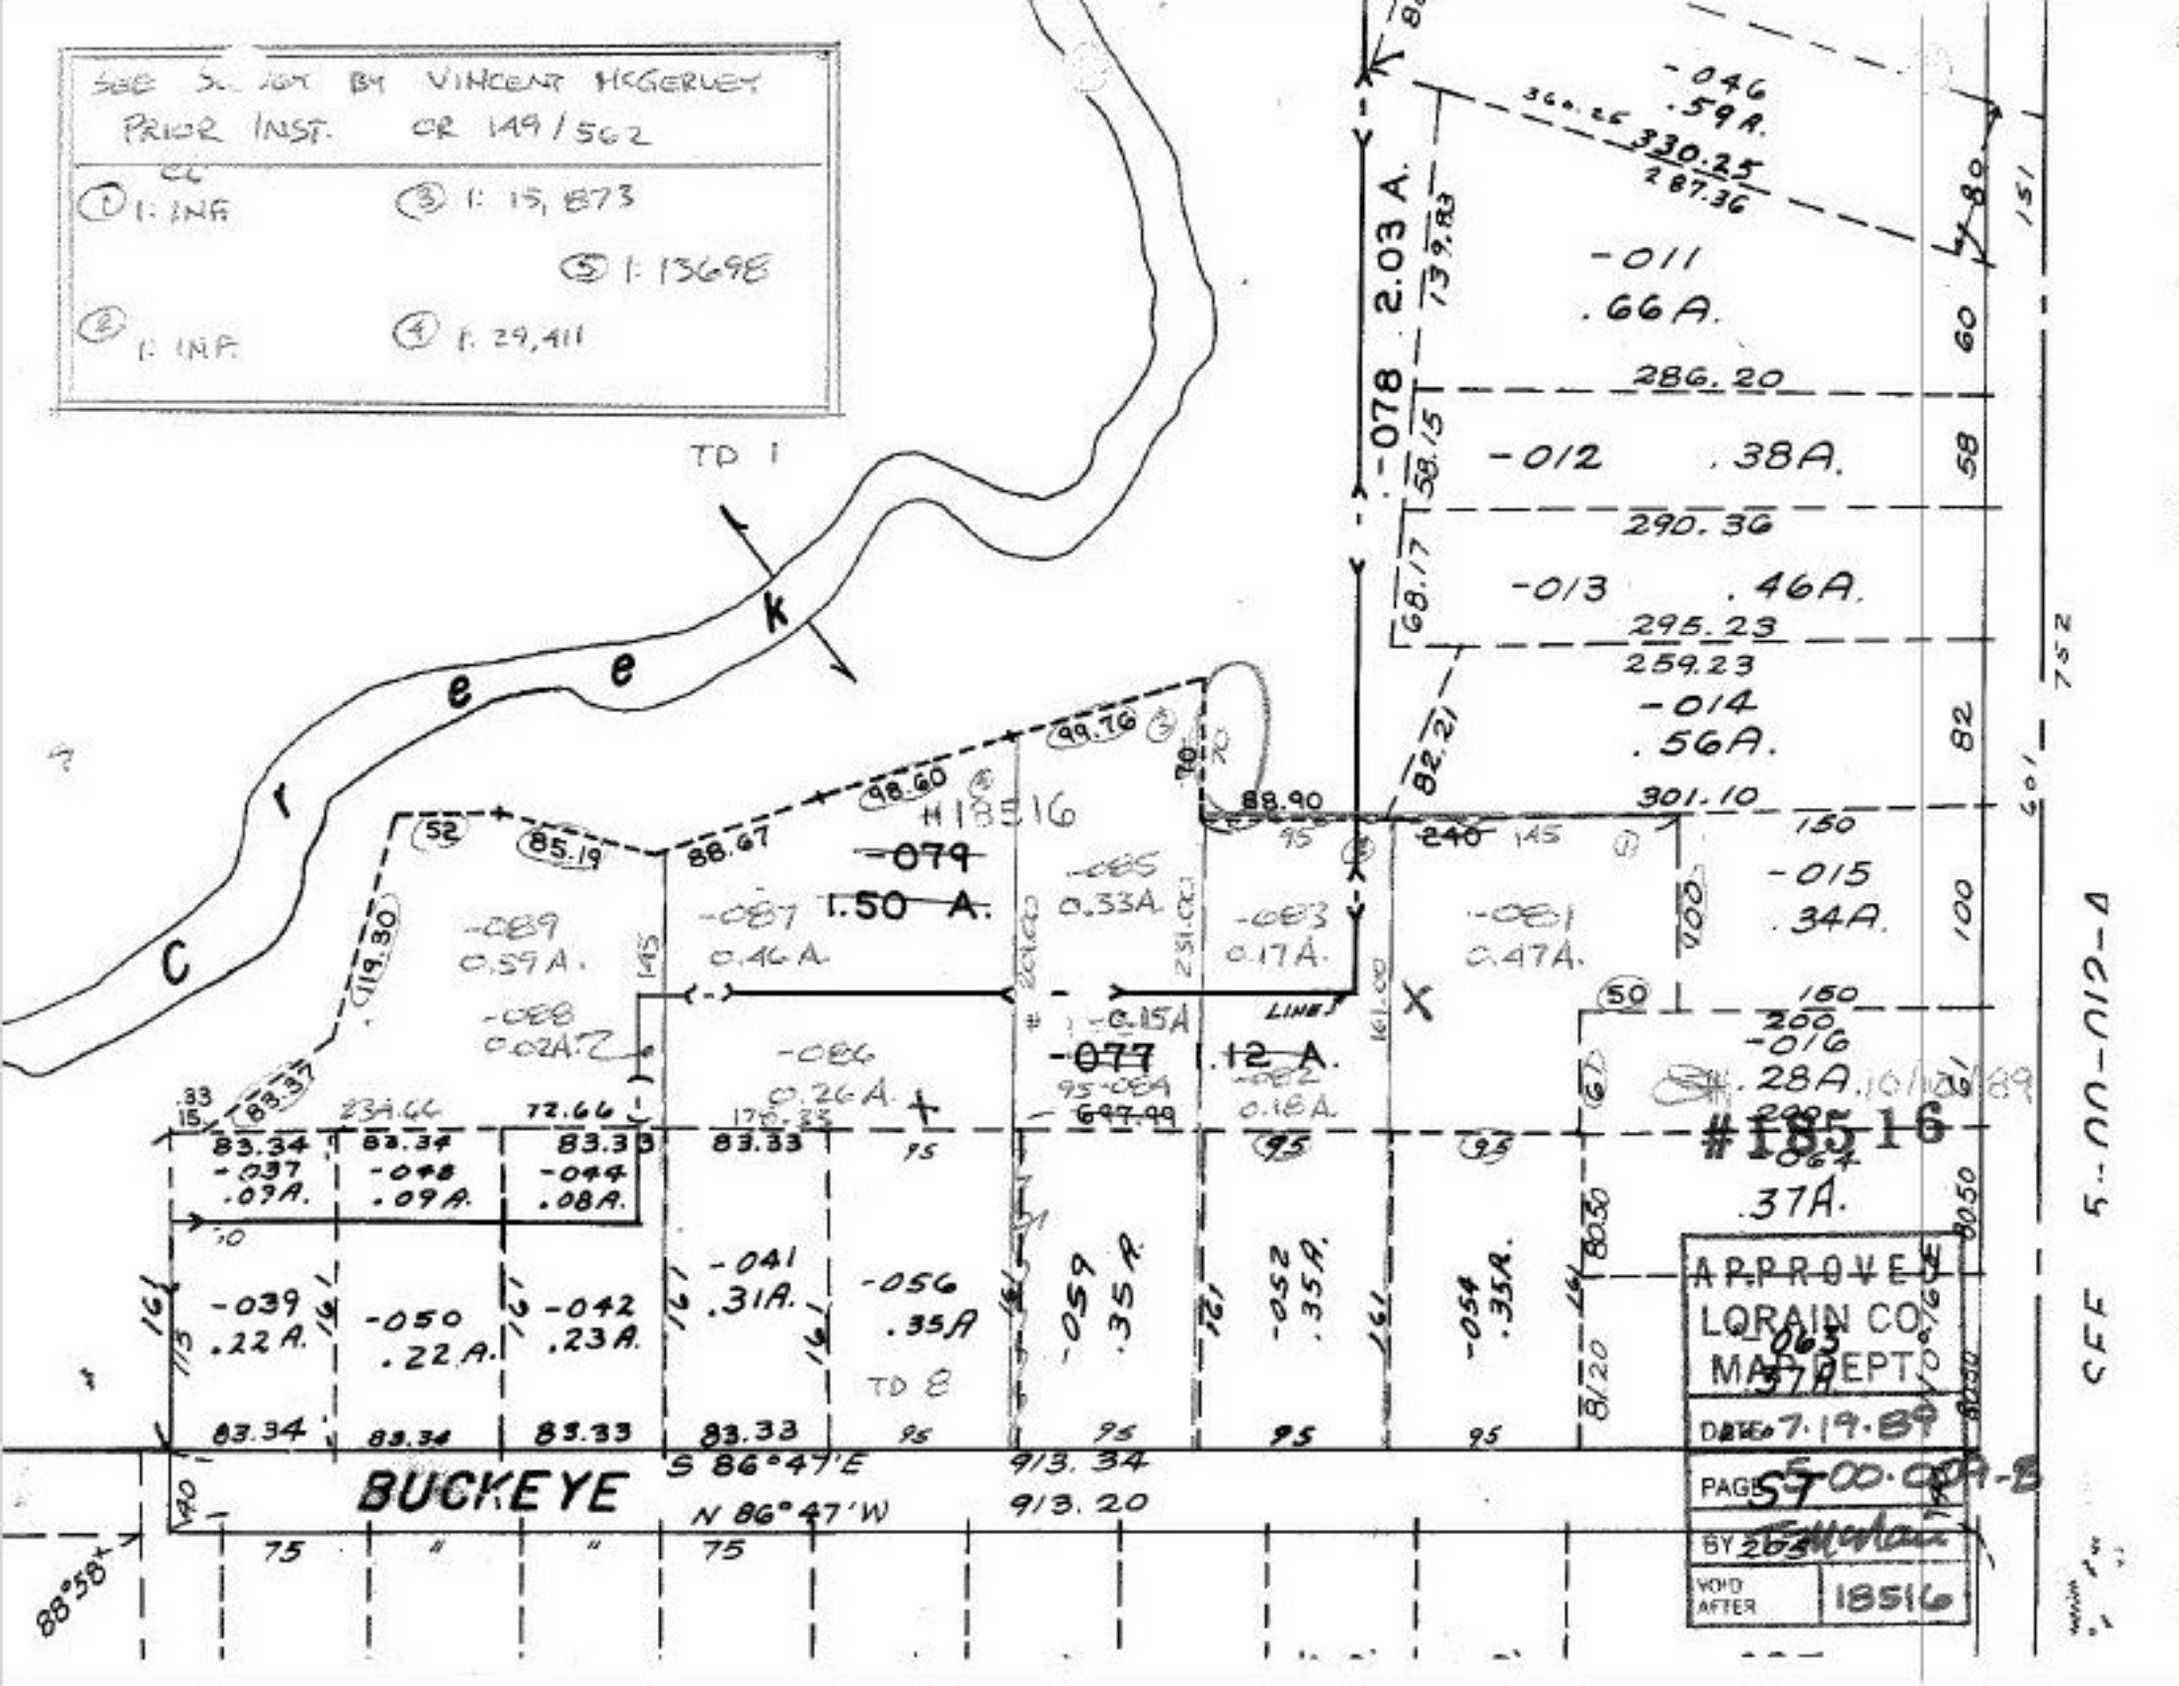
SEE SURVEY BY VINCENT HEGERLEY
PRIOR INST. OR 149/562
① I: INA
② I: INA
③ I: 15,873
④ I: 29,411
⑤ I: 13698
TD 1
Creek
-078 2.03 A.
-011 .66A.
286.20
-012 .38A.
290.36
-013 .46A.
295.23
259.23
-014 .56A.
301.10
-015 .34A.
-016 .28A.
#18516
-079 1.50 A.
-085 0.33A.
-089 0.59A.
-087 0.46A.
-088 0.02A.±
-086 0.26A.±
-083 0.17A.
-081 0.47A.
-077 1.12 A.
-082 0.18A.
-084 0.15A.
-064 .37A.
-039 .22A.
-050 .22A.
-042 .23A.
-041 .31A.
-056 .35A
-059 .35A.
-052 .35A.
-054 .35A.
TD 8
BUCKEYE
S 86°47'E
N 86°47'W
913.34
913.20
88°58±
APPROVED
LORAIN CO.
MAP DEPT.
DATED 7-19-89
PAGE 57
BY EMcLain
VOID AFTER 18516
SEE 5-00-012-A
5-00-012-B