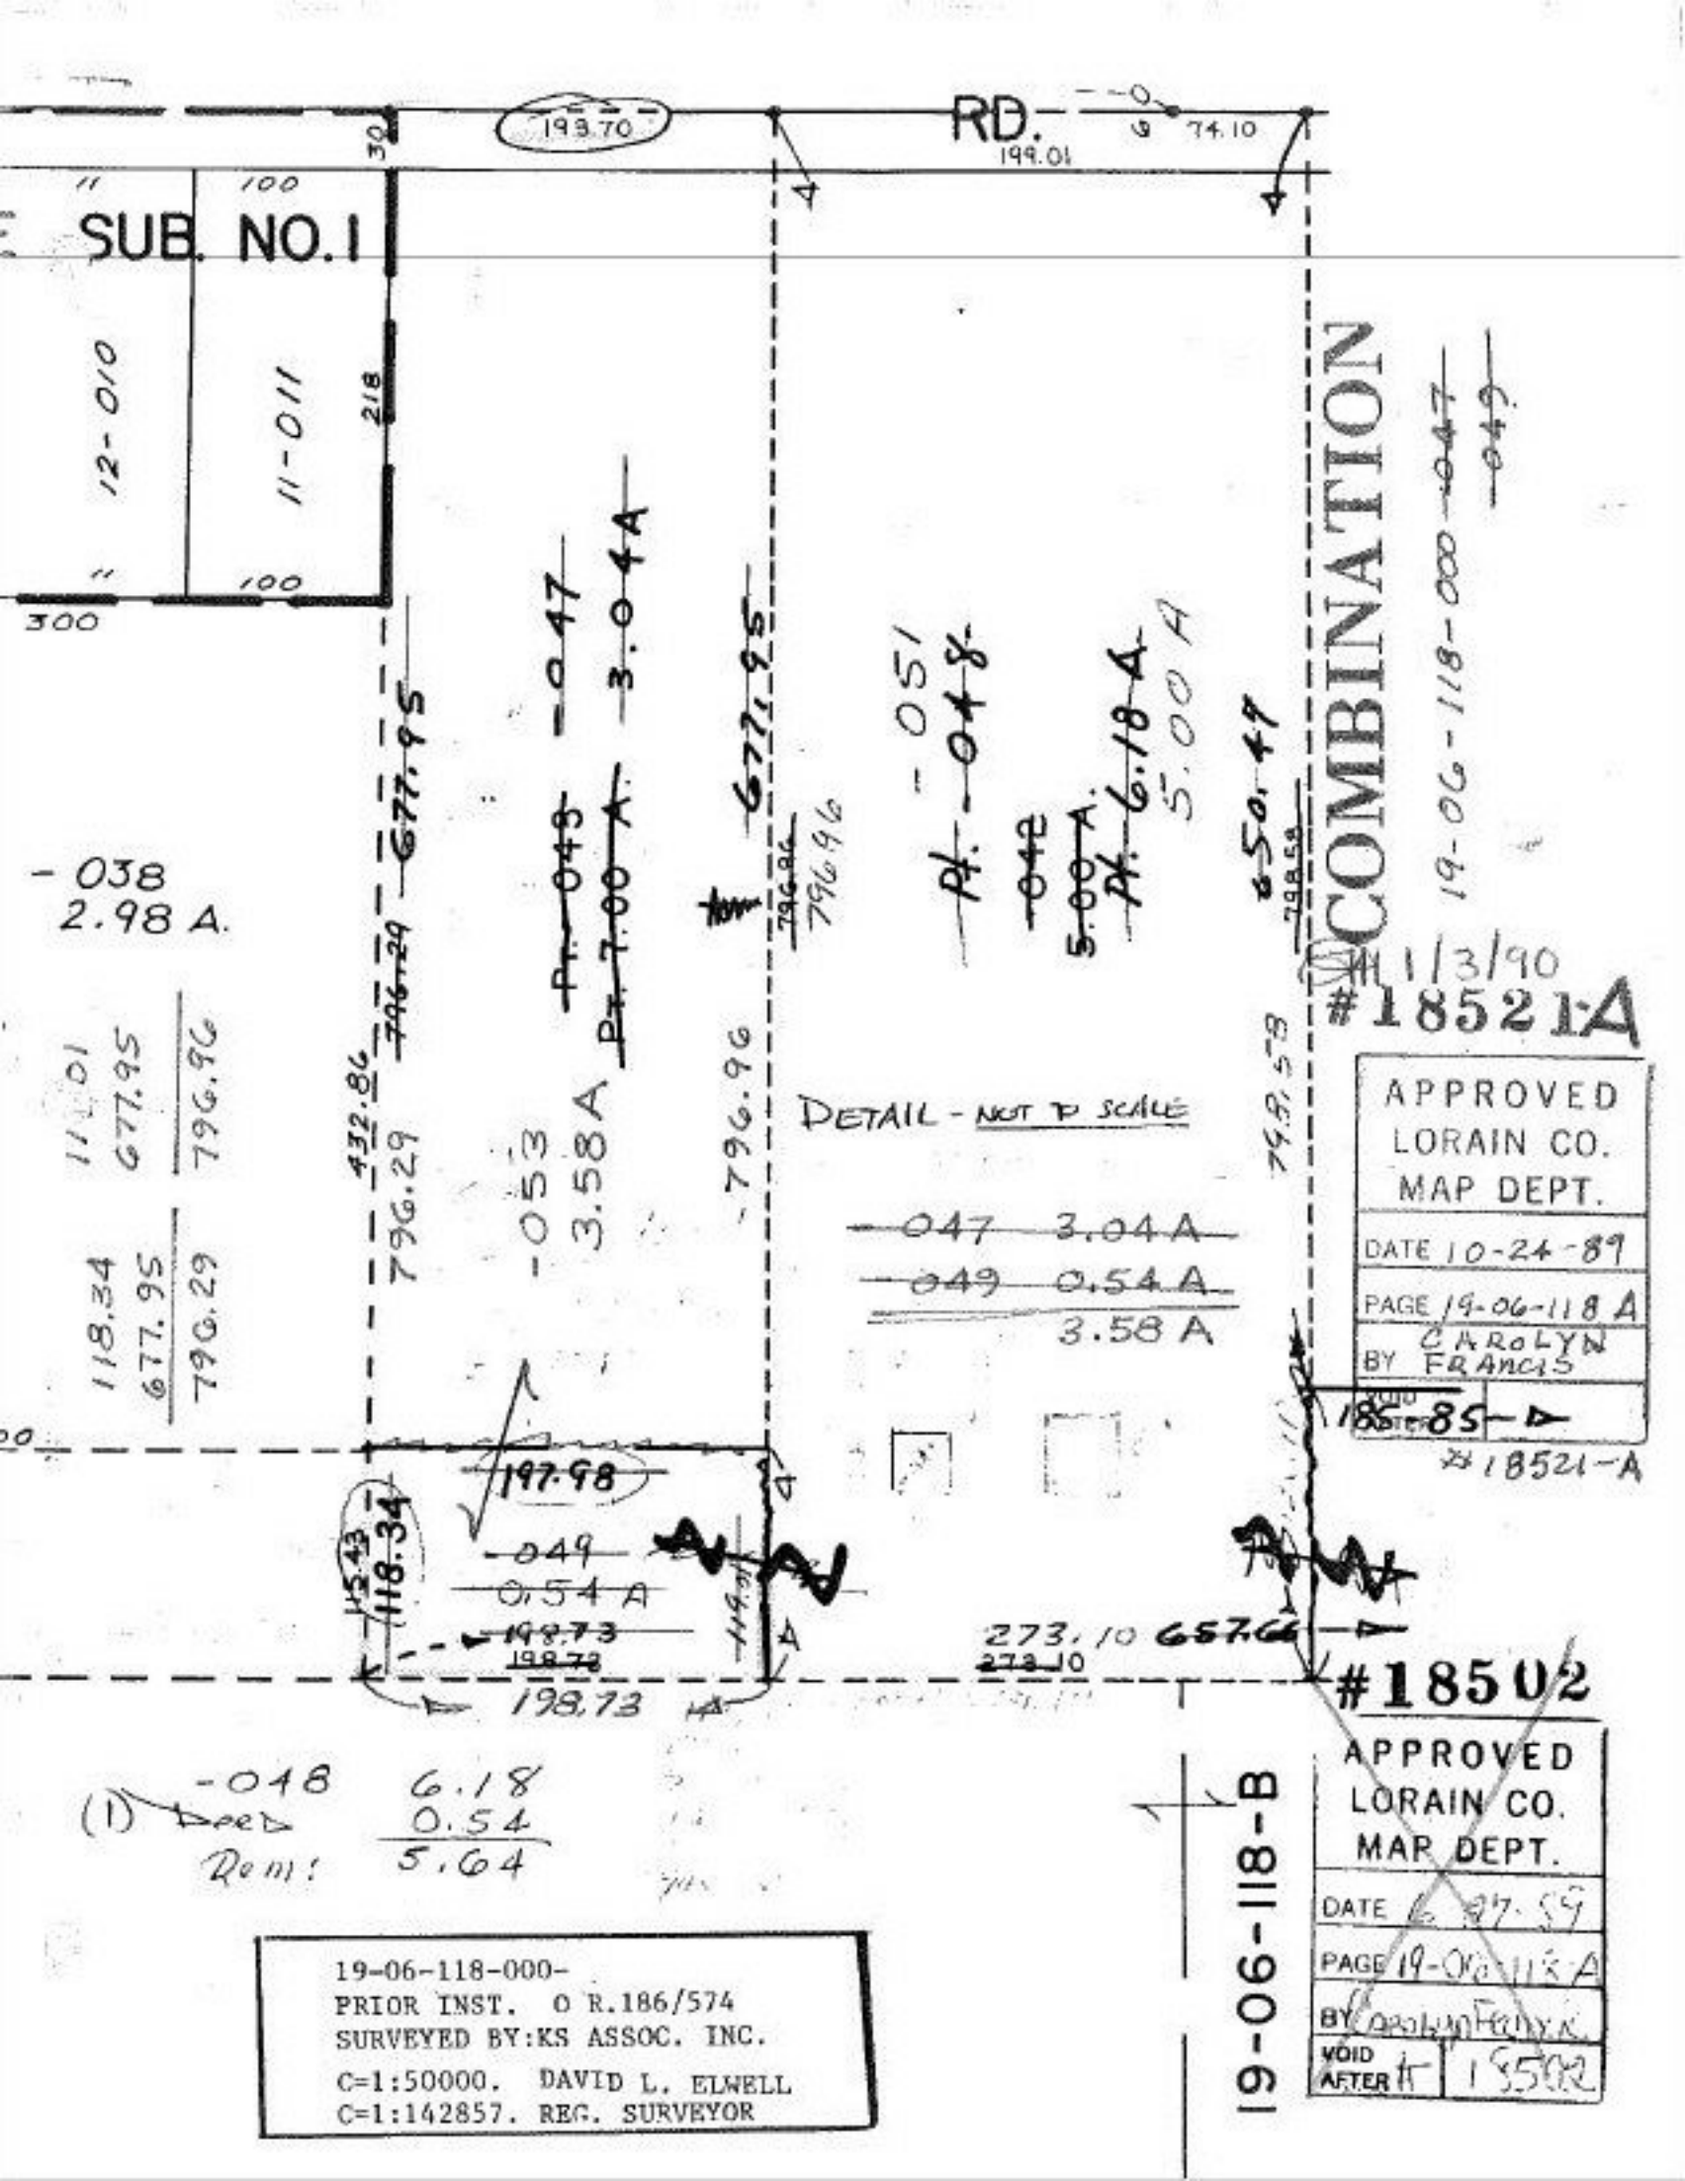
RD.
199.01
199.70
74.10
SUB. NO.1
12-010
11-011
218
100
300
-038
2.98 A.
-047
Pt. 3.00 A.
3.044
677.95
796.96
-051
Pt. -048
042
5.00 A.
Pt. 6.18 A.
5.00 A
650.49
COMBINATION
19-06-118-000
-047
-049
11/3/90
#18521-A
APPROVED
LORAIN CO.
MAP DEPT.
DATE 10-24-89
PAGE 19-06-118 A
BY CAROLYN FRANCIS
#18521-A
DETAIL - NOT TO SCALE
-047 3.04A
-049 0.54A
3.58 A
-053
3.58A
432.86
796.29
118.34
677.95
790.29
197.98
198.73
273.10
657.66
#18502
APPROVED
LORAIN CO.
MAP DEPT.
DATE 6-27-89
PAGE 19-06-118 A
BY CAROLYN FRANCIS
VOID AFTER 11
18502
19-06-118-B
-018 6.18
Dec 0.54
Rem! 5.64
19-06-118-000-
PRIOR INST. O R.186/574
SURVEYED BY:KS ASSOC. INC.
C=1:50000. DAVID L. ELWELL
C=1:142857. REG. SURVEYOR