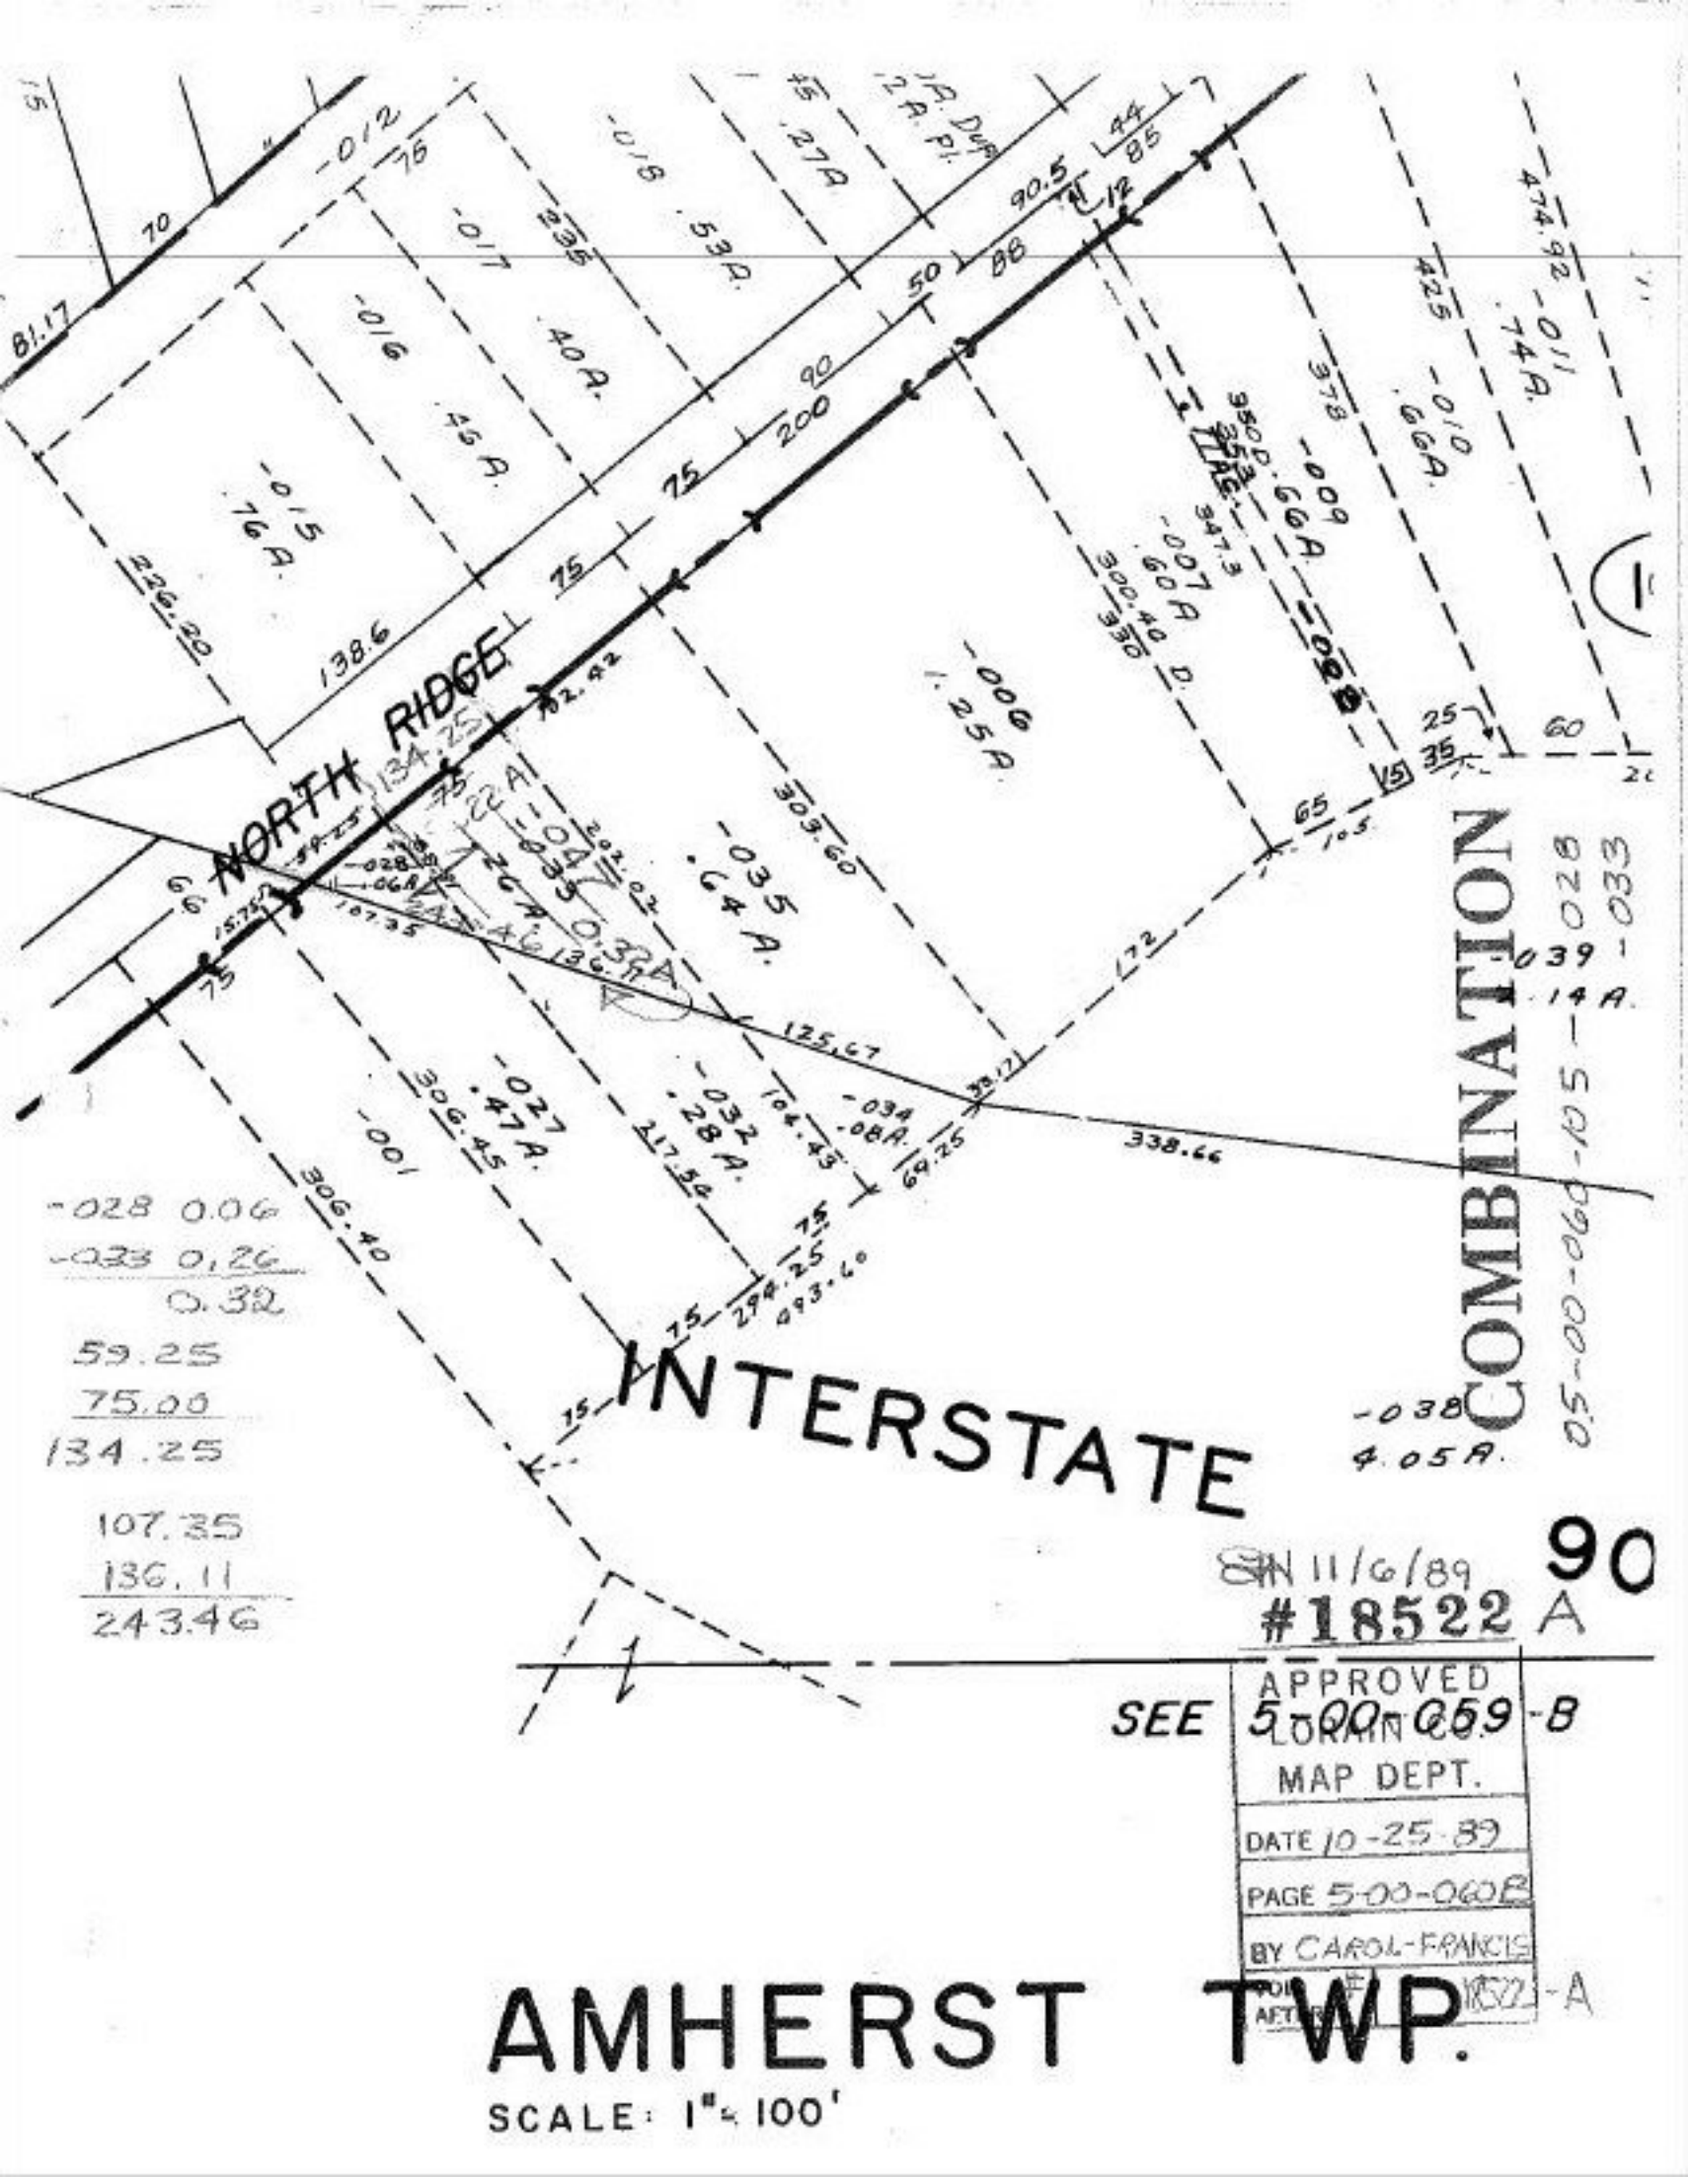
NORTH RIDGE
INTERSTATE
COMBINATION
-012
-011
-010
-009
-008
-007
-006
-035
-034
-033
-032
-028
-027
-001
-038
-039
-014
-015
-016
-017
-018
-022
-023
-026
-028 0.06
-033 0.26
0.32
59.25
75.00
134.25
107.35
136.11
243.46
SEE 5-00-059-B
APPROVED
LORAIN CO.
MAP DEPT.
DATE 10-25-89
PAGE 5-00-060B
BY CAROL-FRANCIS
AFTER #18522-A
SN 11/6/89
#18522 A
90
AMHERST TWP.
SCALE: 1" = 100'