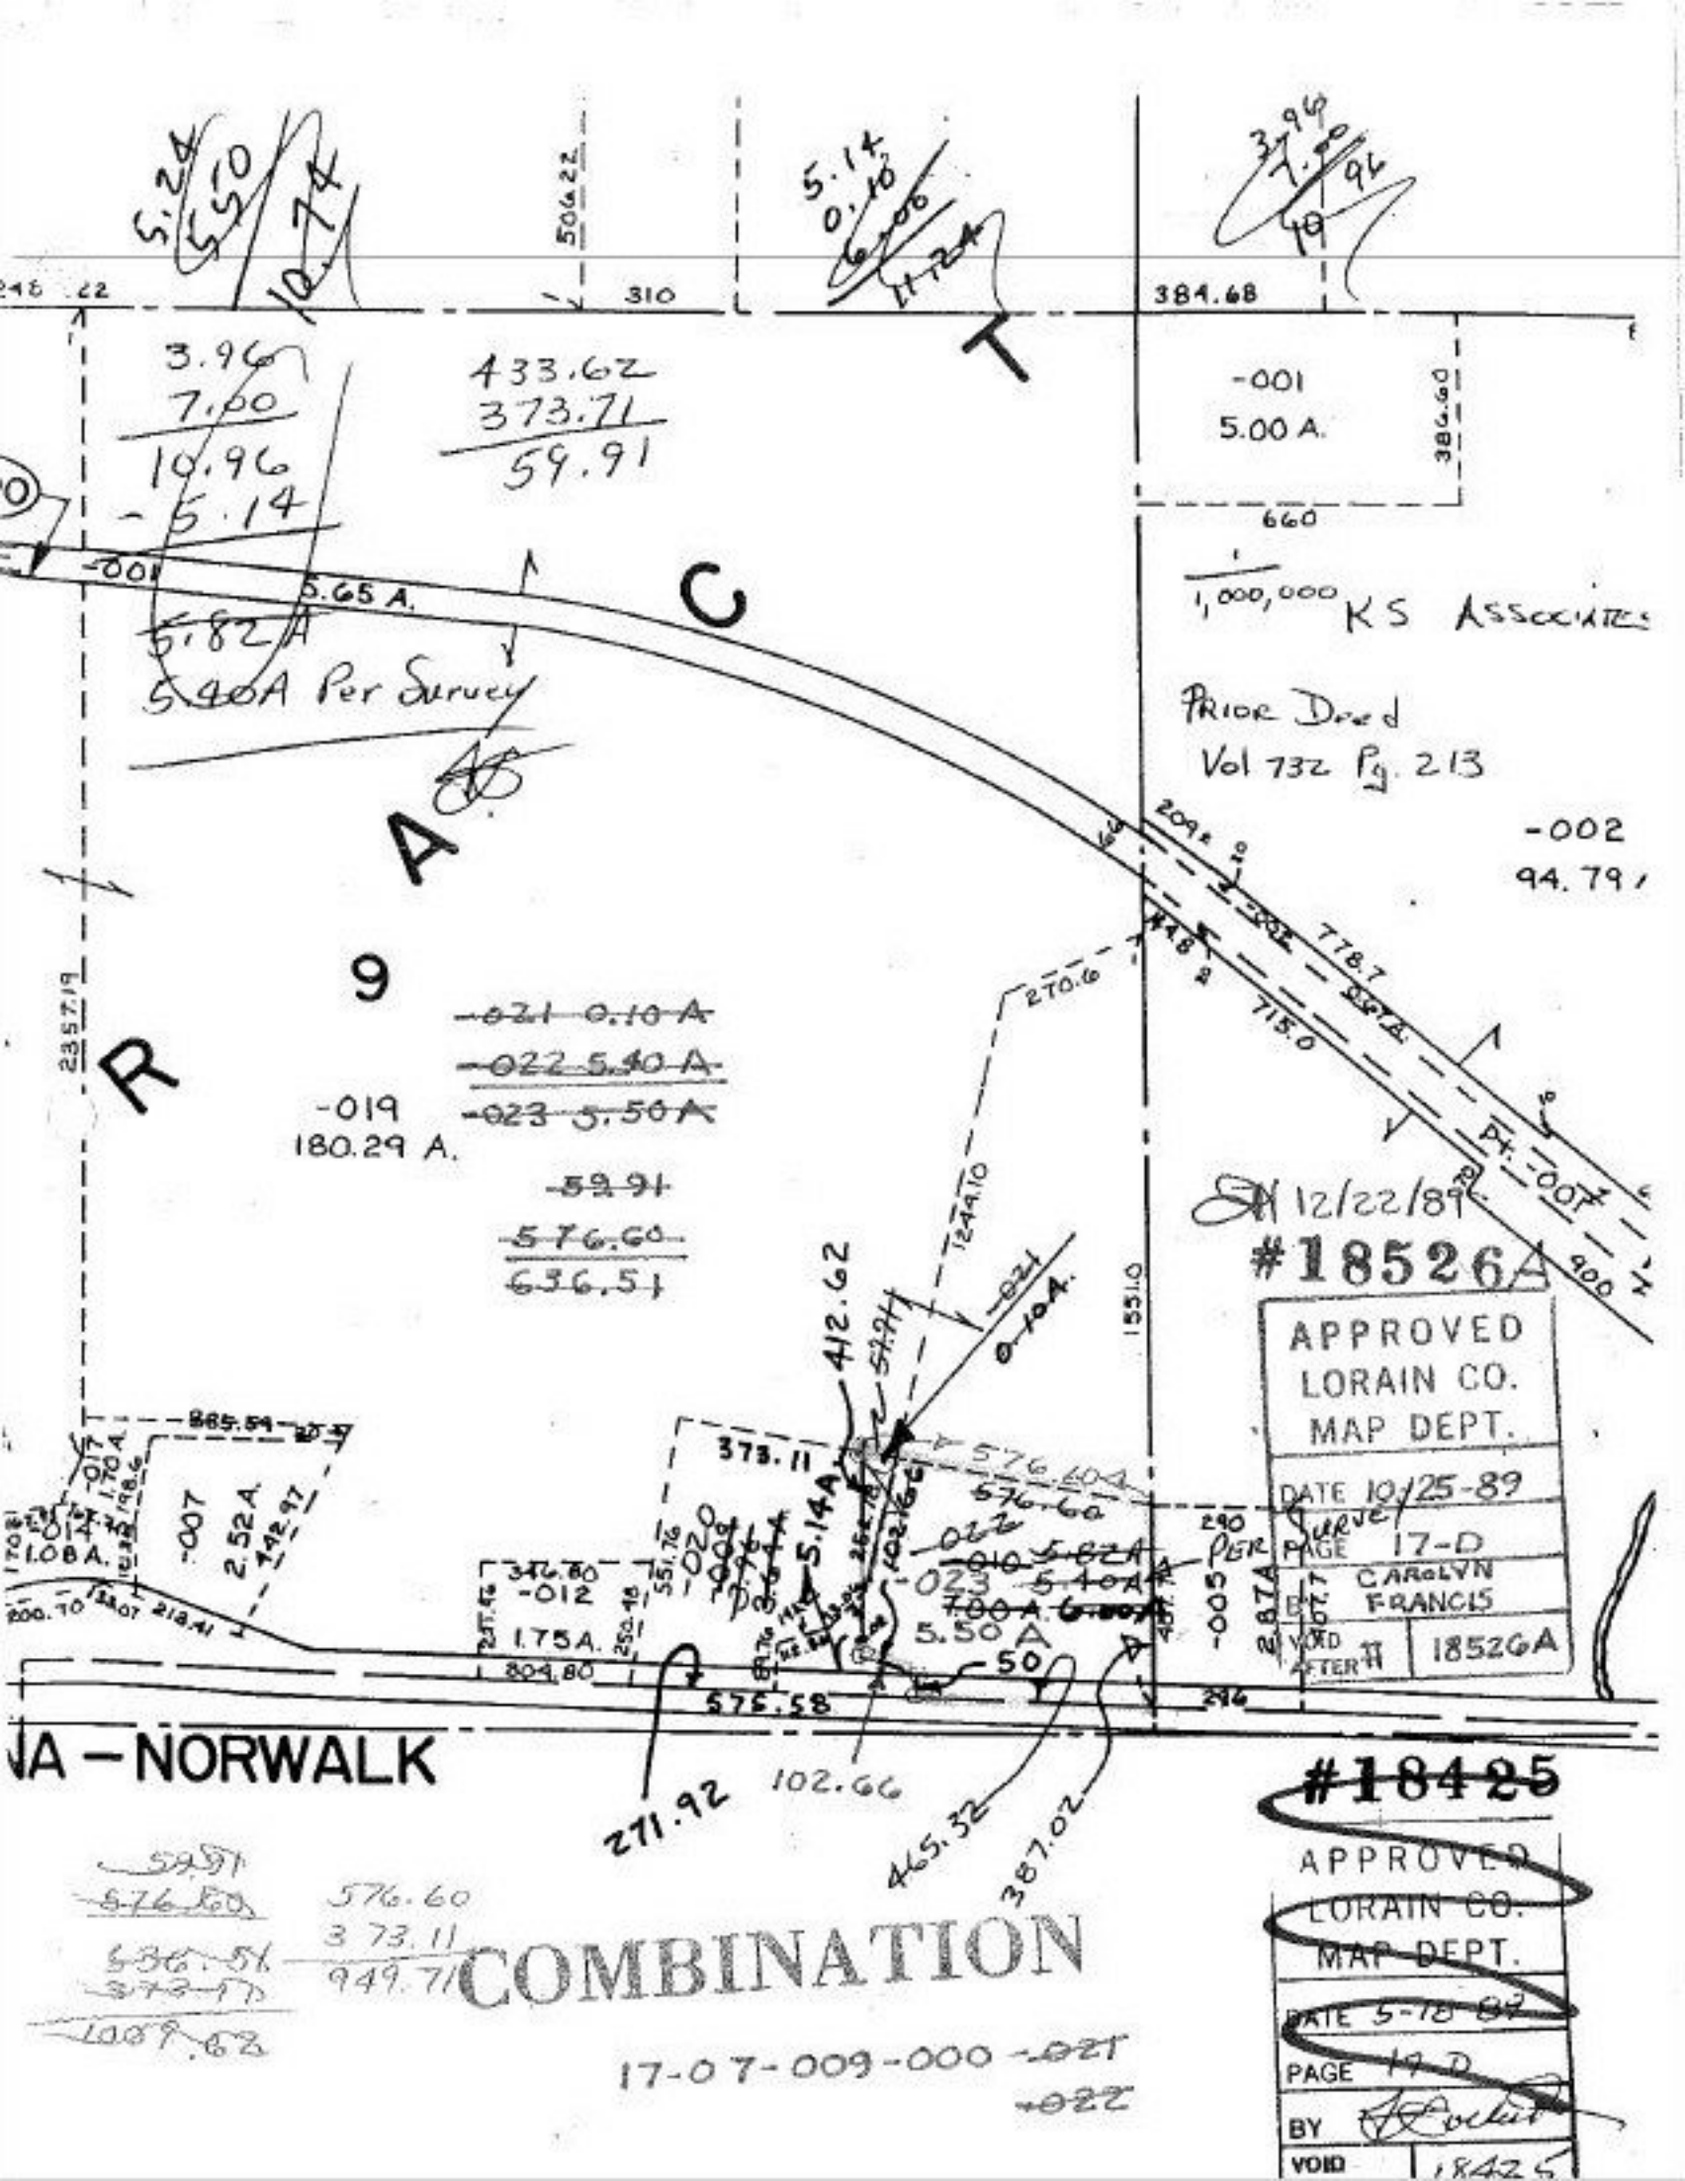

5.24
5.50
10.74
506.22
5.14
0.10
6.06
11.24
3.96
7.00
10.96
384.68
310
3.96
7.00
10.96
-5.14
433.62
373.71
59.91
-001
5.00 A.
386.60
660
-001
5.65 A.
5.82 A
5.40A Per Survey
1/1,000,000 KS ASSOCIATES
PRIOR Deed
Vol 732 Pg. 213
-002
94.79
R A C T
9
2357.19
-021 0.10 A
-022 5.40 A
-023 5.50 A
-019
180.29 A.
59.91
576.60
636.51
270.6
778.7
715.0
1244.10
1551.0
12/22/89
#18526A
APPROVED
LORAIN CO.
MAP DEPT.
DATE 10/25-89
PAGE 17-D
BY CAROLYN FRANCIS
VOID AFTER # 18526A
412.62
-021
0.10A.
373.11
576.60
576.60
5.14A
-022
-010 5.82A
-023 5.40A
7.00A 6.00A
5.50 A
-50
-005
2.87A
290
PER SURVEY
-007
2.52 A.
-014
1.08 A.
346.80
-012
1.75A.
804.80
575.58
296
NA – NORWALK
271.92
102.66
465.32
387.02
#18425
APPROVED
LORAIN CO.
MAP DEPT.
DATE 5-18-89
PAGE 17-D
BY
VOID 18425
59.91
576.60
636.51
373.11
1009.62
576.60
373.11
949.71
COMBINATION
17-07-009-000 -021
-022