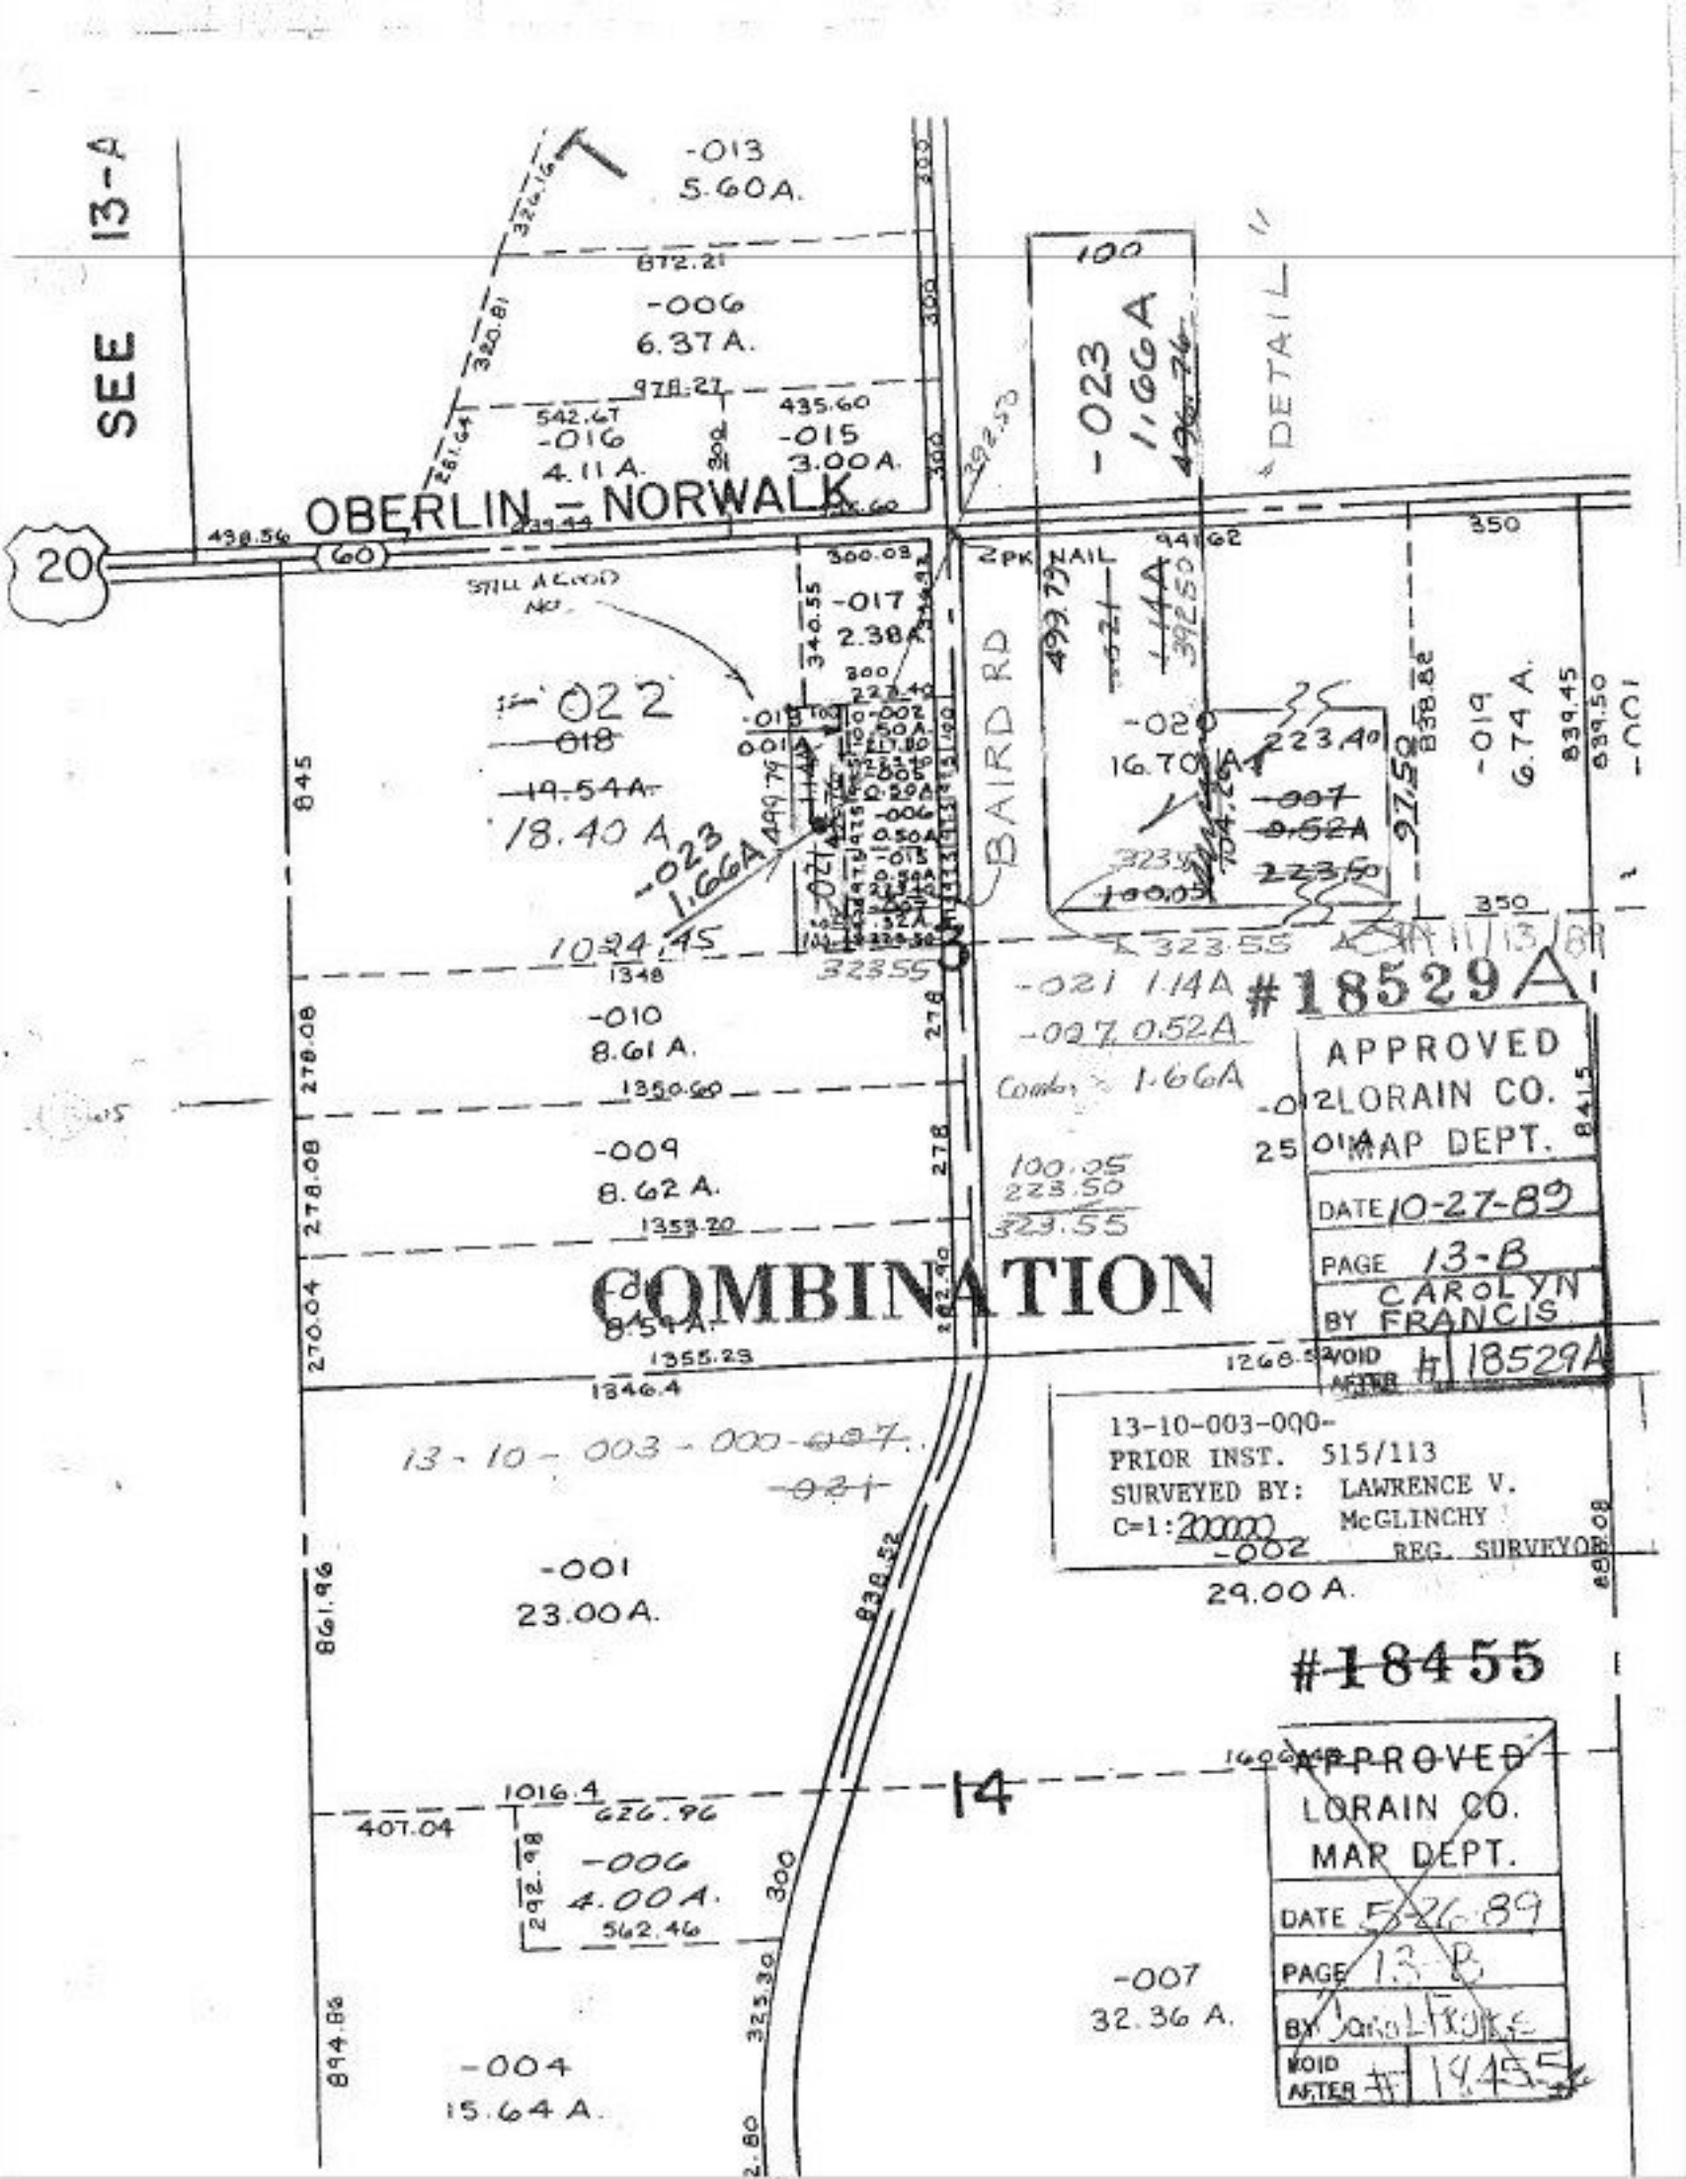
SEE 13-A
OBERLIN - NORWALK
20
60
-013
5.60A.
-006
6.37A.
-016
4.11A.
-015
3.00A.
-023
1.66A
DETAIL
-017
2.38A
-022
18.40 A
-023
1.66A
BAIRD RD
-020
16.70A
-019
6.74 A.
-010
8.61 A.
-009
8.62 A.
-021 1.14A
-007 0.52A
Combo 1.66A
100.05
223.50
323.55
#18529A
APPROVED
LORAIN CO.
MAP DEPT.
DATE 10-27-89
PAGE 13-B
BY CAROLYN FRANCIS
VOID AFTER # 18529A
COMBINATION
13-10-003-000-
PRIOR INST. 515/113
SURVEYED BY: LAWRENCE V. McGLINCHY
C=1:200000
REG. SURVEYOR
-001
23.00A.
29.00 A.
#18455
APPROVED
LORAIN CO.
MAP DEPT.
DATE 5-26-89
PAGE 13-B
BY Carol Francis
VOID AFTER # 18455
14
-006
4.00A.
-007
32.36 A.
-004
15.64 A.