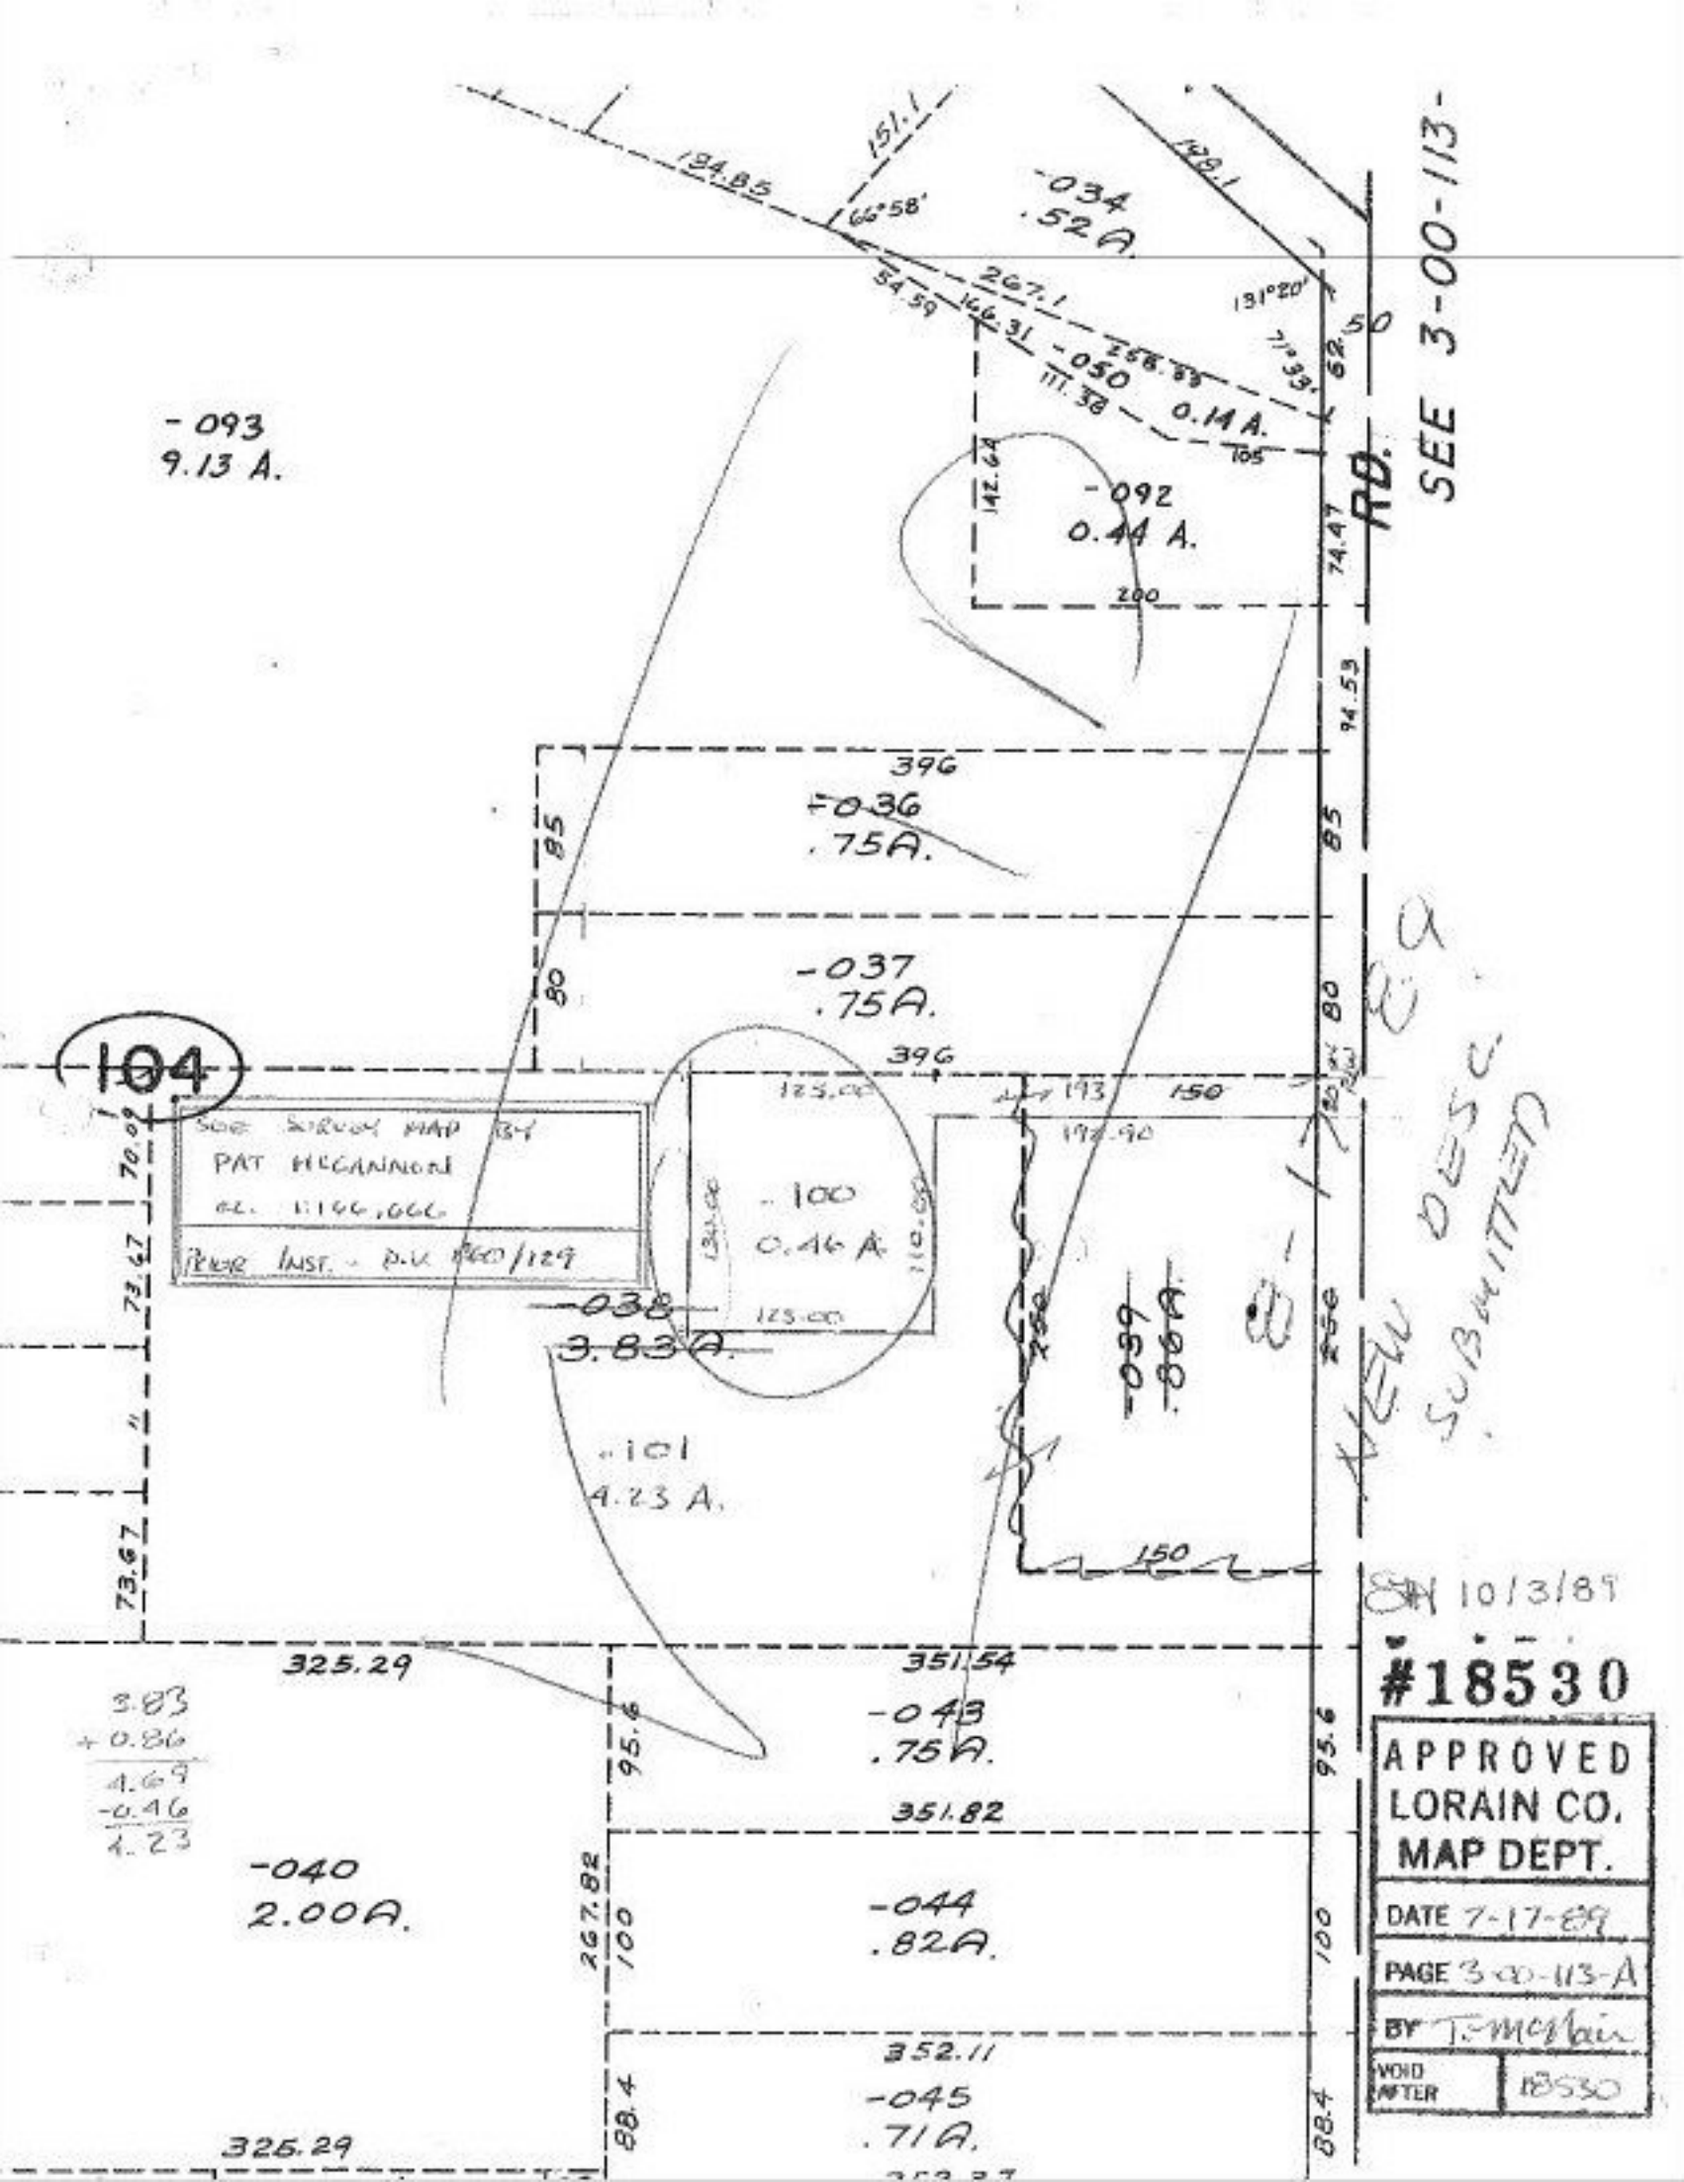
SEE 3-00-113-
RD.
-093
9.13 A.
-034
.52 A.
-050
0.14 A.
-092
0.44 A.
-036
.75A.
-037
.75A.
104
SEE SURVEY MAP 84
PAT HEGANNOND
EL. 1166,666
PRIOR INST. - D.V. 1960/129
-038
3.83A.
.100
0.46 A.
.101
4.23 A.
-039
.004A.
-043
.75A.
-044
.82A.
-045
.71A.
-040
2.00A.
NEW DESC SUBMITTED
10/3/89
#18530
APPROVED
LORAIN CO.
MAP DEPT.
DATE 7-17-89
PAGE 3-00-113-A
BY T. McClain
VOID AFTER 18530