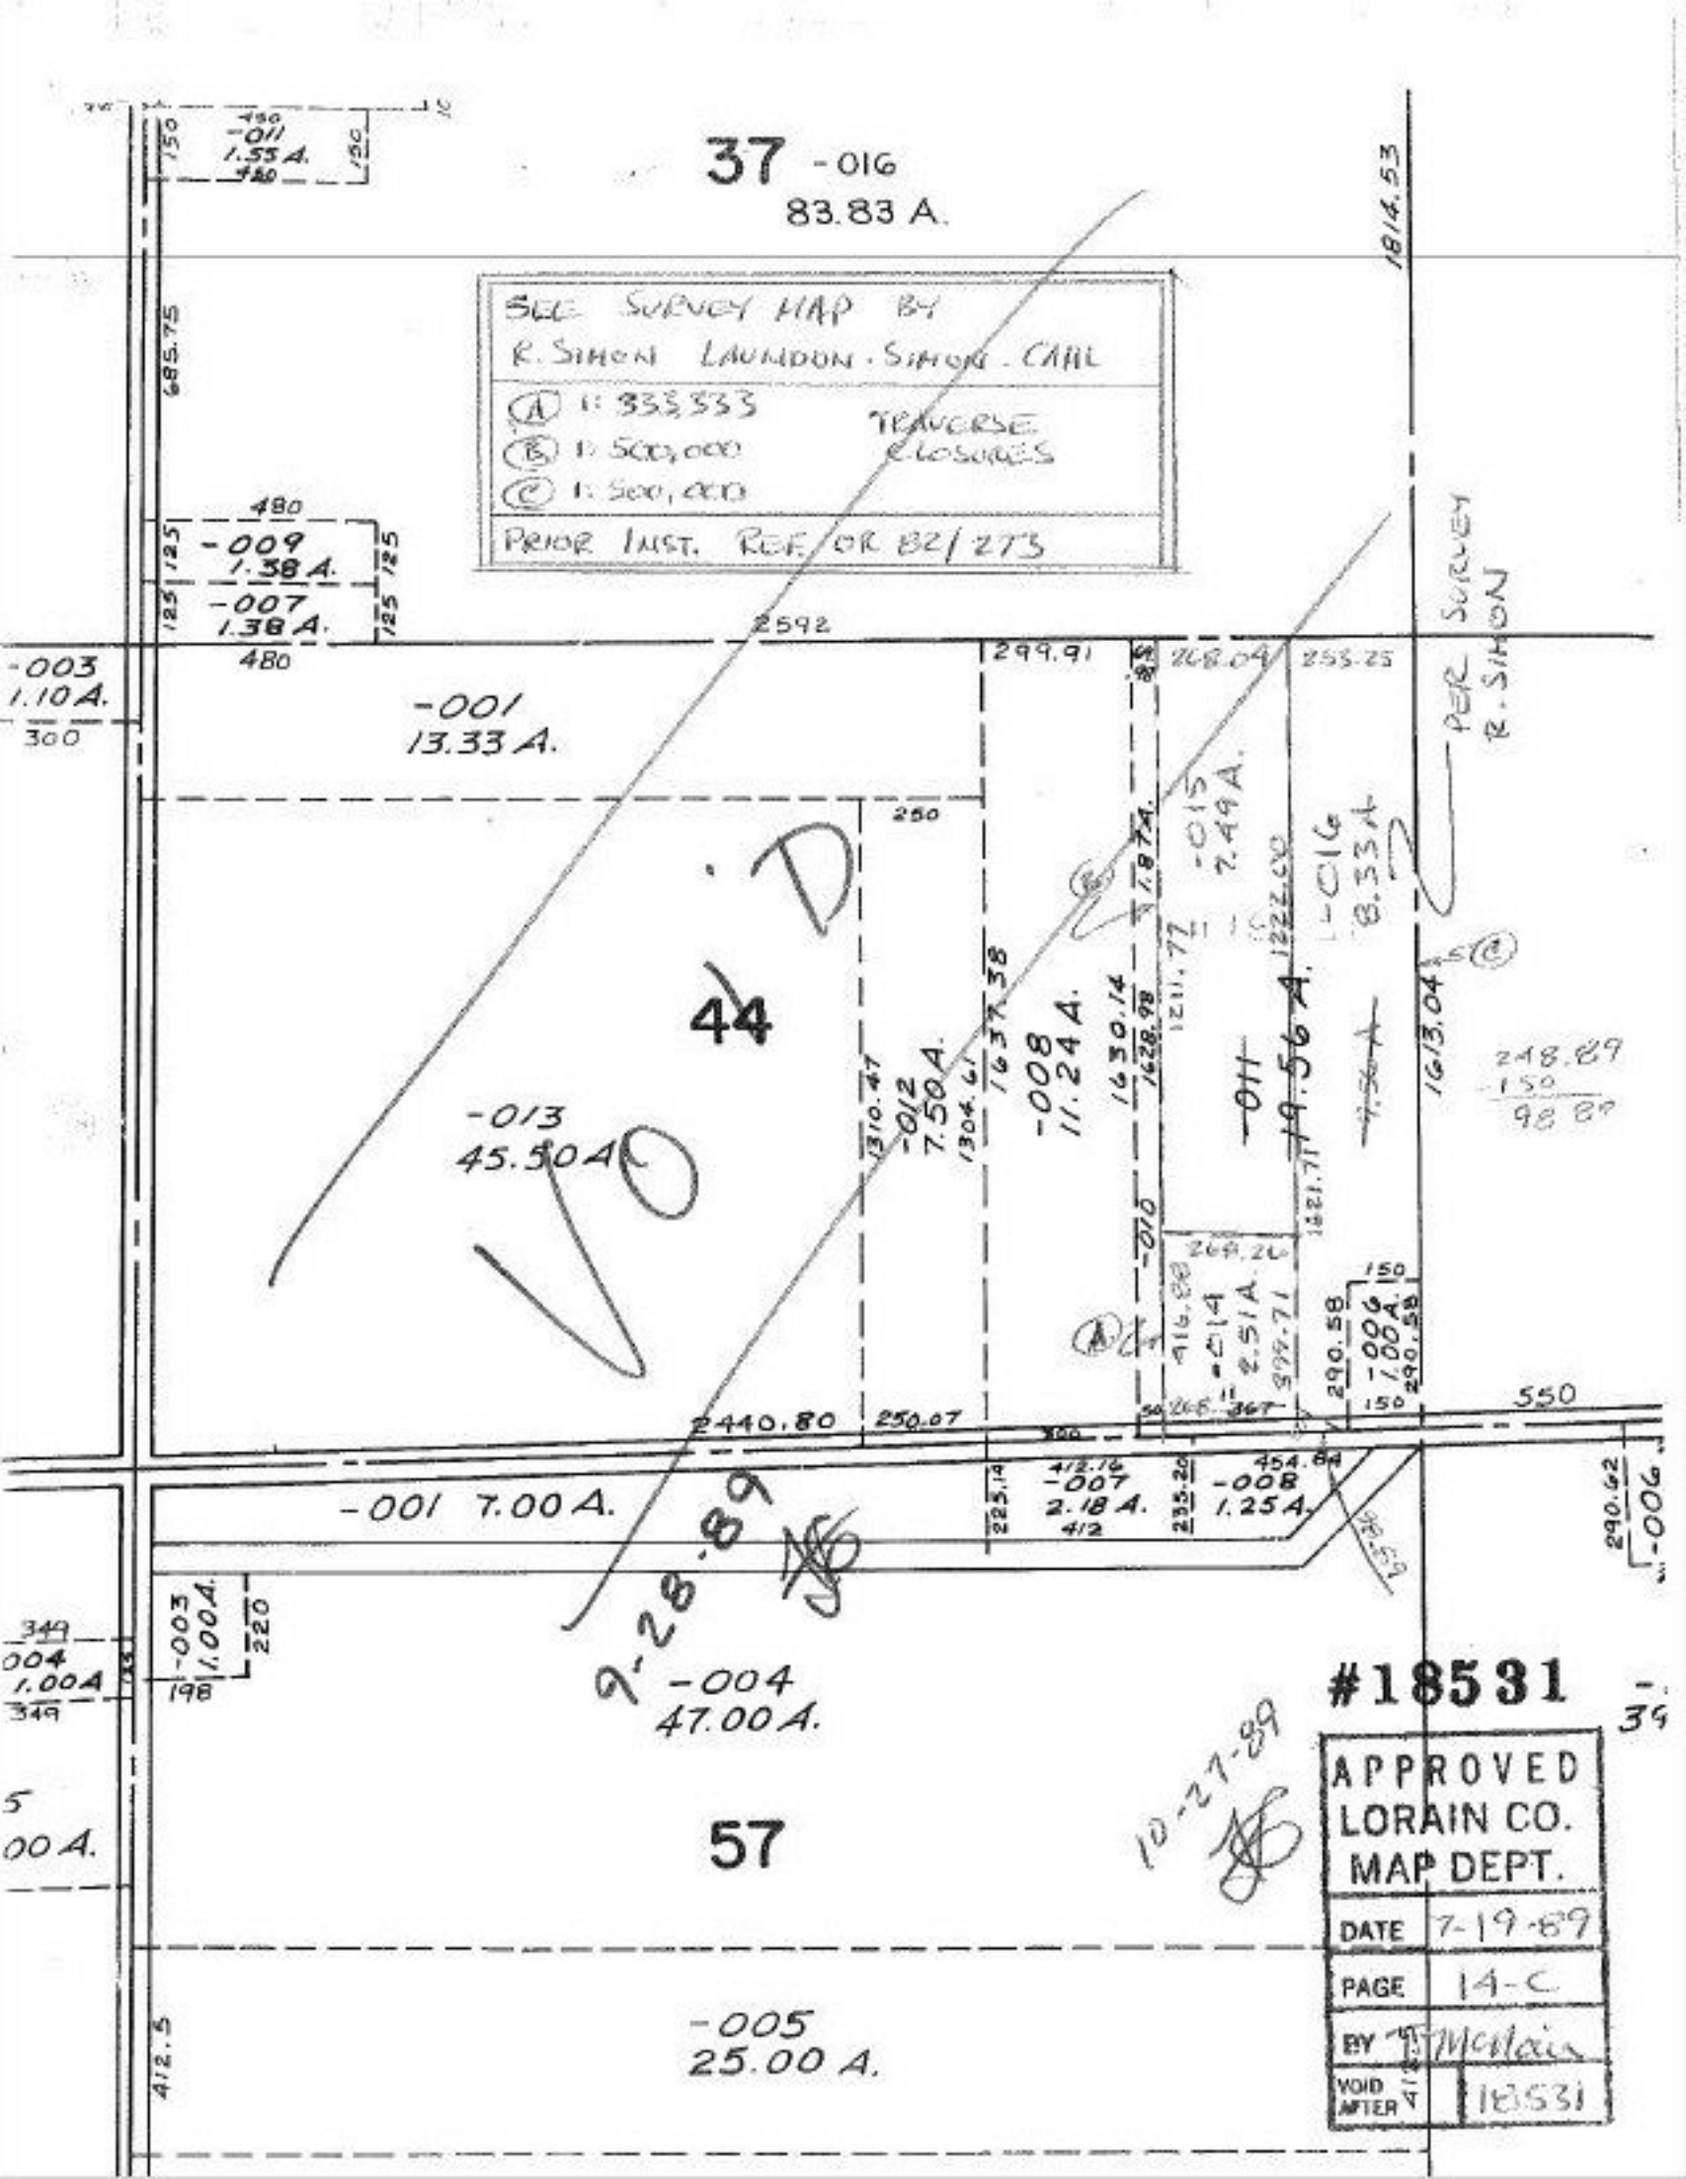
37 -016
83.83 A.
SEE SURVEY MAP BY
R. SIMON LAUNDON - SIMON - CAHL
(A) 1: 333,333
(B) 1: 500,000
(C) 1: 500,000
TRAVERSE CLOSURES
PRIOR INST. REF. OR 82/273
-011 1.55 A.
-009 1.38 A.
-007 1.38 A.
-003 1.10 A.
-001 13.33 A.
44
-013 45.50 A.
-012 7.50 A.
-008 11.24 A.
-011 19.56 A.
-015 7.49 A.
-016 8.33 A.
-014 2.51 A.
-006 1.00 A.
-007 2.18 A.
-008 1.25 A.
-001 7.00 A.
-003 1.00 A.
-004 47.00 A.
57
-005 25.00 A.
VOID
9-28-89
PER SURVEY R. SIMON
1814.53
2592
2440.80
250.07
550
1613.04
248.89
150
98.89
10-27-89
#18531
APPROVED
LORAIN CO.
MAP DEPT.
DATE 7-19-89
PAGE 14-C
BY T. McNair
VOID AFTER 18531