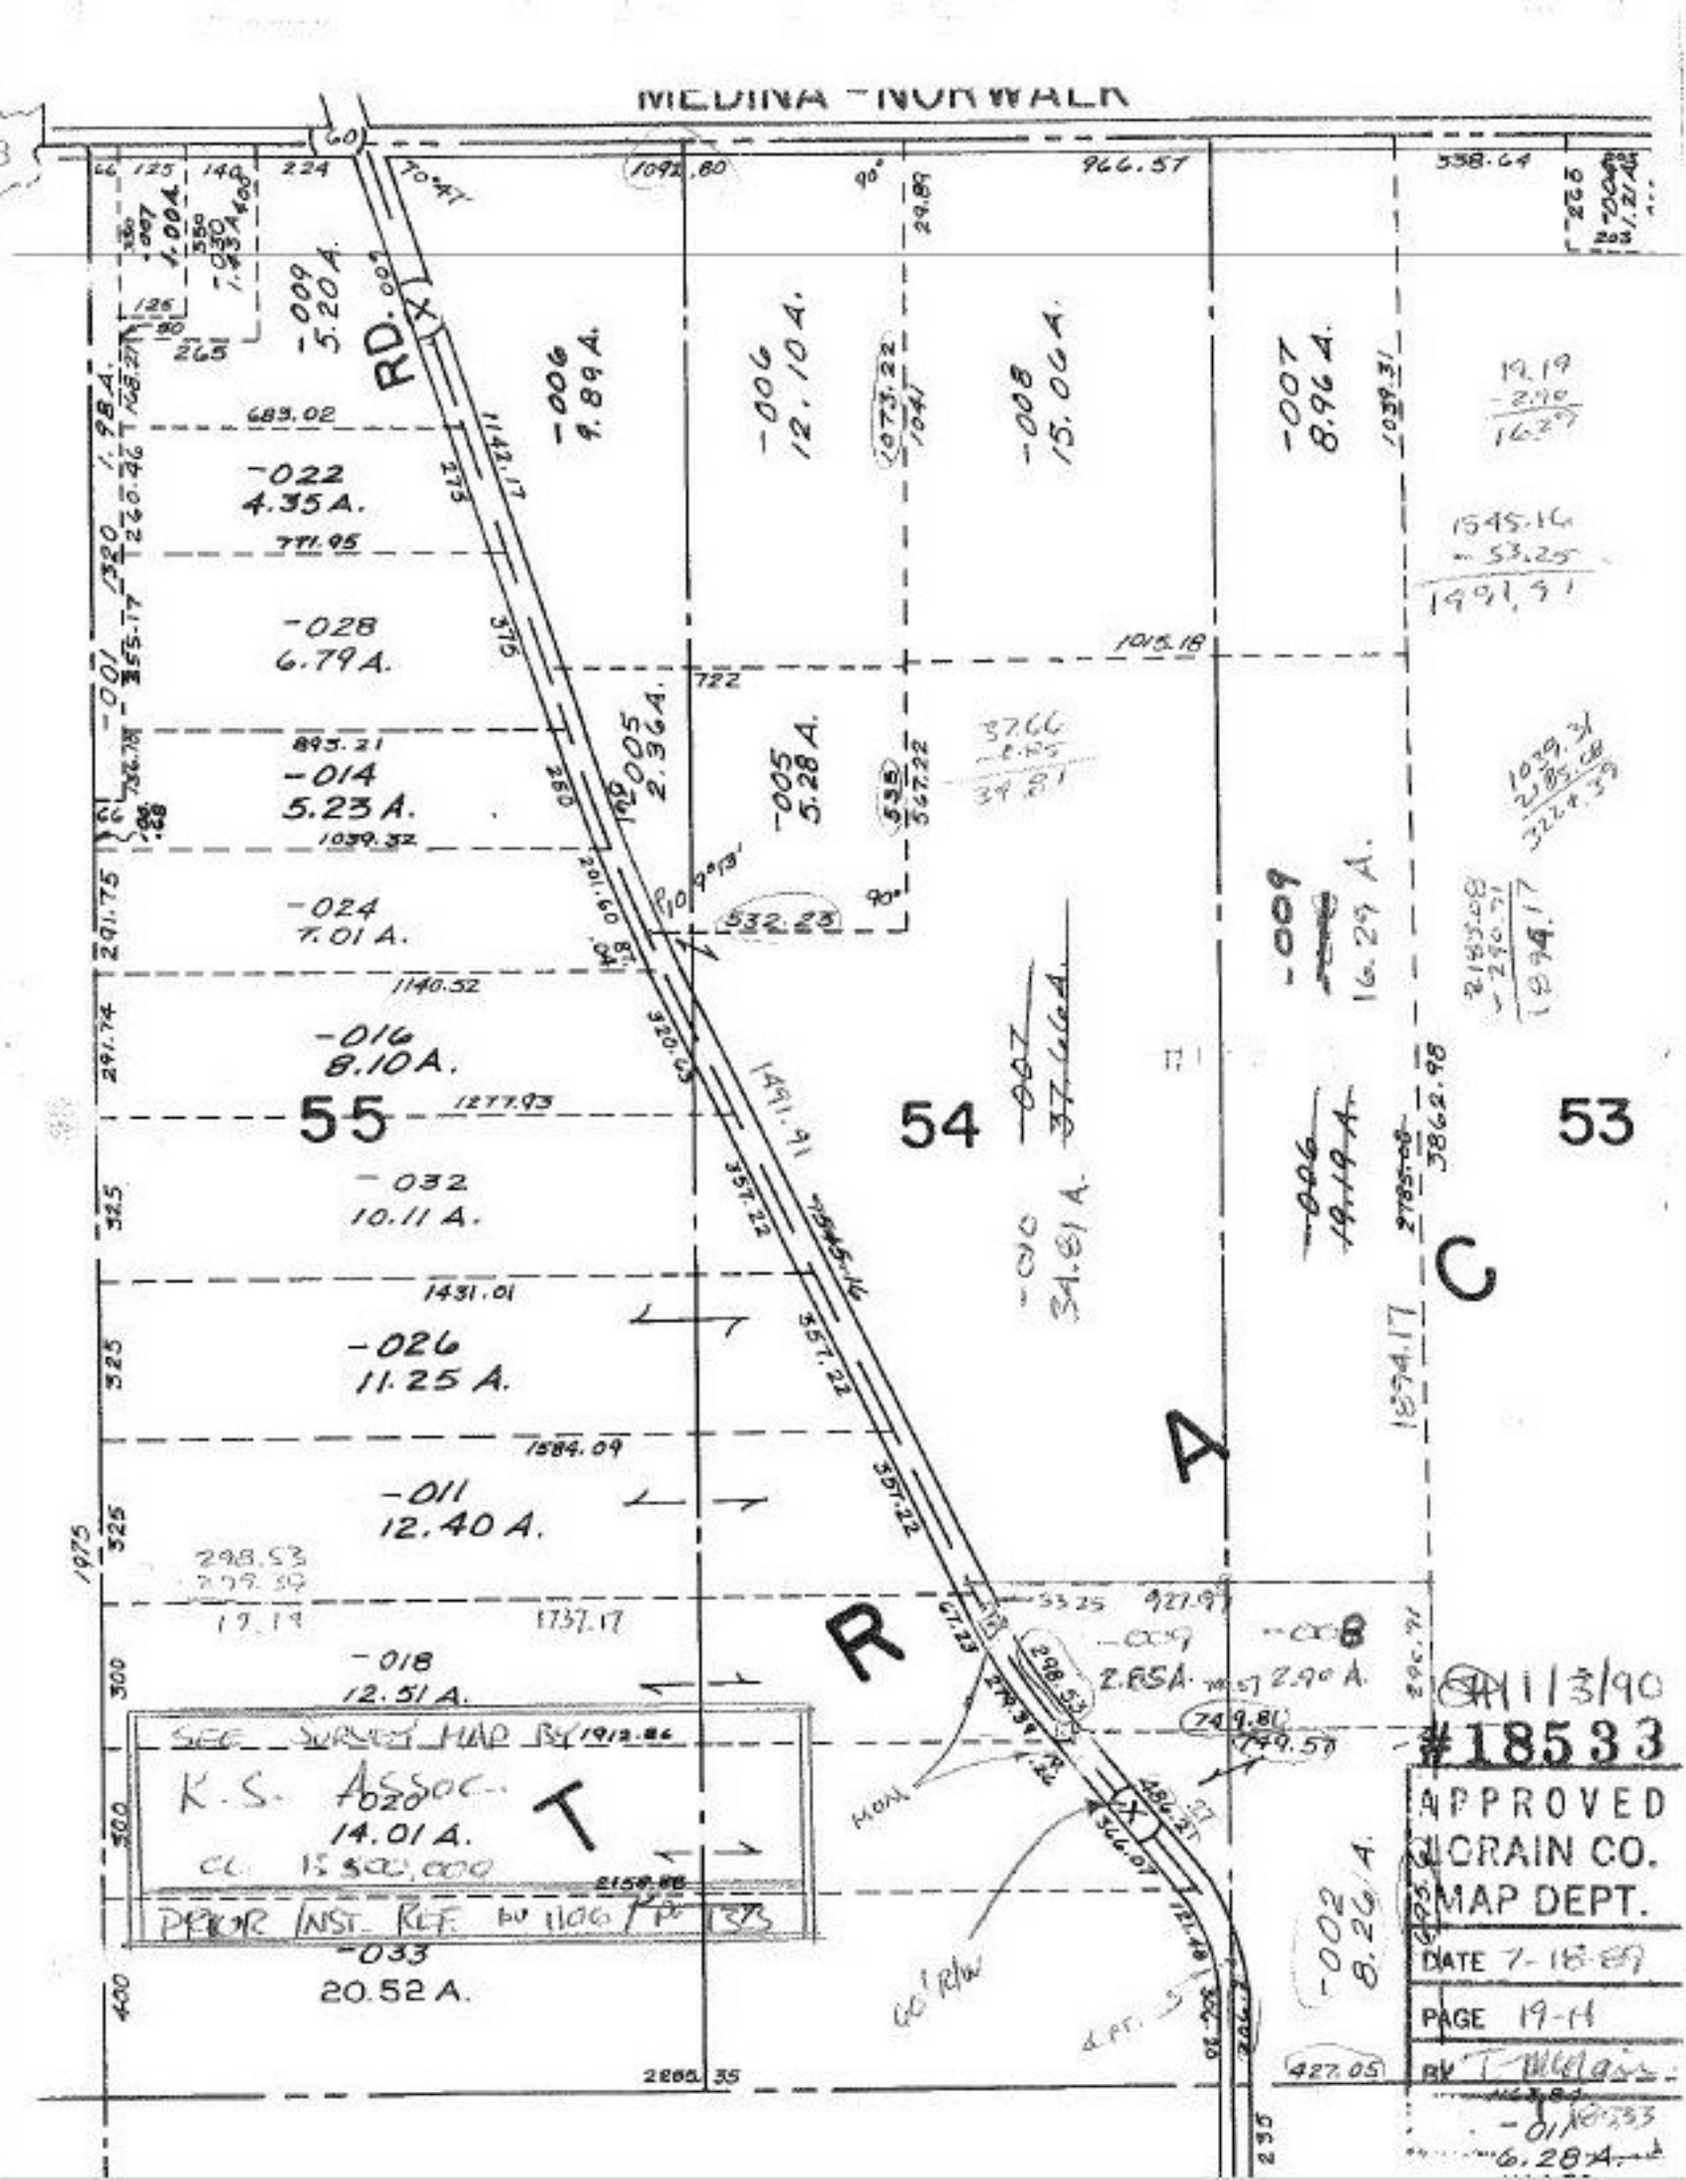
MEDINA - NORWALK
RD.
-009 5.20 A.
-006 9.89 A.
-006 12.10 A.
-008 15.06 A.
-007 8.96 A.
-022 4.35 A.
-028 6.79 A.
-014 5.23 A.
-005 2.36 A.
-005 5.28 A.
-024 7.01 A.
-016 8.10 A.
55
54
53
-032 10.11 A.
-026 11.25 A.
-011 12.40 A.
-018 12.51 A.
-020 14.01 A.
-033 20.52 A.
-007 37.66 A.
-010 34.81 A.
-009 16.29 A.
-006 19.19 A.
-009 2.85 A.
-008 2.90 A.
-002 8.26 A.
-011 6.28 A.
T R A C
SEE SURVEY MAP BY
K.S. ASSOC.
CL 15,500,000
PRIOR INST. REF. BY 1106 / PG 133
MON
60' R/W
#18533
APPROVED
LORAIN CO.
MAP DEPT.
DATE 7-18-89
PAGE 19-H
BY T. McGain