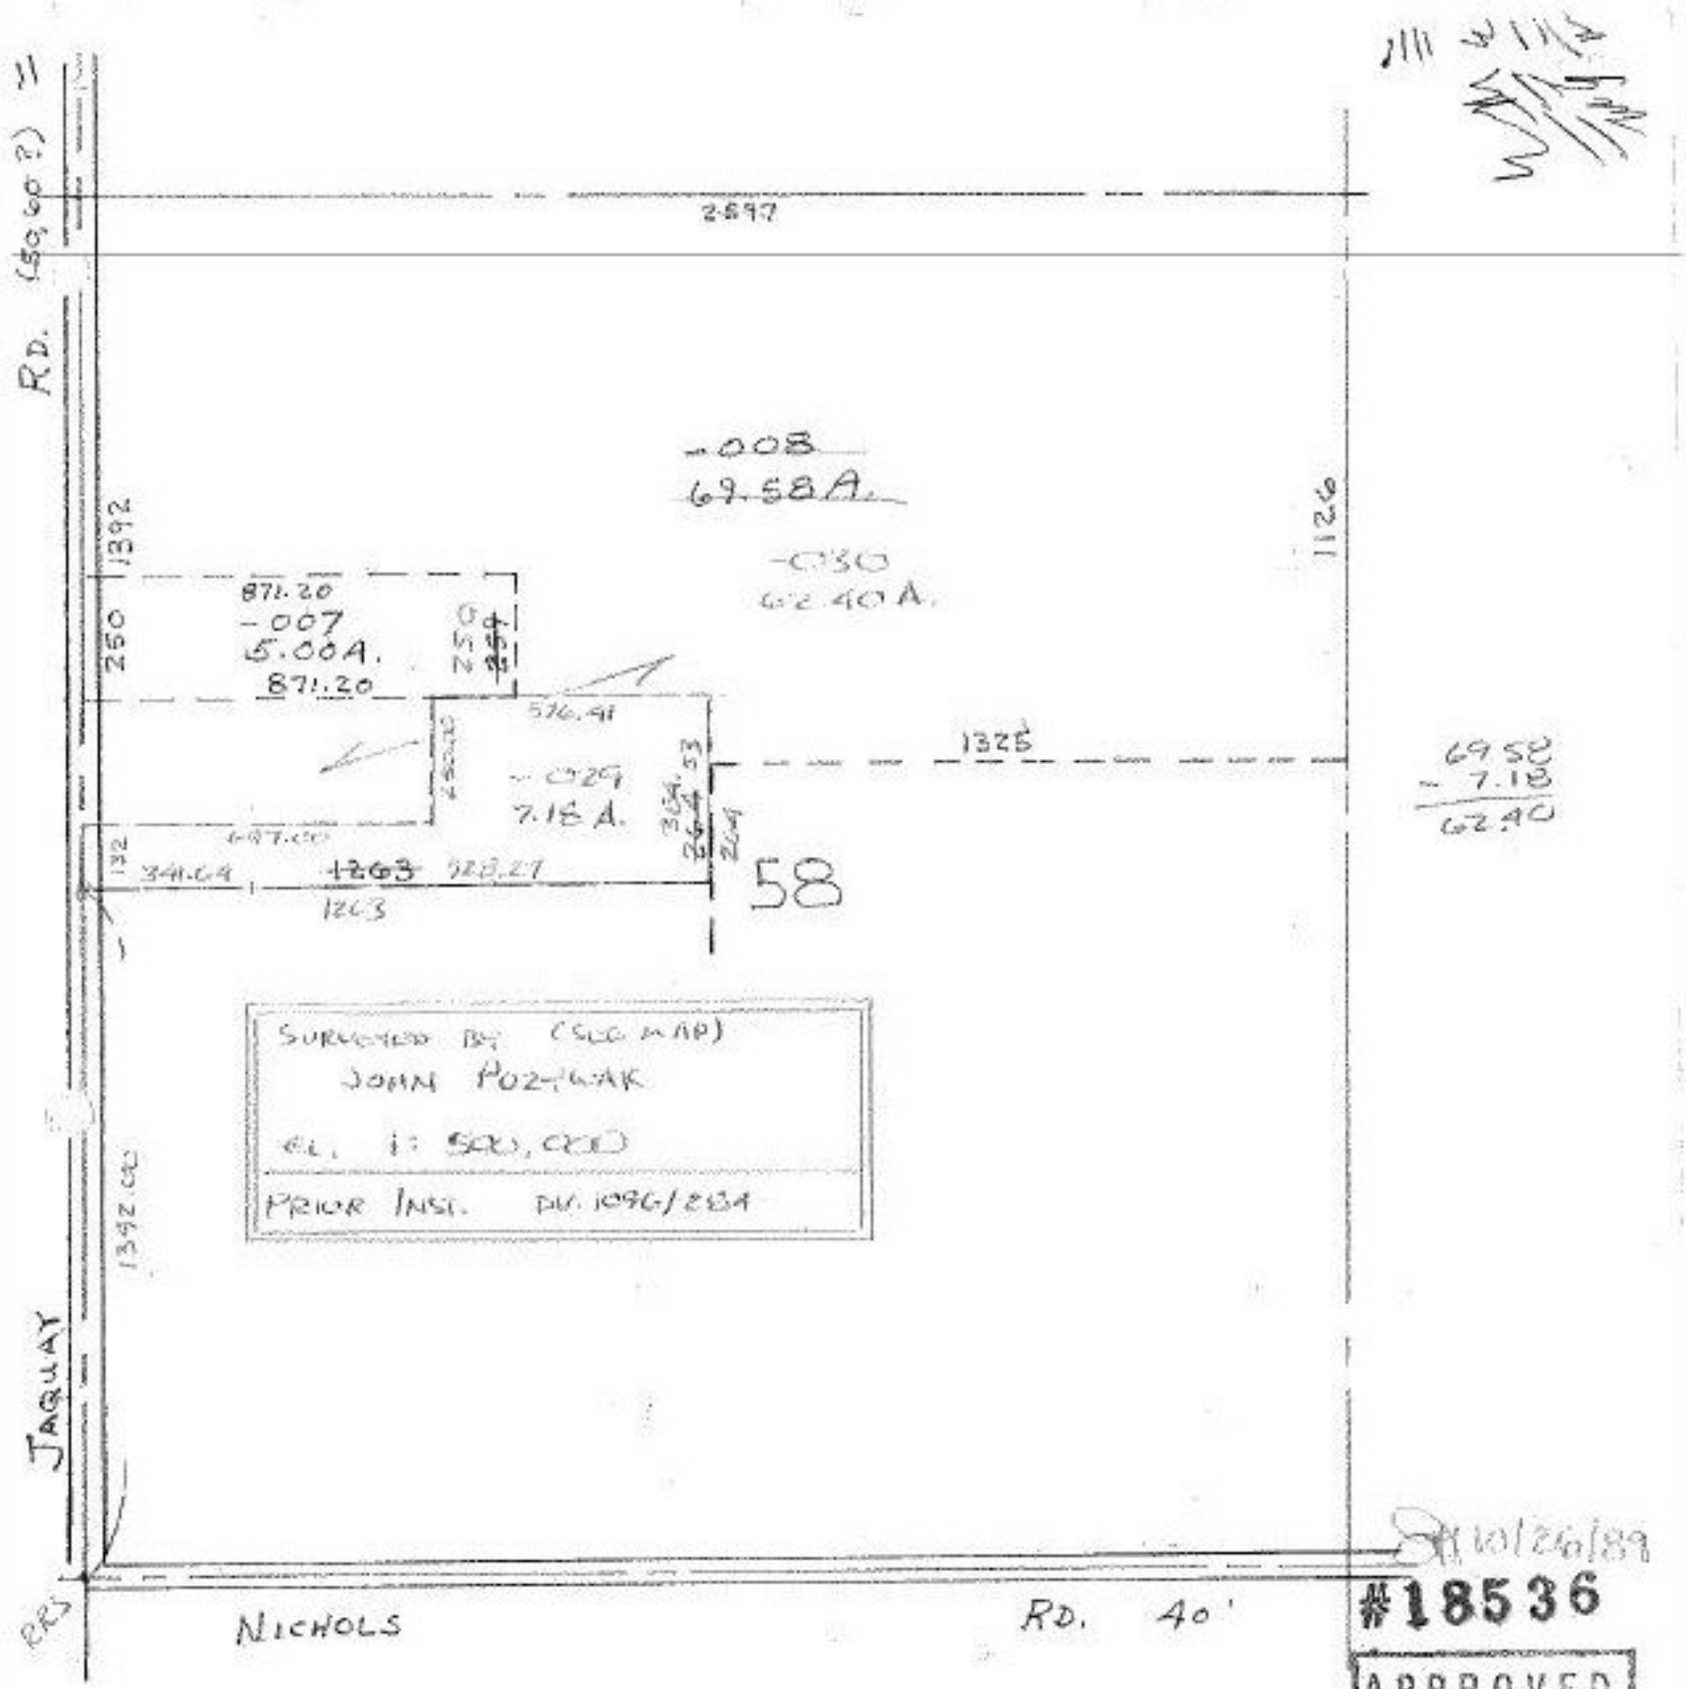

10/26/89

#18536

APPROVED
LORAIN CO.
MAP DEPT.

DATE 7-20-89

PAGE 12-B

BY T. McNair

VOID AFTER 18536

12-B