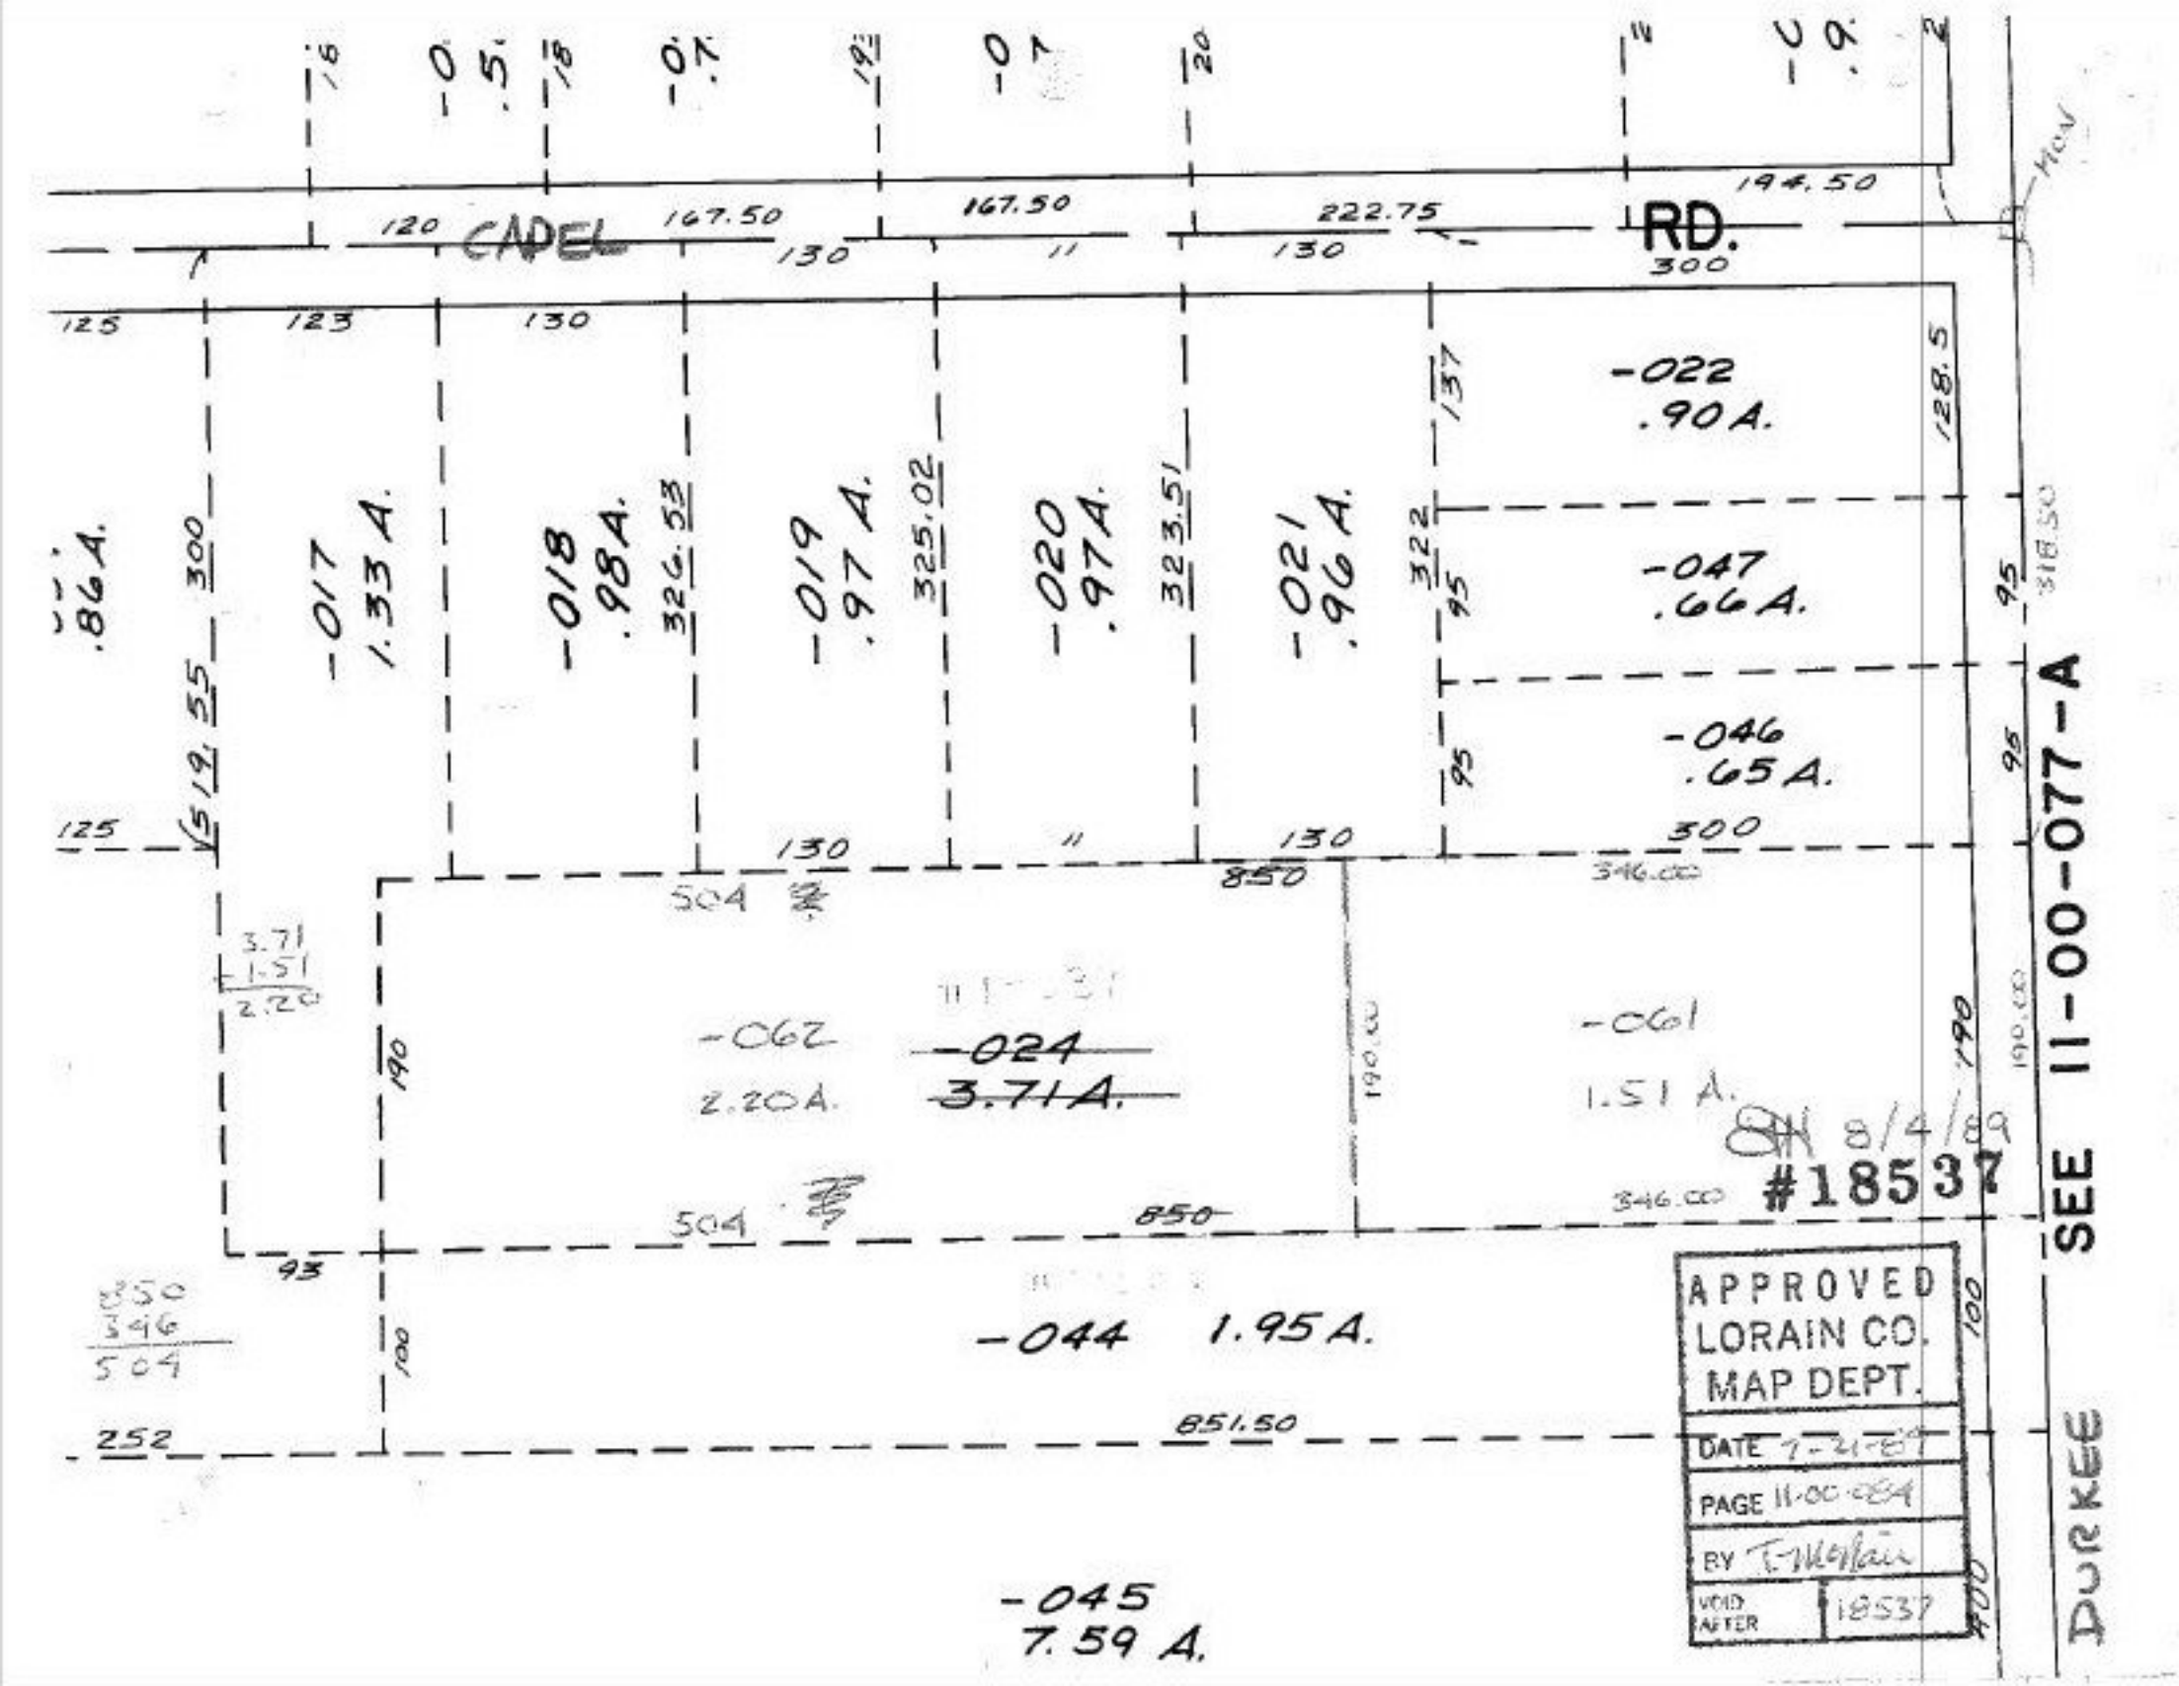

CAPEL
RD.
167.50
167.50
222.75
194.50
-022
.90 A.
-047
.66 A.
-046
.65 A.
-017
1.33 A.
-018
.98 A.
-019
.97 A.
-020
.97 A.
-021
.96 A.
326.53
325.02
323.51
322
300
318.50
-062
2.20 A.
-024
3.71 A.
-061
1.51 A.
8/4/89
#18537
-044 1.95 A.
-045
7.59 A.
851.50
252
850
346.00
190.00
SEE 11-00-077-A
DURKEE
APPROVED
LORAIN CO.
MAP DEPT.
DATE 7-21-89
PAGE 11-00-084
BY
VOID AFTER 18537