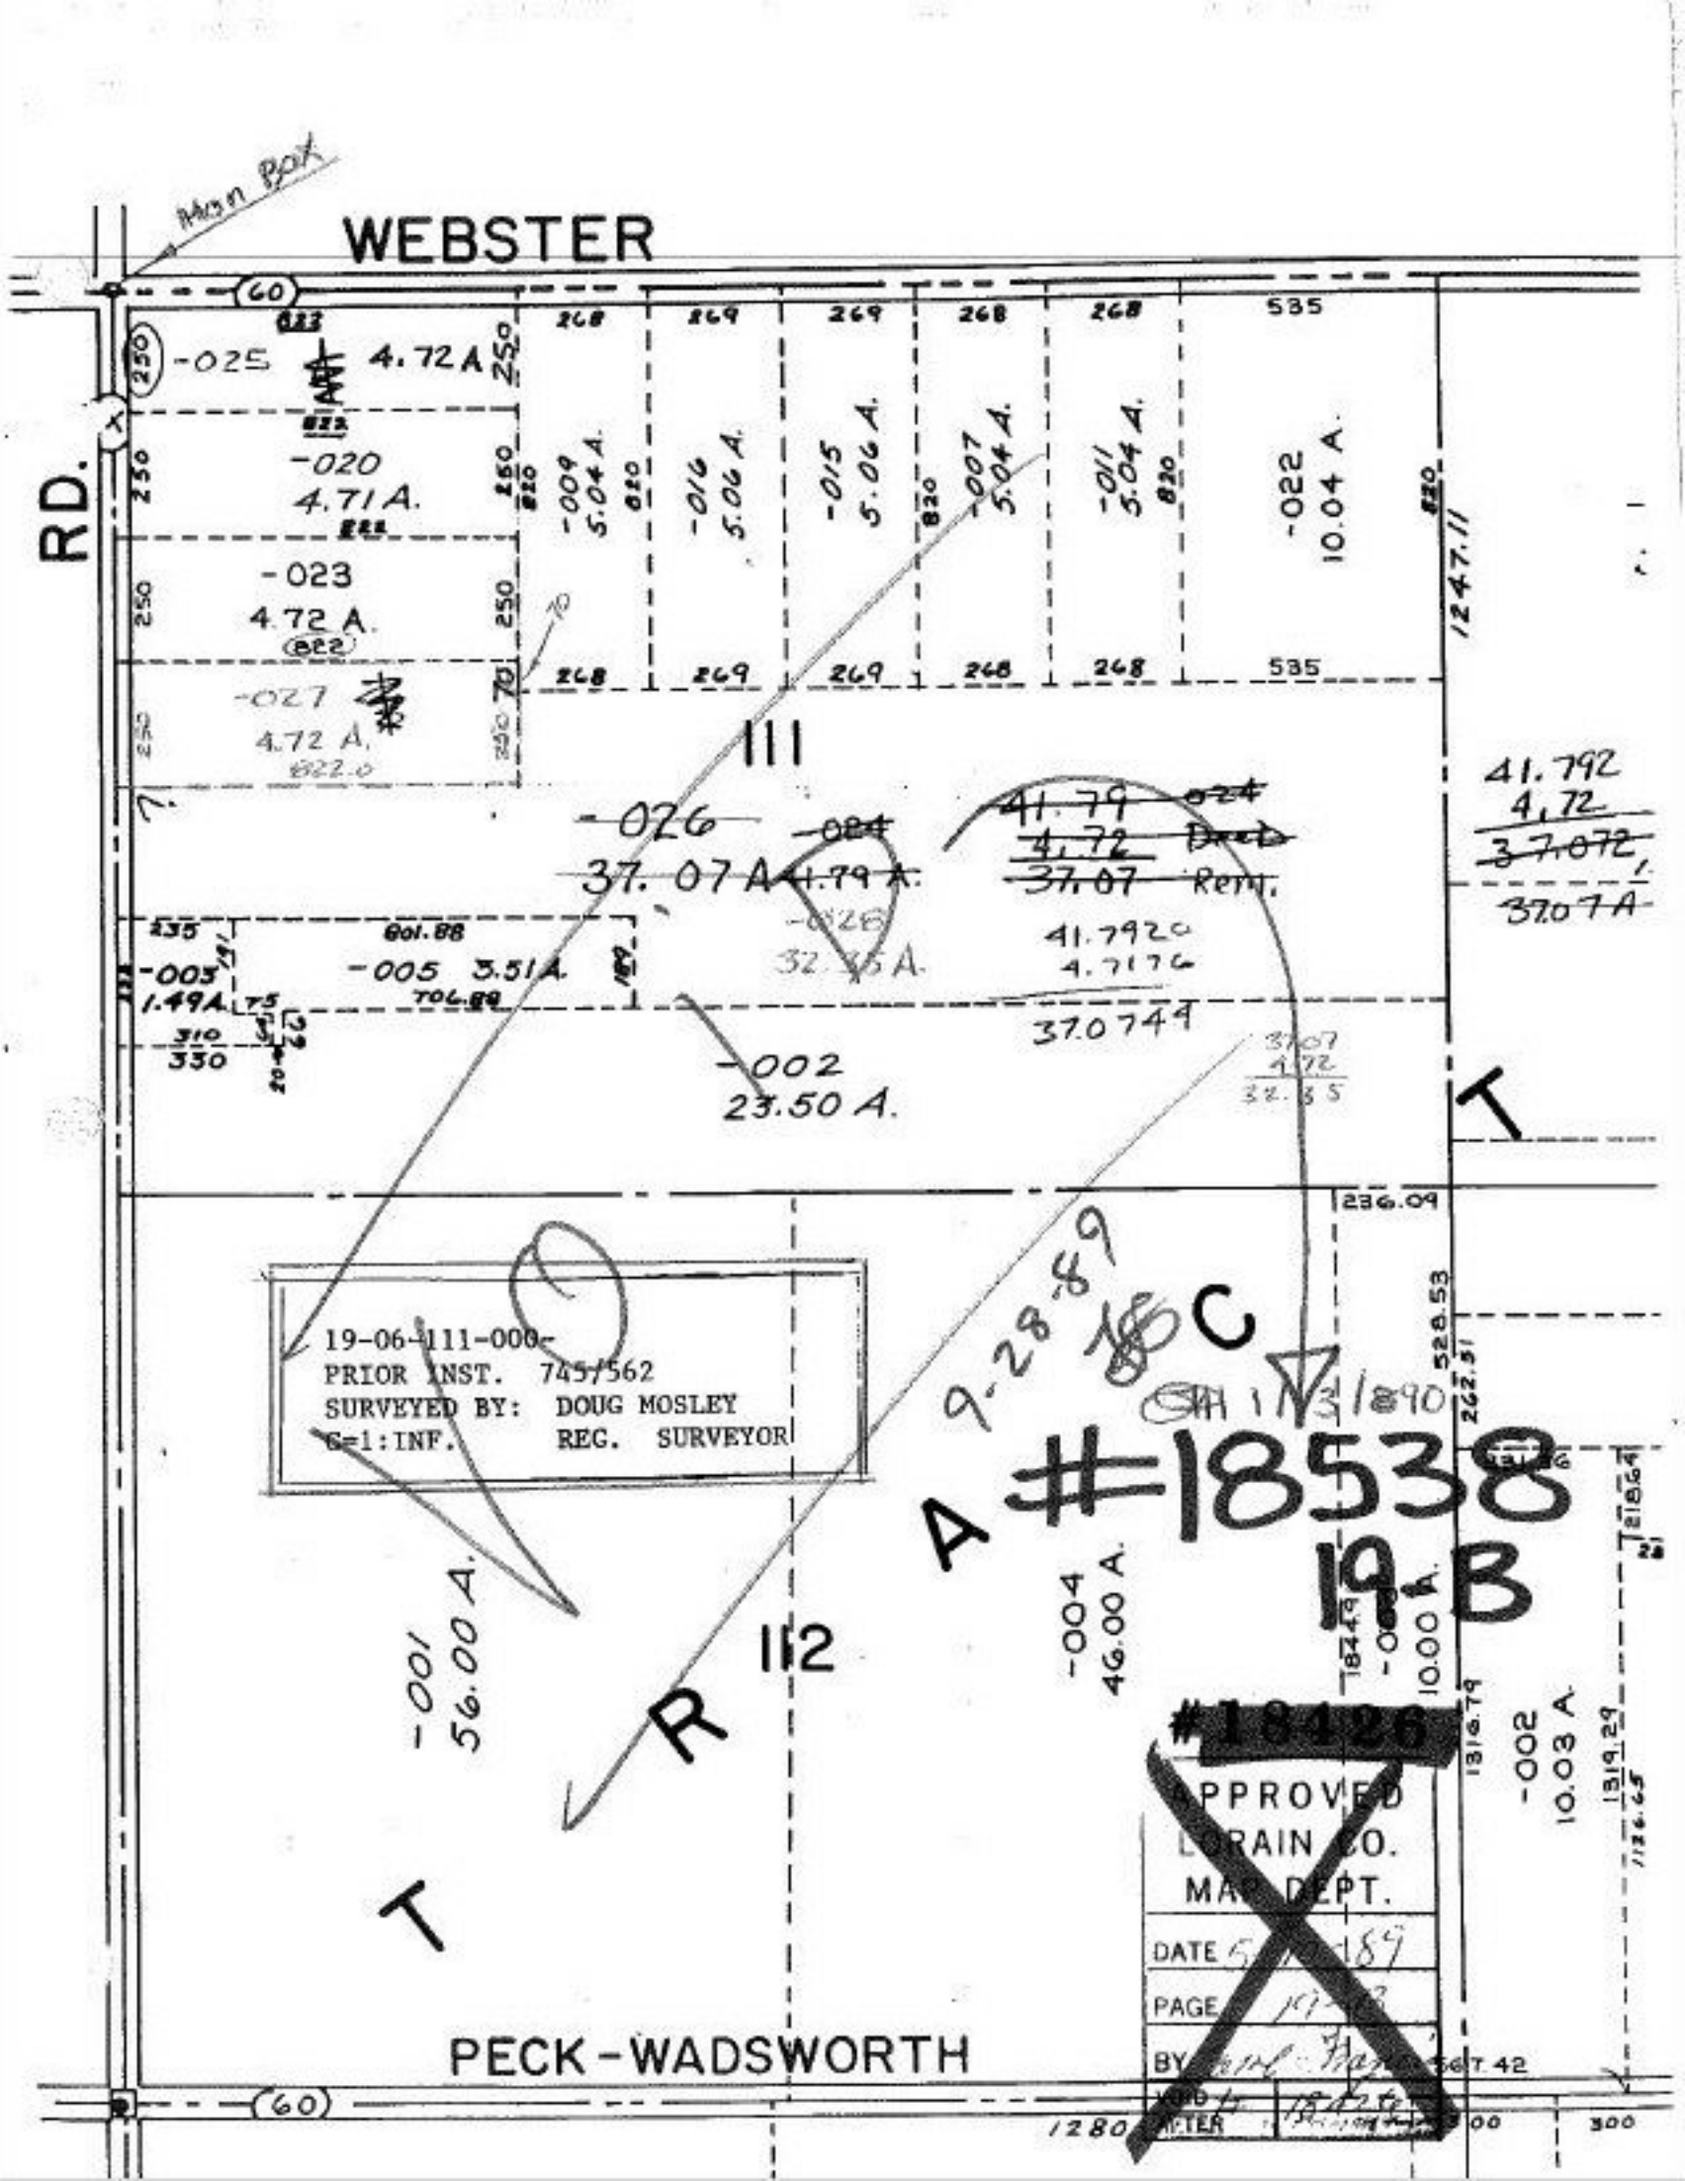
WEBSTER
RD.
PECK-WADSWORTH
Main Post
(60)
-025 4.72A
-020 4.71A.
-023 4.72 A.
-027 4.72 A.
-026 37.07A
-002 23.50 A.
-003 1.49A.
-005 3.51A.
-001 56.00 A.
-004 46.00 A.
-002 10.03 A.
-022 10.04 A.
-011 5.04 A.
-007 5.04 A.
-015 5.06 A.
-016 5.06 A.
-009 5.04 A.
111
112
T
R
41.792
4,72
37.072
37.07A
19-06-111-000-
PRIOR INST. 745/562
SURVEYED BY: DOUG MOSLEY
G=1:INF. REG. SURVEYOR
9.28.89
#18538
19B
#18426
APPROVED
LORAIN CO.
MAP DEPT.
DATE 5-10-89
PAGE 19-3
BY
SHT 42
1247.11
1319.29
1280